



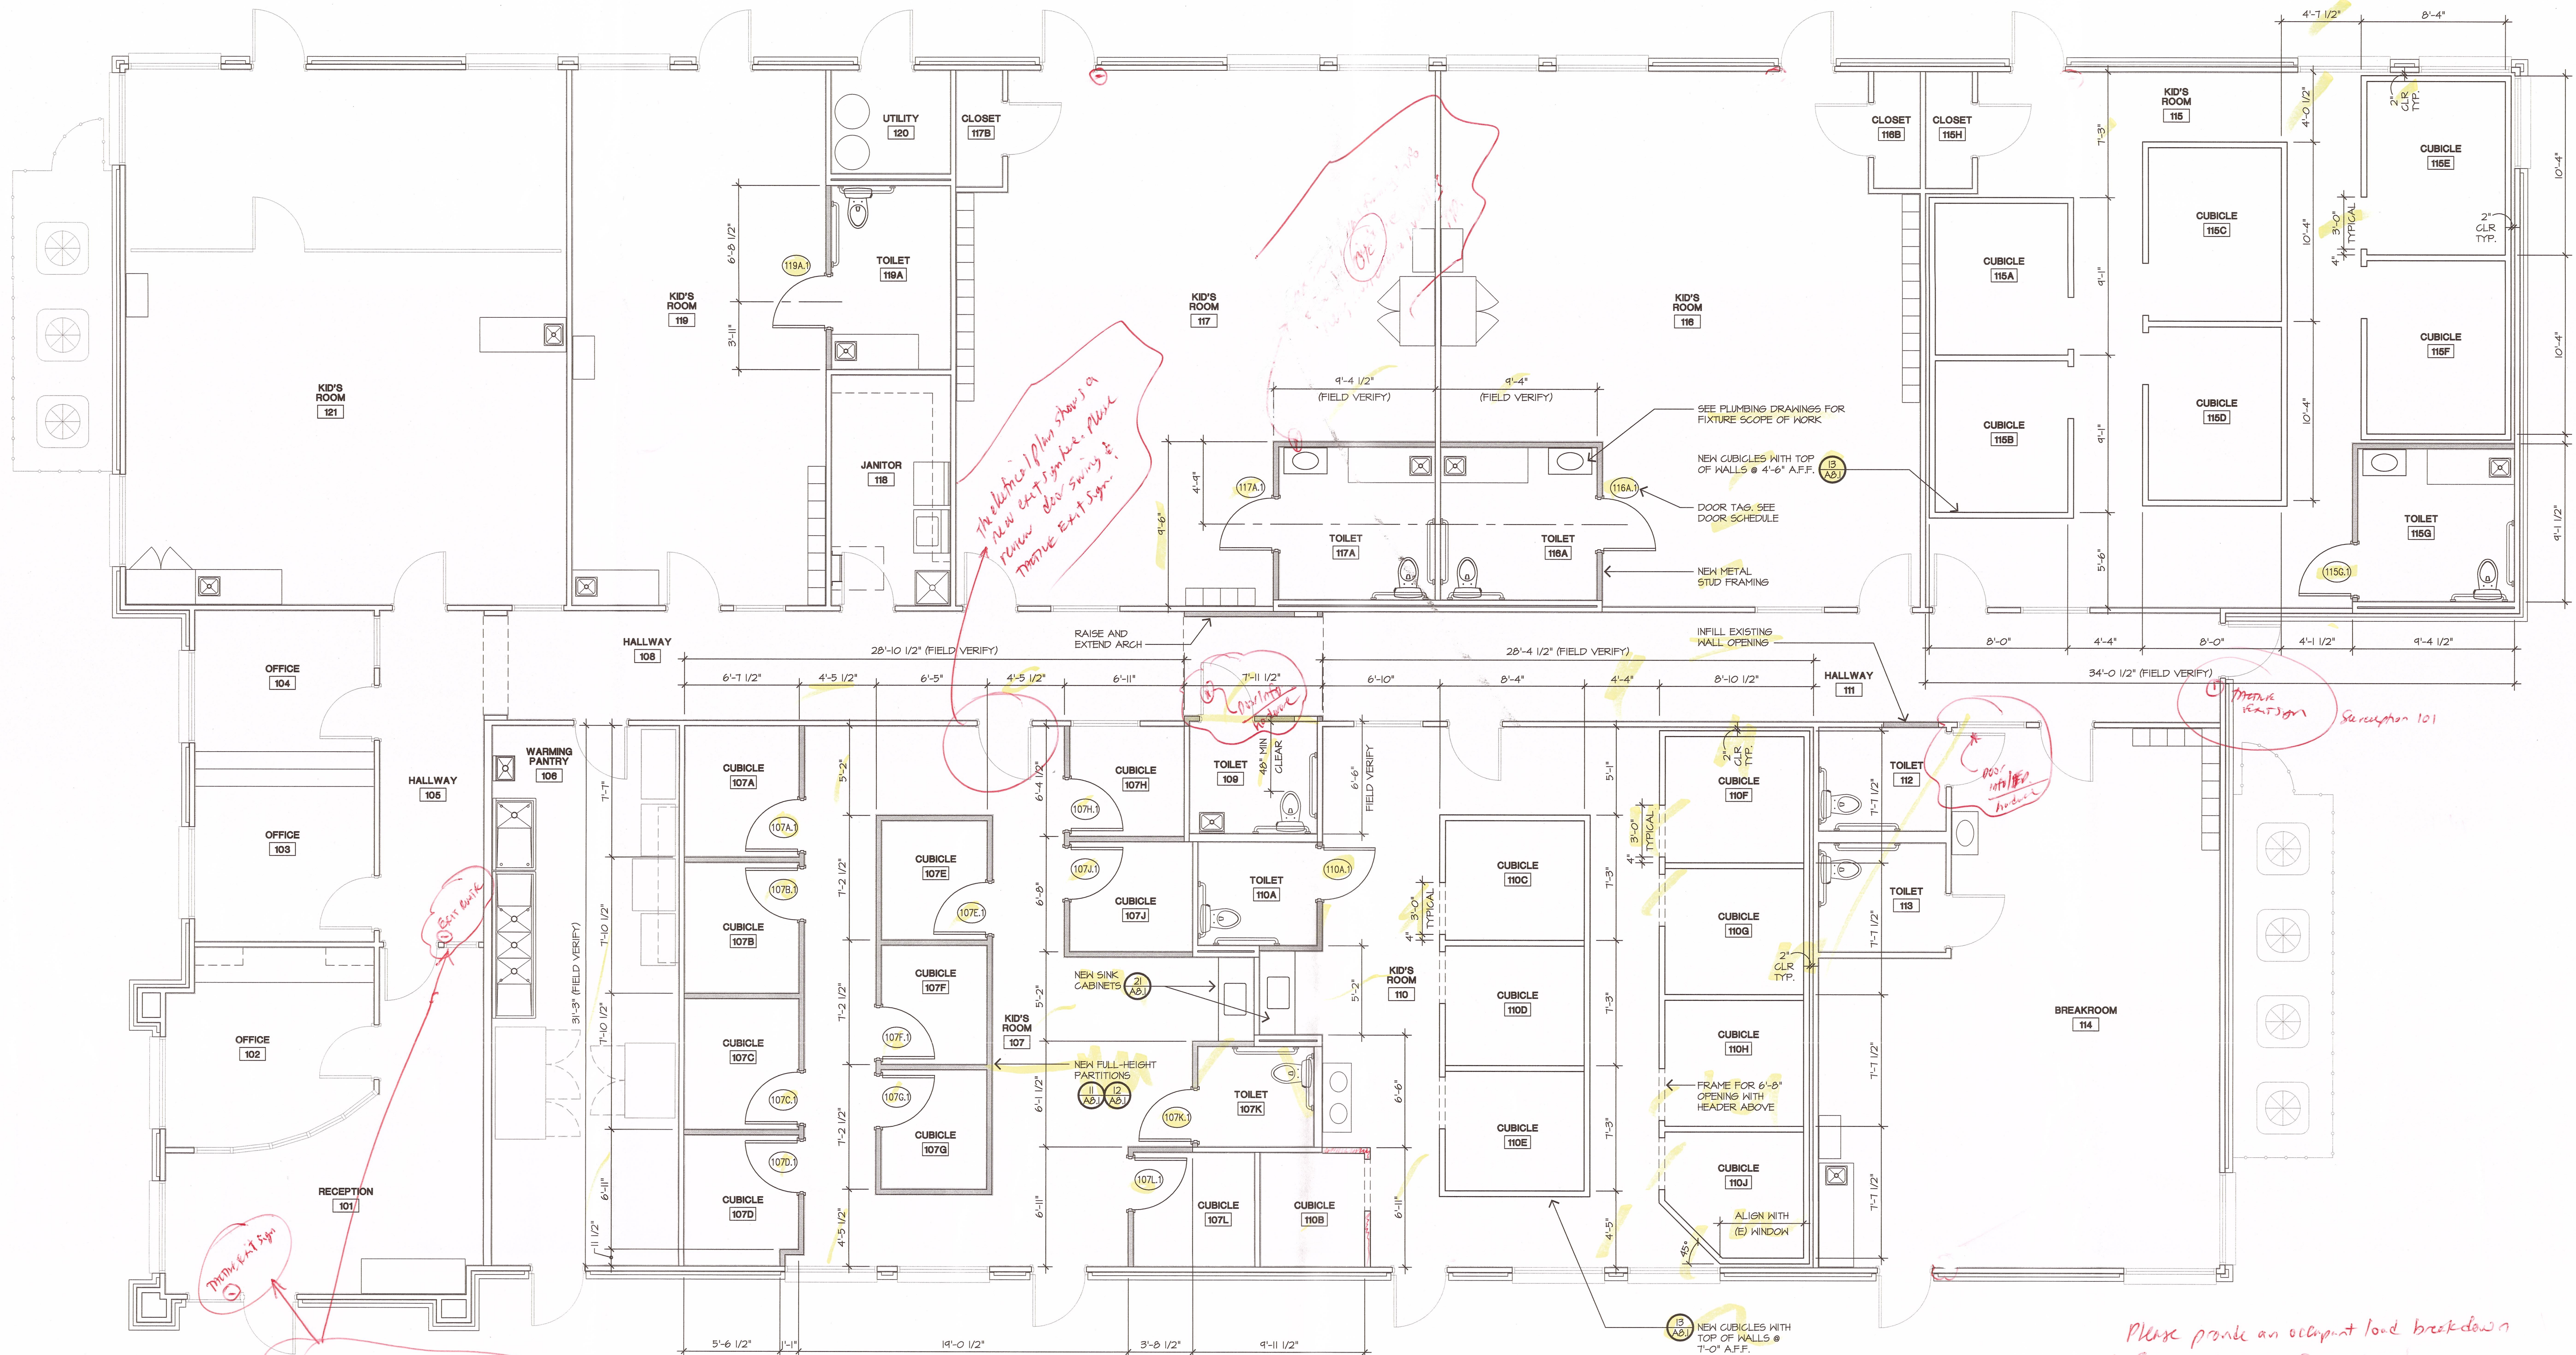

Provide tactile exit signs @ Hallway & reception door exits (3) and any spaces w/ an occ load requiring 2 exit doors. CBC 1011.3
Detail heights & location per CBC 110-103.

Please note: "See sheet A8-1 for Toilet, Lav & Synch accessibility details."

Please provide an occupant load breakdown for the proposed floor plan.
If 2 exits required from space revise existing to comply:
• door swing
• tactile exit sign

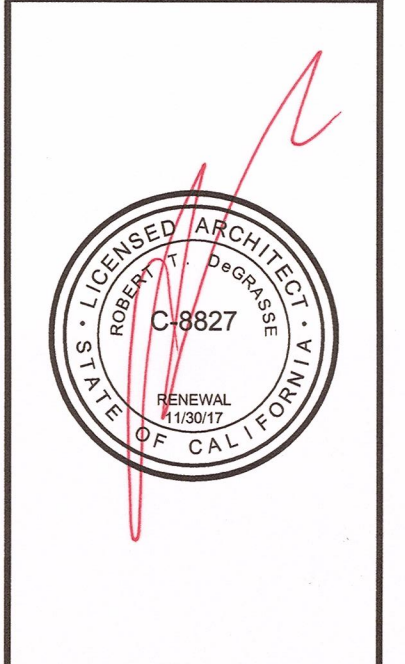

TENANT IMPROVEMENT FOR:
CENTRAL VALLEY AUTISM PROJECT
5501 ANTOINETTE ROSE WAY
RIVERBANK, CA 95367

REVISIONS:	
DRAWN:	K. HADARI
DATE:	01/22/2016
FILE:	226-A12
JOB:	64.206
PRINT DATE:	

PROPOSED FLOOR PLAN