


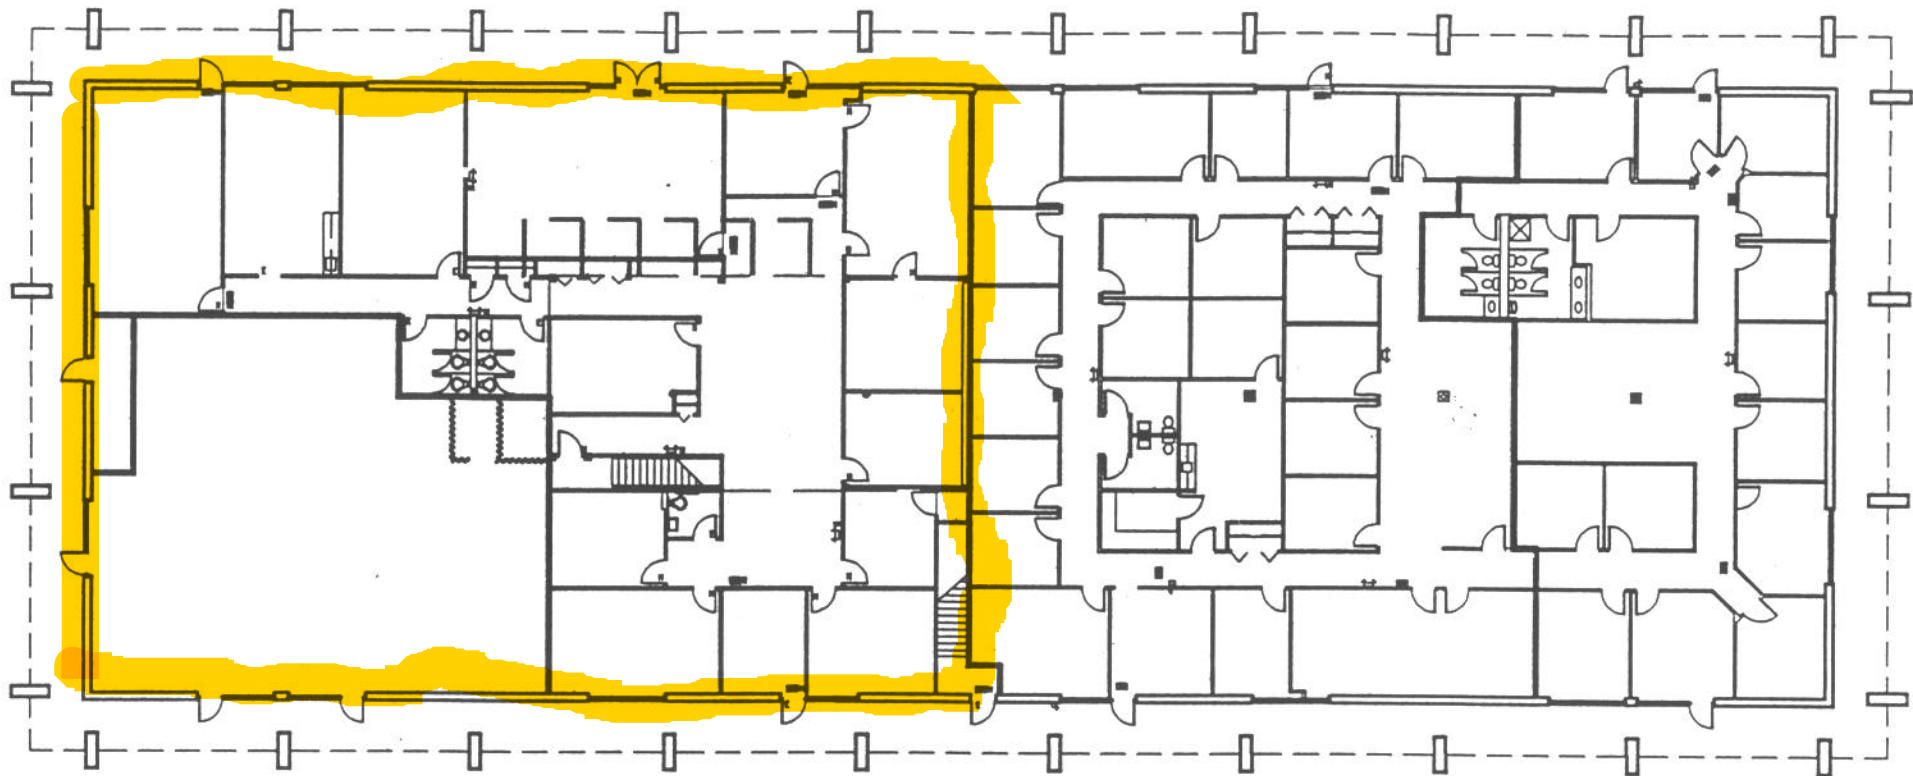

MASONS
MILL
BUSINESS PARK

WOODMOUNT PROPERTIES

1202 Masons Mill Business Park
1800 Byberry Road
Huntington Valley, Pa. 19006
(215) 938-8888 Facsimile (215) 938-7488

AS-BUILT BUILDING 14

DATE:
2-17-99

DRAWN BY:
HEM

DWG. NO.
AB-14

Cathers & Associates, Inc.

65 Valley Stream Parkway Suite 260
Malvern, Pennsylvania 19355
610.647.0986 FAX 610.647.0154

