



Vectorworks Educational Version **~~~~** ~~~ ~~~~ ~~~ www. Kent State Department of Theatre and Dance URINETOWN Date: 12/2/2022 **GROUND PLAN** СL Scale : Sheet Scale E. Turner Stump Theatre Director : Danny George GROUND PLAN
Scale: 1/8" = 1'-0" Designer : Andrea Ball & Clarie Voght OF Technical Director: John Rawlings 16 Assist TD : Jordan Campbell KENT/STATE. Revisions: 2/22/2023

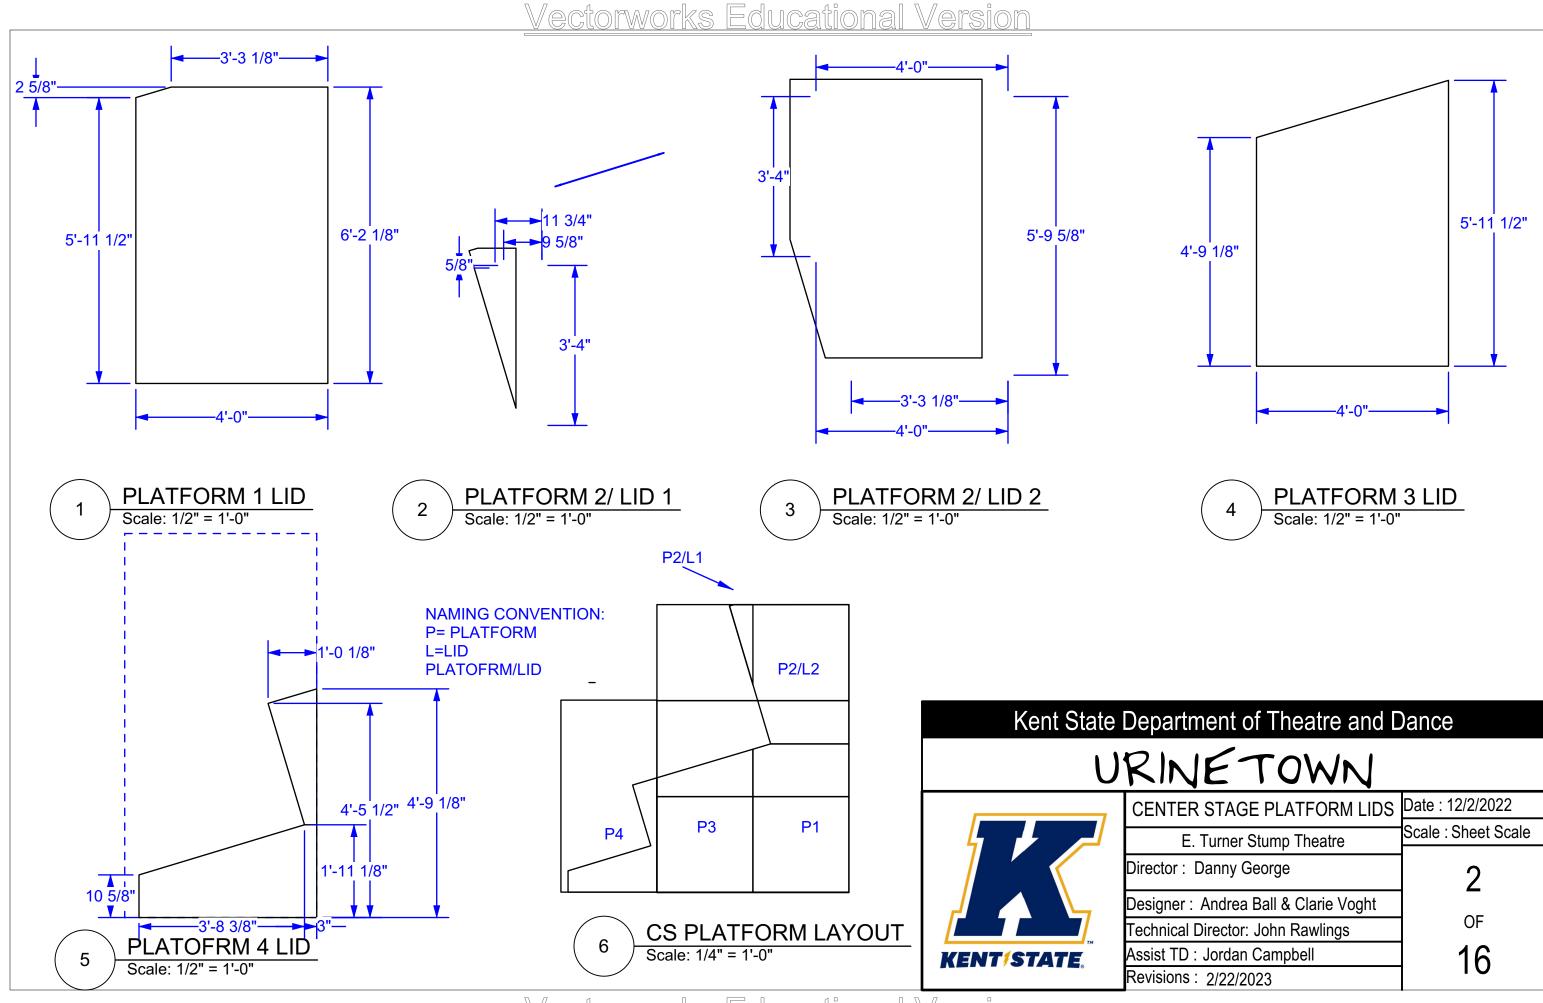


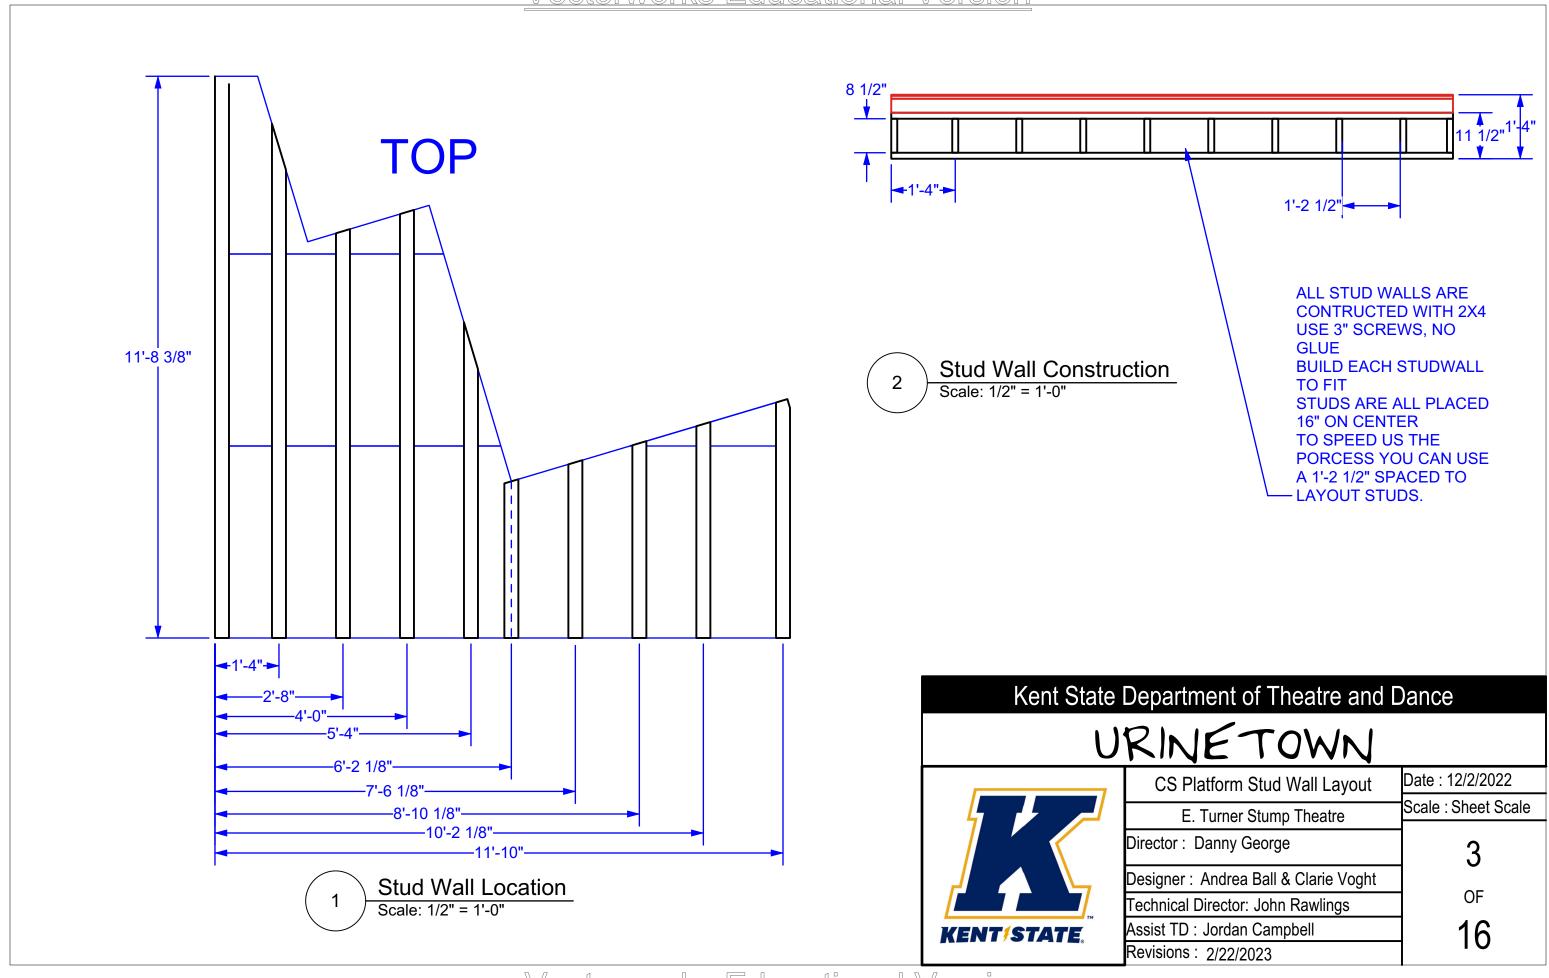

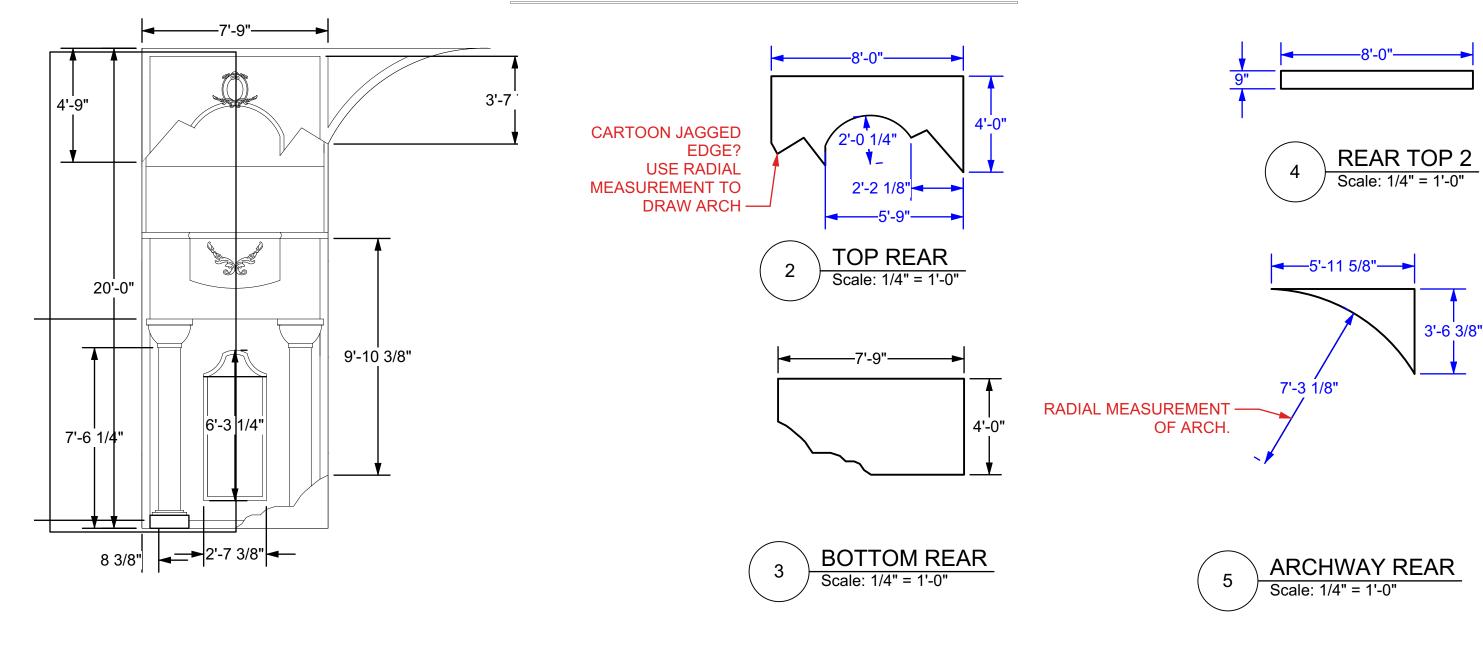

1 FRONT VIEW
Scale: 1/4" = 1'-0"

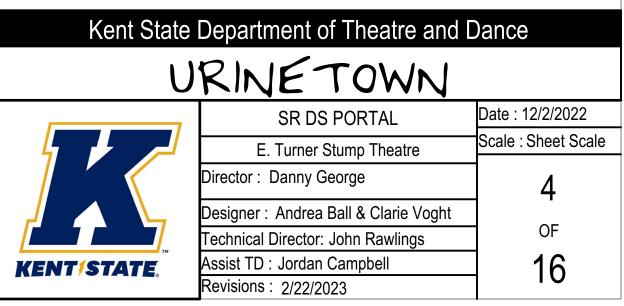

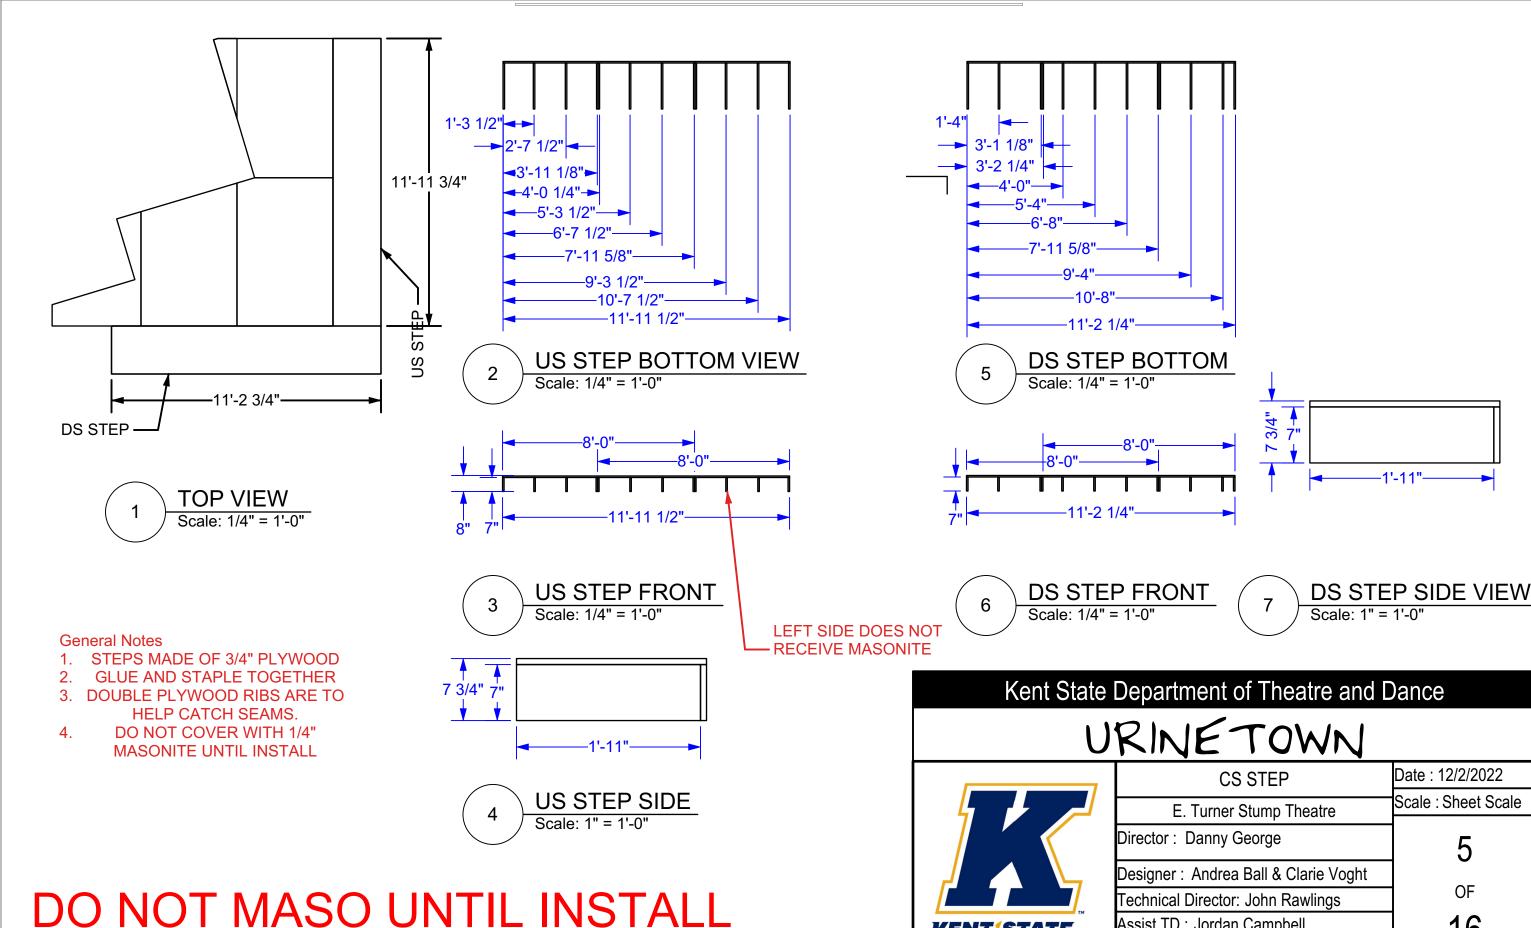

Vectorworks Educational Version

Date: 12/2/2022

Scale: Sheet Scale

5


OF

16

Assist TD : Jordan Campbell

Revisions: 2/22/2023

KENT STATE

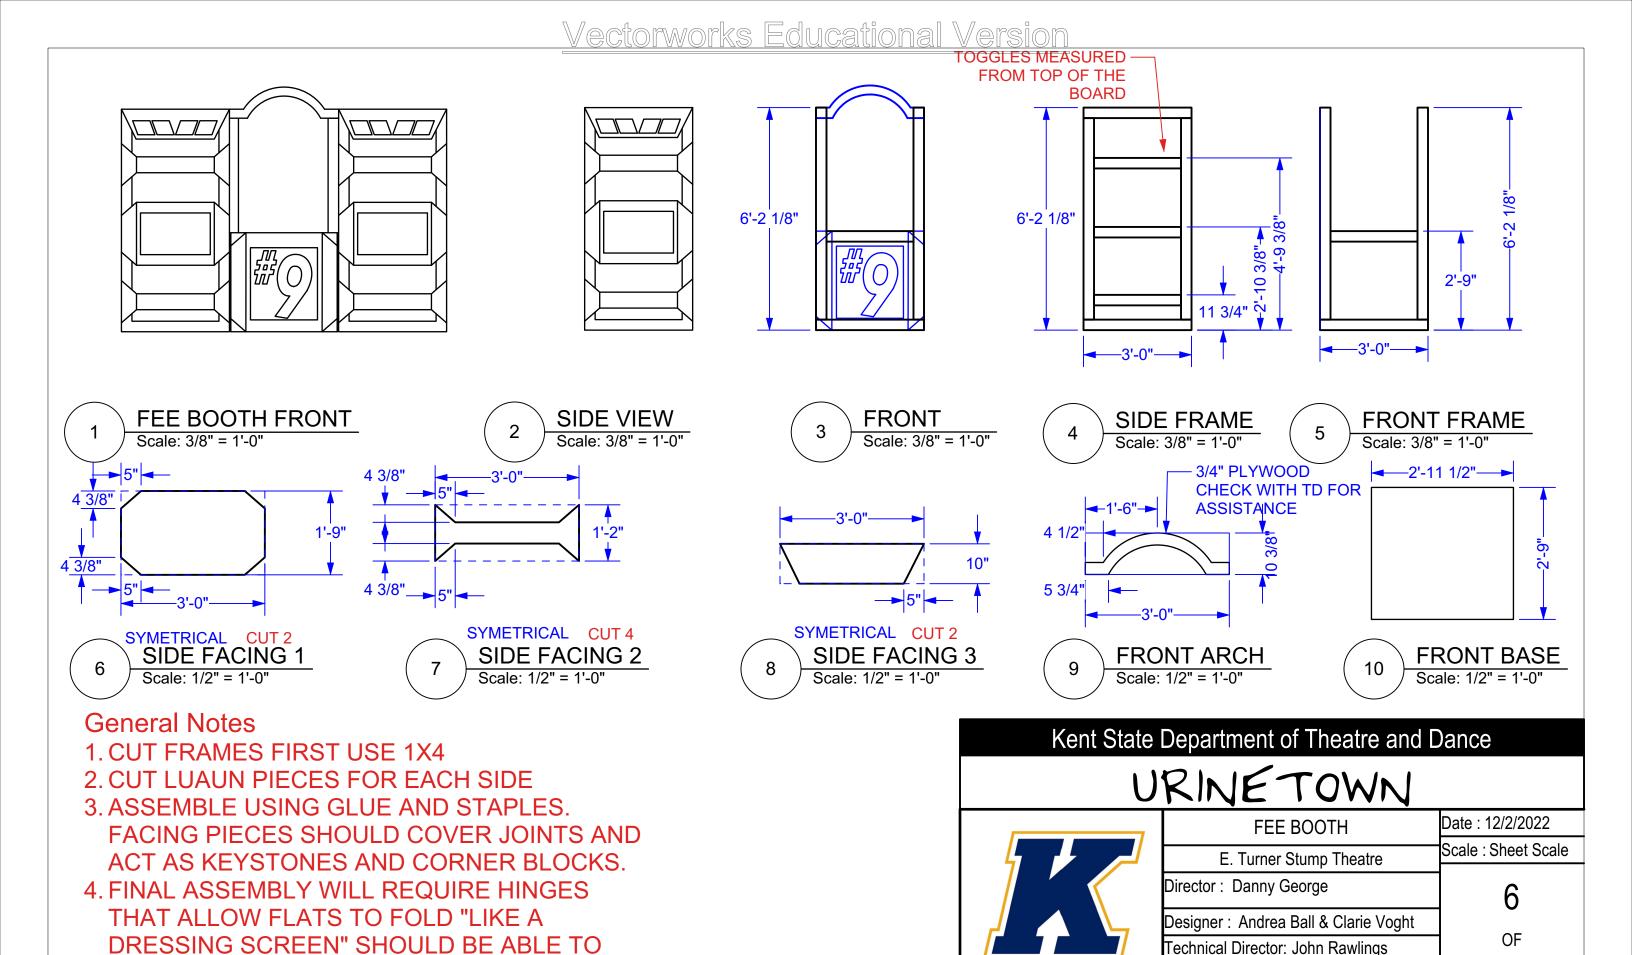


16


Assist TD : Jordan Campbell

Revisions: 2/22/2023


KENT STATE

FOLD LIKE A "Z" AND A "U"

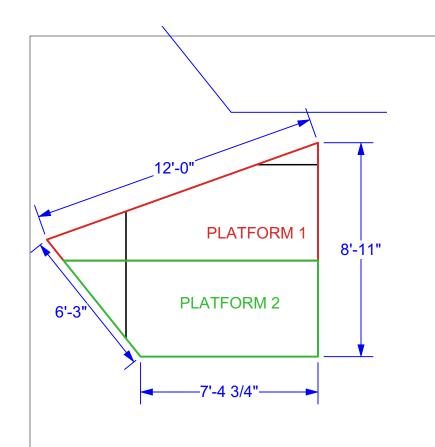


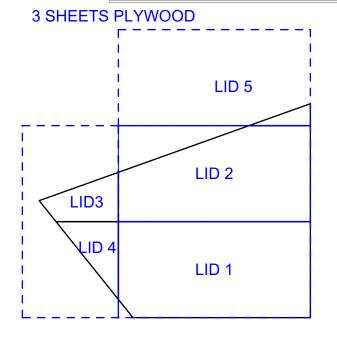



PLATORM 1= LIDS 2,3,5 PLATFORM 2= LIDS 1,4

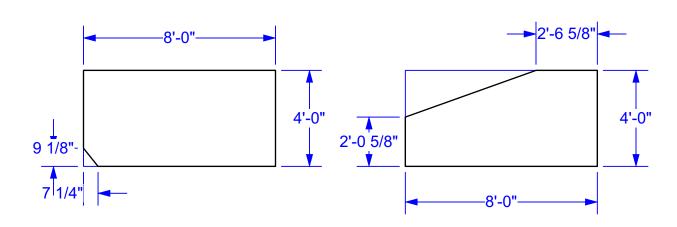





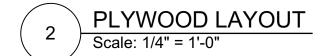


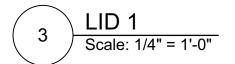


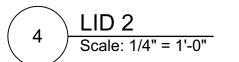


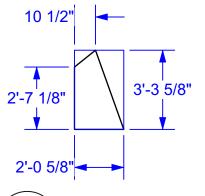


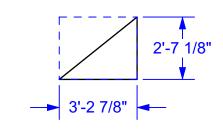

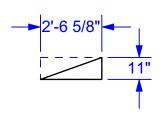

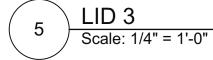

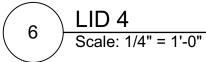


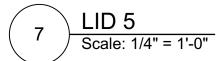

General Notes

- 1. CUT AND LABEL PLYWOOD LIDS MAKE SURE TO LABEL TOPS
- 2. FRAME TO FIT.


Kent State Department of Theatre and Dance URINETOWN CS TOWER LIDS E. Turner Stump Theatre Director: Danny George Designer: Andrea Ball & Clarie Voght Technical Director: John Rawlings Assist TD: Jordan Campbell Revisions: 2/22/2023

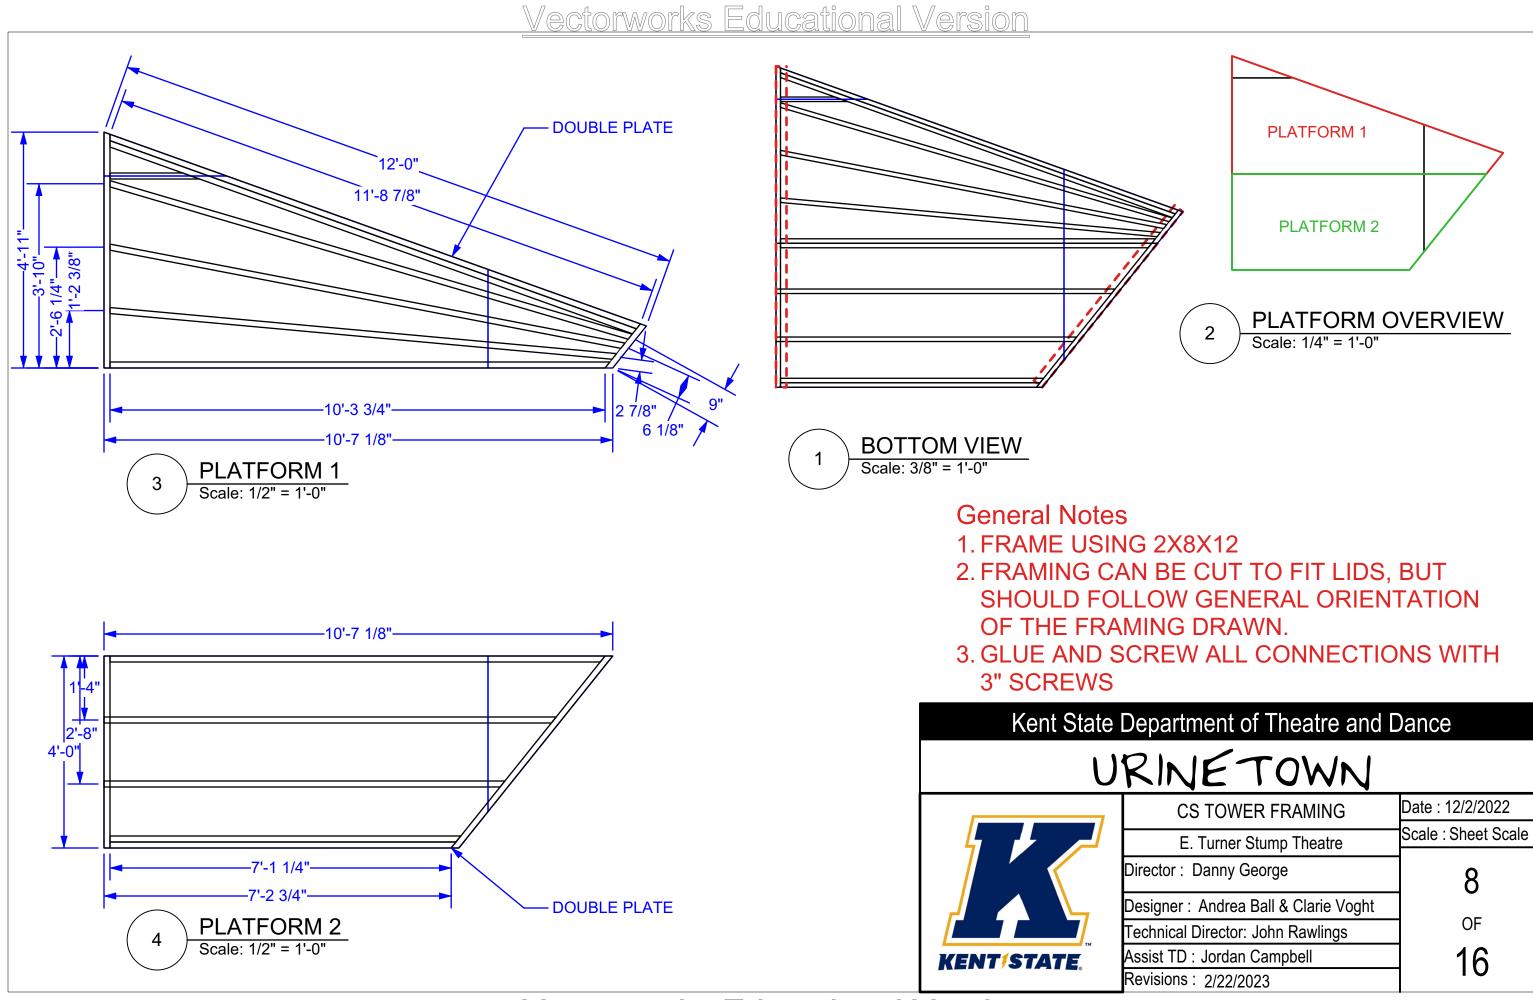


Vectorworks Educational Version **DOUBLE PLATE DOUBLE PLATE** - DRAWING 4 **DRAWING 2 TOP VIEW STUDWALLS** Scale: 1/4" = 1'-0" -6'-5 3/4' -8'-11" **CUT PLATES TO MATCH FRAME** MARK TOGGLE LOCATIONS ON PLATES, STUDS **SR STUDWALL** FRONT STUDWALL 2 SHOULD MATCH TOGGLE LOCATIONS. Scale: 1/2" = 1'-0" Scale: 1/2" = 1'-0" -6'-5 3/4"· ППППП SR STUD WALL TOP STUDWALL 2 TOP Scale: 1/2" = 1'-0" Scale: 1/2" = 1'-0" Kent State Department of Theatre and Dance URINETOWN **General Notes** Date: 12/2/2022 CS STAGE TOWER STUD WALLS 1. STUDS SHOULD LINE UP WITH E. Turner Stump Theatre TOGGLES. THAT SHOULD PUT THEM Director: Danny George 9 **ROUGHLY 16" ON CENTER.**


- 2.3" SCREWS/ NO GLUE
- 3. CROSS BRACE WITH SCRAP 1X4 AFTER **COMPLETE**

Scale: Sheet Scale Designer : Andrea Ball & Clarie Voght OF Technical Director: John Rawlings 16 Assist TD : Jordan Campbell KENT STATE Revisions: 2/22/2023

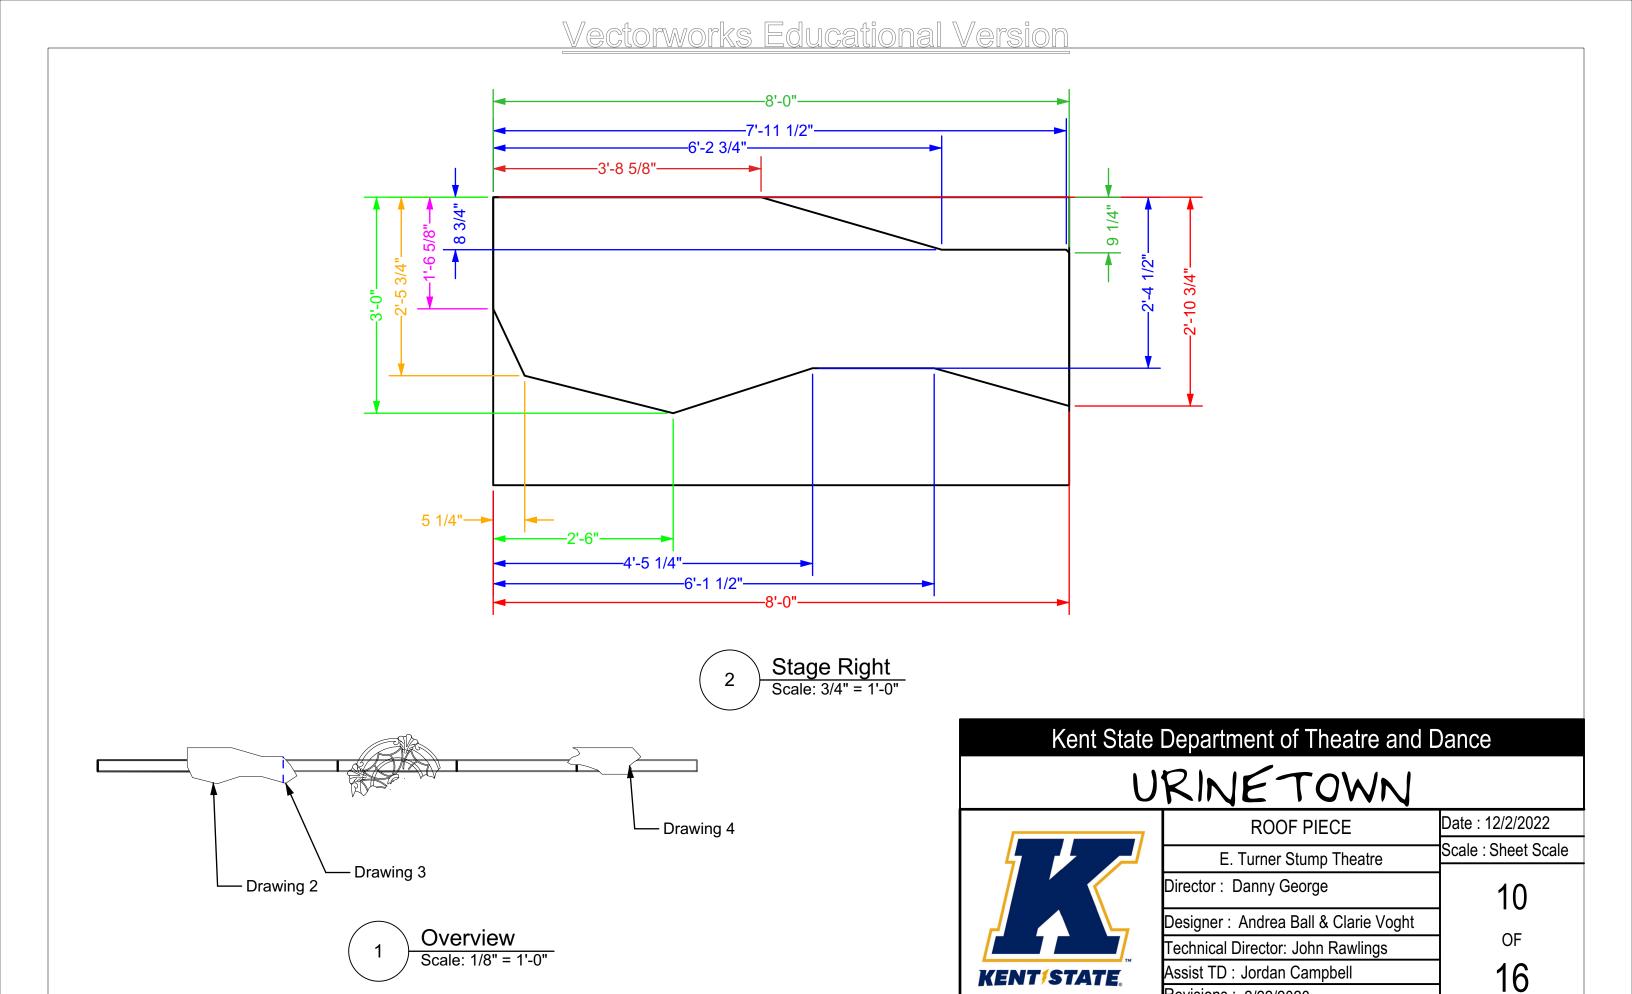


Revisions: 2/22/2023

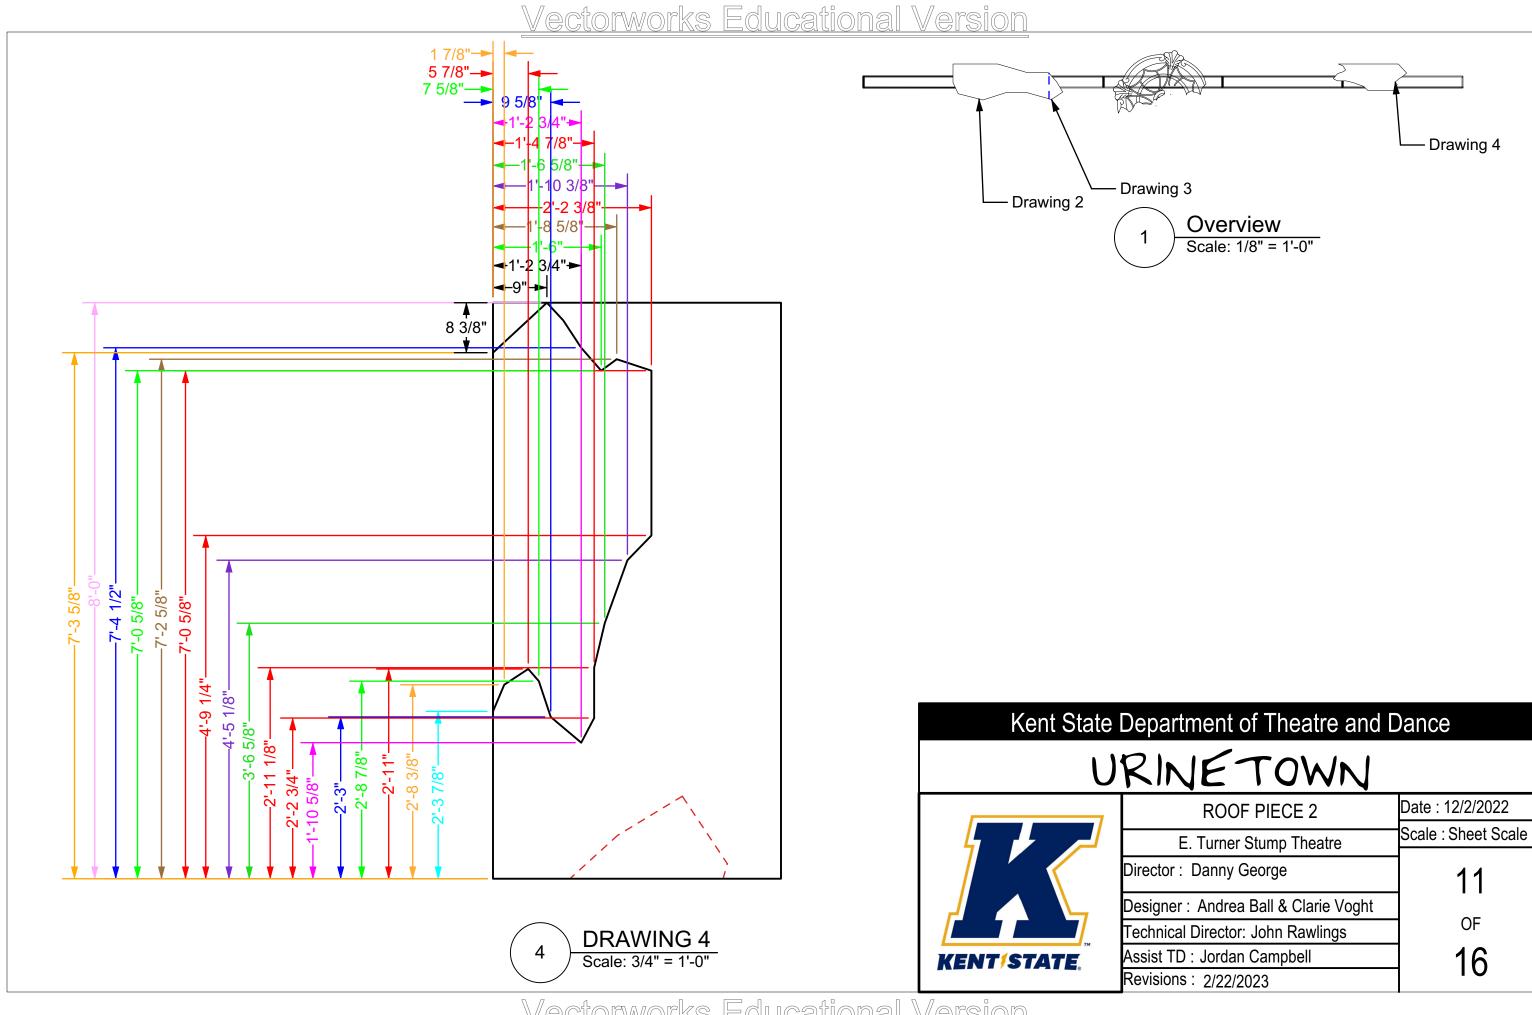


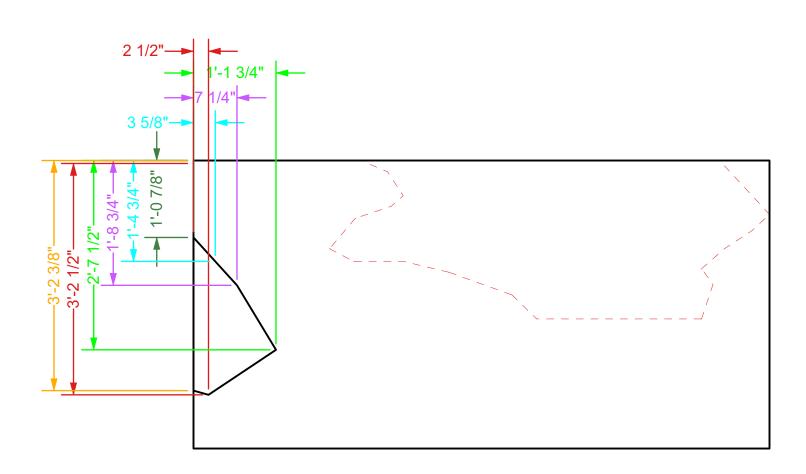





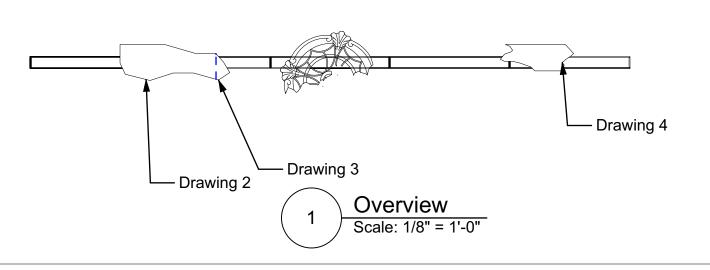

Kent State Department of Theatre and Dance			
URINETOWN			
	ROOF PIECE 3	Date : 12/2/2022	
	E. Turner Stump Theatre	Scale : Sheet Scale	
	Director : Danny George	12	
	Designer : Andrea Ball & Clarie Voght] '-	
	Technical Director: John Rawlings	OF	
KENT/STATE.	Assist TD : Jordan Campbell	16	
	Revisions: 2/22/2023		

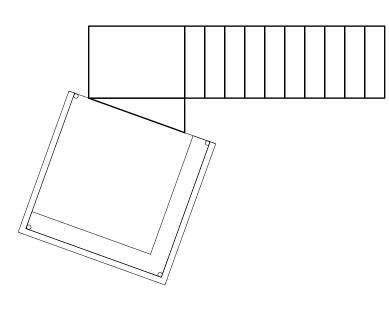


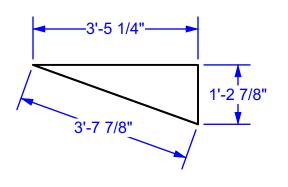

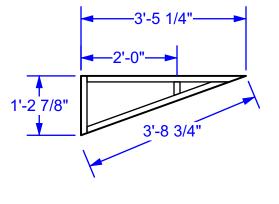

OVERVIEW
Scale: 1/4" = 1'-0"


TOP
Scale: 1/2" = 1'-0"

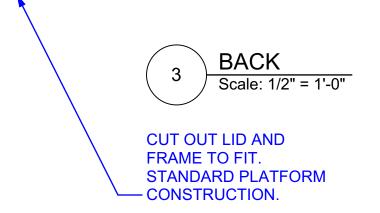


NOTES:

- 1. CUT LID, FRAME TO FIT.
- 2. STANDARD PLATFORM CONSTRUCTION

Kent State Department of Theatre and Dance URINETOWN ESCAPE STAIR PLATFORM E. Turner Stump Theatre Director: Danny George Director: Danny George Designer: Andrea Ball & Clarie Voght Technical Director: John Rawlings Assist TD: Jordan Campbell Revisions: 2/22/2023

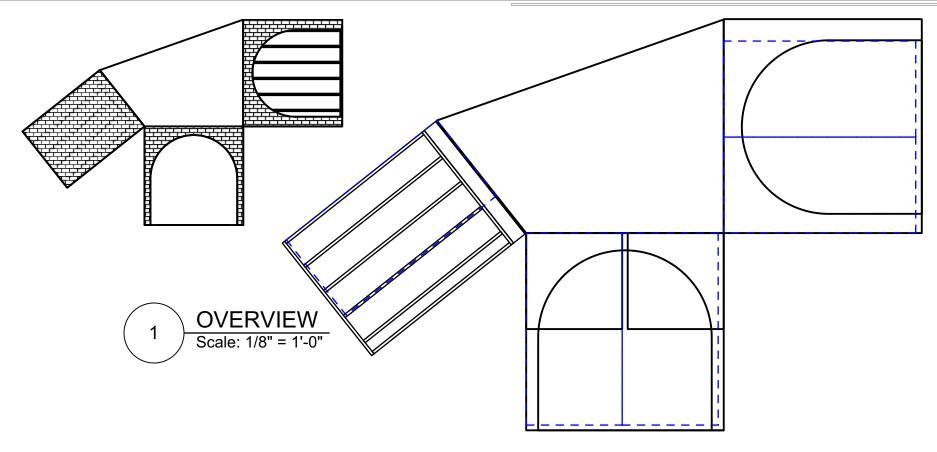

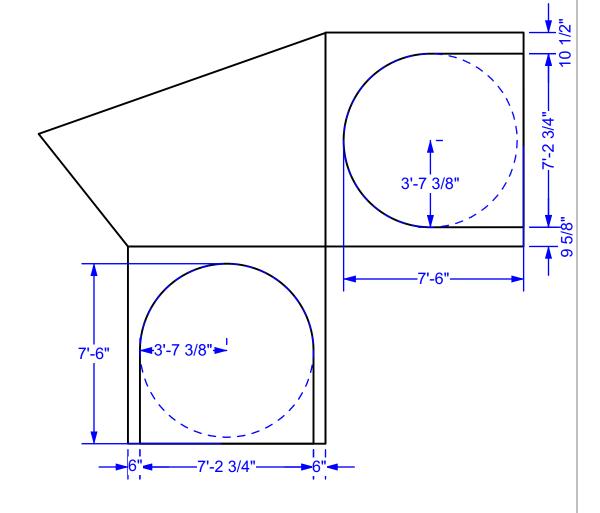



SHEET GOOD LAYOUT
Scale: 1/4" = 1'-0"


3 ARCHWAY MEASUREMENTS
Scale: 1/4" = 1'-0"

LAYOUT BRICK BOARD FROM SL TO SR
DS FACE SHOULD RECIEVE 3/4 PLYWOOD SHEETHING
BRICK SHOULD LINE UP TO TOP OF PLATFORM
USE RADIAL MEQASUREMENT PROVIDED TO LAYOUT ARCHWAYS

Kent State Department of Theatre and Dance URINETOWN BRICK WALL LAYOUT E. Turner Stump Theatre Director: Danny George Director: Danny George Designer: Andrea Ball & Clarie Voght Technical Director: John Rawlings Assist TD: Jordan Campbell Revisions: 2/22/2023

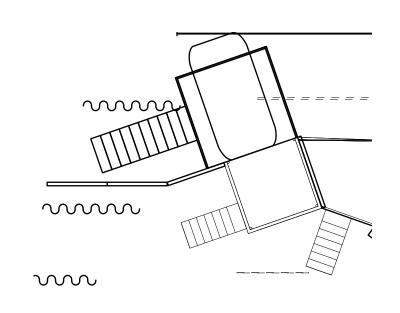


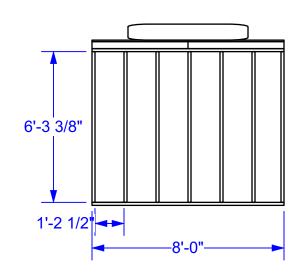

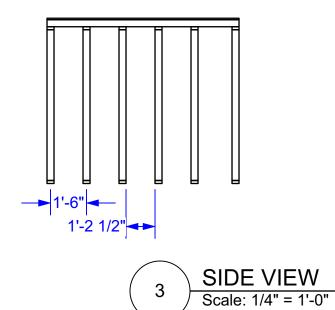


1 OVERVIEW
Scale: 1/8" = 1'-0"

2 FRONT VIEW
Scale: 1/4" = 1'-0"

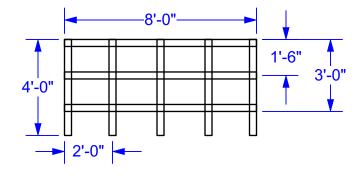



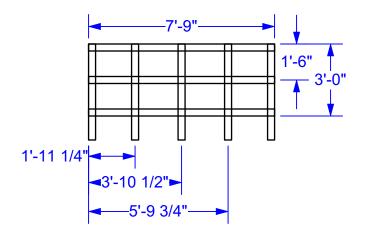


5 RAILING 2
Scale: 1/4" = 1'-0"


Kent State Department of Theatre and Dance

URINETOWN




JINIL I OVAIL			
,	CRASH PAD PLATFORM	Date : 12/2/2022	
/	E. Turner Stump Theatre	Scale : Sheet Scale	
	Director : Danny George	15	
	Designer : Andrea Ball & Clarie Voght	. •	
	Technical Director: John Rawlings	OF	
	Assist TD : Jordan Campbell	16	
	Revisions: 2/22/2023		

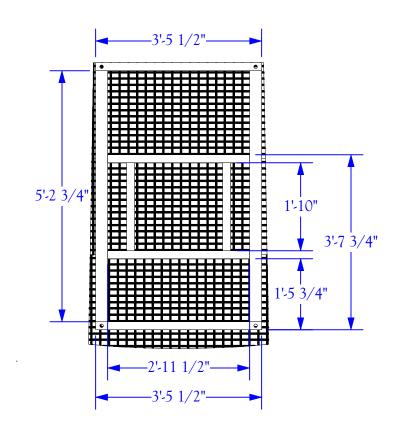

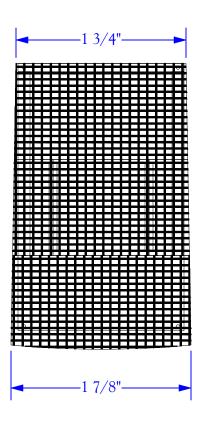





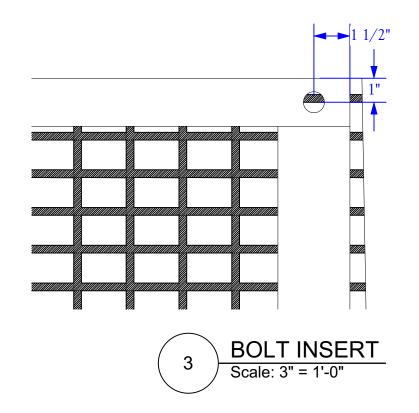

General Notes

- ALL JOINTS ARE WELDED
- 2. LONG SPANS ARE 3"X3" BOX TUBE
- 3. SHORT SPANS ARE 2"X3" BOX TUBE
- 4. TRAP WILL BE CUT AND REMOVED WHILE THE REST OF THE GRATE IS WELDED TO THE FRAME.
- 5. USE CRAFT PAPER TO CREATE TEMPLATE FOR TOP SO IT MATCHES CURVED STAGE EDGE

Kent State Department of Theatre and Dance URINETOWN GRATE PLUG E. Turner Stump Theatre Director: Danny George Designer: Andrea Ball & Clarie Voght Technical Director: John Rawlings Assist TD: Jordan Campbell Revisions: 2/22/2023