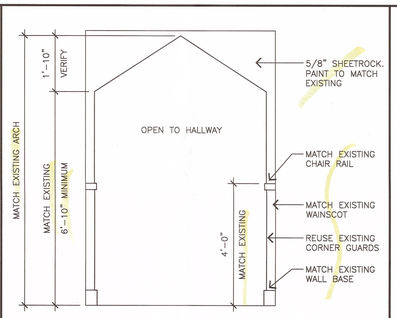

24 1/2" HALLWAY ARCH

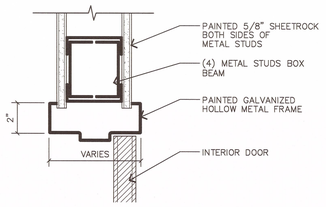

19 3" INTERIOR DOOR HEAD

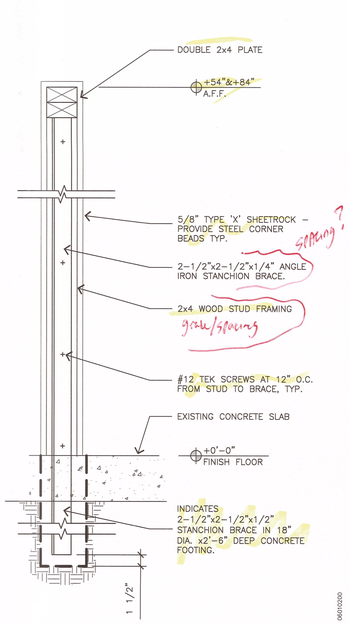


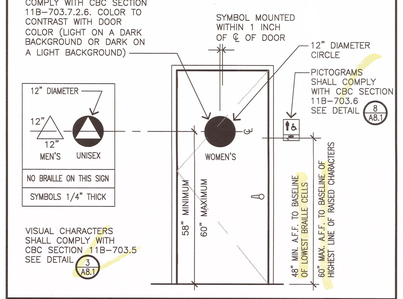

VISUAL CHARACTERS SHALL COMPLY WITH CBC SECTION 11B-703.5

EXCEPTION: WHERE VISUAL CHARACTERS COMPLY WITH CBC SECTION 11B-703.2 AND ARE ACCOMPANIED BY BRAILLE COMPLYING WITH SECTION 11B-703.3, THEY SHALL NOT BE REQUIRED TO COMPLY WITH SECTIONS 11B-703.5.2 THROUGH 11B-703.5.6, 11B-703.5.8 AND 11B-703.5.9

- CHARACTERS AND THEIR BACKGROUND SHALL HAVE A NON-GLARE FINISH. CHARACTERS SHALL CONTRAST WITH THEIR BACKGROUND WITH EITHER LIGHT CHARACTERS ON A DARK BACKGROUND OR DARK CHARACTERS ON A LIGHT BACKGROUND
- 11B-703.5.2: CHARACTERS SHALL BE UPPERCASE OR LOWERCASE OR A COMBINATION OF BOTH (SEE EXCEPTION ABOVE)
- 11B-703.5.3: CHARACTERS SHALL BE CONVENTIONAL IN FORM. CHARACTERS SHALL NOT BE ITALIC, OBLIQUE, SCRIPT, HIGHLY DECORATIVE, OR OF OTHER UNUSUAL FORMS (SEE EXCEPTION ABOVE)
- 11B-703.5.4: CHARACTERS SHALL BE SELECTED FROM FONTS WHERE THE WIDTH OF THE UPPERCASE LETTER "O" IS 60 PERCENT MINIMUM AND 110 MAXIMUM OF THE HEIGHT OF THE UPPERCASE LETTER "I" (SEE EXCEPTION ABOVE)
- 11B-703.5.5: MINIMUM CHARACTER HEIGHT SHALL COMPLY WITH CBC TABLE 11B-703.5.5. VIEWING DISTANCE SHALL BE MEASURED AS THE HORIZONTAL DISTANCE BETWEEN THE CHARACTER AND AN OBSTRUCTION PREVENTING FURTHER APPROACH TOWARDS THE SIGN. CHARACTER HEIGHT SHALL BE BASED ON THE UPPERCASE LETTER "I" (SEE EXCEPTION ABOVE)
- 11B-703.5.6: VISUAL CHARACTERS SHALL BE 40 INCHES MINIMUM ABOVE THE FINISH FLOOR OR GROUND (SEE EXCEPTION ABOVE)
- STROKE THICKNESS OF THE UPPERCASE LETTER "I" SHALL BE 10 PERCENT MINIMUM AND 20 PERCENT MAXIMUM OF THE HEIGHT OF THE CHARACTER
- 11B-703.5.8: CHARACTER SPACING SHALL BE MEASURED BETWEEN THE TWO CLOSEST POINTS OF ADJACENT CHARACTERS, EXCLUDING WORD SPACES. SPACING BETWEEN INDIVIDUAL CHARACTERS SHALL BE 10 PERCENT MINIMUM AND 35 PERCENT MAXIMUM OF CHARACTER HEIGHT. SEE EXCEPTION ABOVE
- 11B-703.5.9: SPACING BETWEEN THE BASELINES OF SEPARATE LINES OF CHARACTERS WITHIN A MESSAGE SHALL BE 135 PERCENT MINIMUM AND 170 PERCENT MAXIMUM OF THE CHARACTER HEIGHT. SEE EXCEPTION ABOVE
- TEXT SHALL BE IN A HORIZONTAL FORMAT

3 N.T.S. VISUAL CHARACTER NOTES

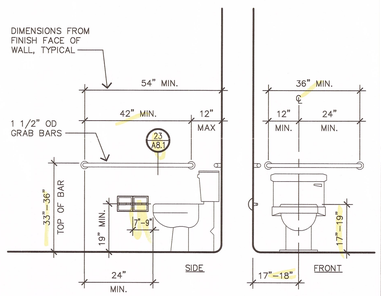

27 1/2" TYPICAL TOILET ELEVATIONS

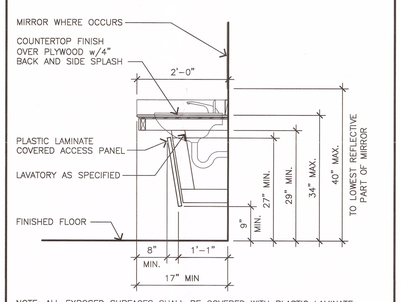

NOTE: ALL EXPOSED SURFACES SHALL BE COVERED WITH PLASTIC LAMINATE.

22 3/4" VANITY DETAIL

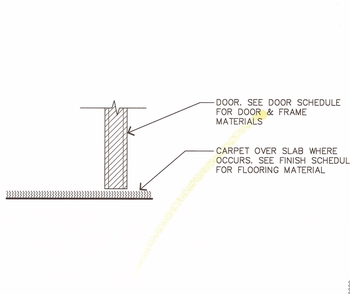

17 3" DOOR SILL

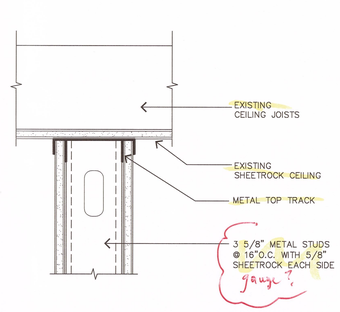

12 3" PARTITION @ CEILING

SYMBOLS OF ACCESSIBILITY AND THEIR BACKGROUND SHALL HAVE A NON-GLARE FINISH. SYMBOLS SHALL CONTRAST WITH THEIR BACKGROUND WITH EITHER A LIGHT SYMBOL ON A DARK BACKGROUND OR A DARK SYMBOL ON A LIGHT BACKGROUND

EXCEPTION: THE APPROPRIATE ENFORCEMENT AGENCY MAY APPROVE OTHER COLORS TO COMPLEMENT DECOR OR UNIQUE DESIGN. THE SYMBOL SHALL BE LIGHT ON DARK OR DARK ON LIGHT

INTERNATIONAL SYMBOL OF ACCESSIBILITY SHALL COMPLY WITH CBC FIGURE 11B-703.7.2.1

7 N.T.S. ACCESSIBILITY SYMBOL (ISA)

RAISED CHARACTERS SHALL COMPLY WITH CBC SECTION 11B-703.2 AND SHALL BE DUPLICATED IN BRAILLE COMPLYING WITH CBC SECTION 11B-703.3

- RAISED CHARACTERS SHALL BE 1/32 INCH MINIMUM ABOVE THEIR BACKGROUND
- CHARACTERS SHALL BE UPPERCASE
- CHARACTERS SHALL BE SANS SERIF. CHARACTERS SHALL NOT BE ITALIC, OBLIQUE, SCRIPT, HIGHLY DECORATIVE, OR OF OTHER UNUSUAL FORMS
- CHARACTERS SHALL BE SELECTED FROM FONTS WHERE THE WIDTH OF THE UPPERCASE LETTER "O" IS 60 PERCENT MINIMUM AND 110 PERCENT MAXIMUM OF THE HEIGHT OF THE UPPERCASE LETTER "I"
- CHARACTER HEIGHT MEASURED VERTICALLY FROM THE BASELINE OF THE CHARACTER SHALL BE 5/8 INCH MINIMUM AND 2 INCHES MAXIMUM BASED ON THE HEIGHT OF THE UPPERCASE LETTER "I"
- STROKE THICKNESS OF THE UPPERCASE LETTER "I" SHALL BE 15 PERCENT MAXIMUM OF THE HEIGHT OF THE CHARACTER
- CHARACTER SPACING SHALL BE MEASURED BETWEEN THE TWO CLOSEST POINTS OF ADJACENT RAISED CHARACTERS WITHIN A MESSAGE, EXCLUDING WORD SPACES AND SHALL COMPLY WITH CBC SECTION 11B-703.2.7
- SPACING BETWEEN THE BASELINES OF SEPARATE LINES OF RAISED CHARACTERS WITHIN A MESSAGE SHALL BE 135 PERCENT MINIMUM AND 170 PERCENT MAXIMUM OF THE RAISED CHARACTER HEIGHT
- TEXT SHALL BE IN A HORIZONTAL FORMAT

SIGNS CONTAINING TACTILE CHARACTERS SHALL BE LOCATED SO THAT A CLEAR FLOOR SPACE OF 18 INCHES BY 18 INCHES MINIMUM, CENTERED ON THE TACTILE CHARACTERS, IS PROVIDED BEYOND THE ARC OF ANY DOOR SWING BETWEEN THE CLOSED POSITION AND 45 DEGREES OPEN POSITION

2 N.T.S. RAISED CHARACTER NOTES

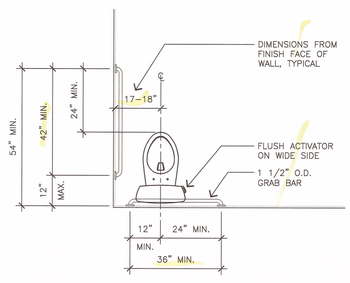

26 1/2" TYPICAL TOILET PLAN

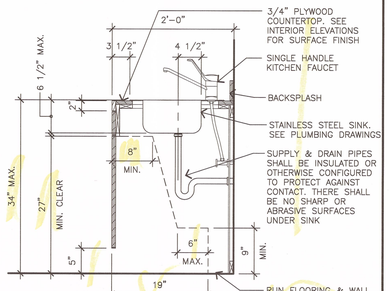

21 1" SINK CABINET

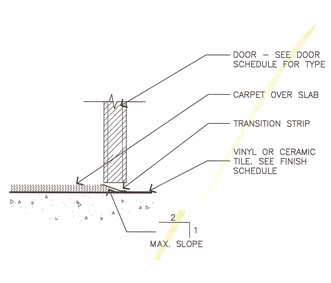

16 3" DOOR SILL TRANSITION

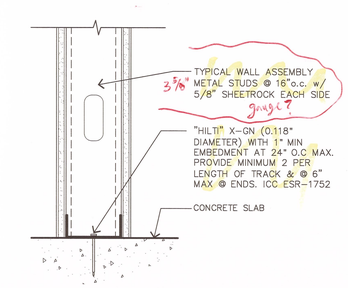

11 3" PARTITION @ SILL

TOILET COMPARTMENT DOORS: WHERE LOCATED IN THE FRONT PARTITION, DOOR OPENING SHALL BE 4 INCHES MAXIMUM FROM THE SIDE WALL OR PARTITION FARTHEST FROM THE TOILET. WHERE LOCATED IN SIDE WALL OR PARTITION, OPENING SHALL BE 4 INCHES MAXIMUM FROM THE FRONT PARTITION. DOOR SHALL BE SELF-CLOSING.

TOILET COMPARTMENT DOOR HARDWARE: DOOR PULL SHALL BE PLACED ON BOTH SIDES OF DOOR NEAR LATCH. OPERABLE PART OF PULL SHALL BE 34" MINIMUM AND 44 INCHES MAXIMUM ABOVE FINISH FLOOR OR GROUND. OPERABLE PARTS SHALL BE OPERABLE WITH ONE HAND AND SHALL NOT REQUIRE TIGHT GRASPING, PINCHING, OR TWISTING OF THE WRIST. THE FORCE REQUIRED TO ACTIVATE OPERABLE PARTS SHALL BE 5 POUNDS MAXIMUM.

TOILET COMPARTMENT TOE CLEARANCE: AT LEAST ONE SIDE OF PARTITION SHALL PROVIDE A TOE CLEARANCE OF 9 INCHES MINIMUM ABOVE THE FINISH FLOOR AND 6 INCHES DEEP MINIMUM BEYOND THE COMPARTMENT-SIDE FACE OF THE PARTITION, EXCLUSIVE OF PARTITION SUPPORT MEMBERS

FLUSH CONTROLS: FLUSH CONTROLS SHALL BE HAND OPERATED OR AUTOMATIC. HAND OPERATED FLUSH CONTROLS SHALL BE OPERABLE WITH ONE HAND AND SHALL NOT REQUIRE TIGHT GRASPING, PINCHING, OR TWISTING OF THE WRIST. THE FORCE REQUIRED TO ACTIVATE OPERABLE PARTS SHALL BE 5 POUNDS MAXIMUM. CONTROLS SHALL BE LOCATED 44 INCHES MAXIMUM ABOVE THE FLOOR. FLUSH CONTROLS FOR WATER CLOSETS SHALL BE LOCATED ON THE OPEN SIDE.

FAUCETS: CONTROLS FOR FAUCETS SHALL BE OPERABLE WITH ONE HAND AND SHALL NOT REQUIRE TIGHT GRASPING, PINCHING, OR TWISTING OF THE WRIST. THE FORCE REQUIRED TO ACTIVATE OPERABLE PARTS SHALL BE 5 POUNDS MAXIMUM. HAND-OPERATED METERING FAUCETS SHALL REMAIN OPEN FOR 10 SECONDS MINIMUM.

6 N.T.S. RESTROOM NOTES

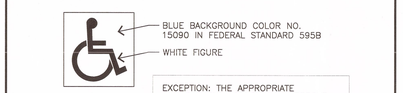

PICTOGRAMS SHALL COMPLY WITH CBC SECTION 11B-703.6

8 N.T.S. PICTOGRAMS

BRAILLE SHALL COMPLY WITH CBC SECTION 11B-703.3

- BRAILLE SHALL BE CONTRACTED (GRADE 2)
- BRAILLE DOTS SHALL HAVE A DOMED OR ROUNDED SHAPE AND SHALL COMPLY WITH CBC TABLE 11B-703.3.1. THE INDICATION OF AN UPPERCASE LETTER OR LETTERS SHALL ONLY BE USED BEFORE THE FIRST WORD OF SENTENCES, PROPER NOUNS AND NAMES, INDIVIDUAL LETTERS OF THE ALPHABET, INITIALS, AND ACRONYMS
- BRAILLE SHALL BE POSITIONED BELOW THE CORRESPONDING TEXT IN A HORIZONTAL FORMAT, FLUSH LEFT OR CENTERED. IF TEXT IS MULTI-LINED, BRAILLE SHALL BE PLACED BELOW THE ENTIRE TEXT. BRAILLE SHALL BE SEPARATED 3/8 INCH MINIMUM AND 1/2 INCH MAXIMUM FROM ANY OTHER TACTILE CHARACTERS AND 3/8 INCH MINIMUM FROM RAISED BORDERS AND DECORATIVE ELEMENTS
- SIGNS WITH TACTILE CHARACTERS SHALL COMPLY WITH CBC SECTION 11B-703.4
- SIGN INSTALLATION HEIGHT SHALL COMPLY WITH CBC SECTION 11B-703.4.1
- SIGN LOCATION SHALL COMPLY WITH CBC SECTION 11B-703.4.2

SIGNS CONTAINING TACTILE CHARACTERS SHALL BE LOCATED SO THAT A CLEAR FLOOR SPACE OF 18 INCHES BY 18 INCHES MINIMUM, CENTERED ON THE TACTILE CHARACTERS, IS PROVIDED BEYOND THE ARC OF ANY DOOR SWING BETWEEN THE CLOSED POSITION AND 45 DEGREES OPEN POSITION

1 N.T.S. BRAILLE NOTES

L Street Architects
Limited
1414 L Street
Modesto, California 95354
209-572-1405 209-572-4374 fax
www.lstreetarchitects.com

C-8827 RENEWAL 11/30/17 STATE OF CALIFORNIA – LICENSED ARCHITECT

TENANT IMPROVEMENT FOR:

CENTRAL VALLEY AUTISM PROJECT

5501 ANTIQUE ROSE WAY
RIVERBANK, CA 95367

REVISIONS:

DRAWN:	W. HADARI
DATE:	01/22/2016
FILE:	286-A81
JOB:	64.286
PRINT DATE:	

DETAILS

A8.1