
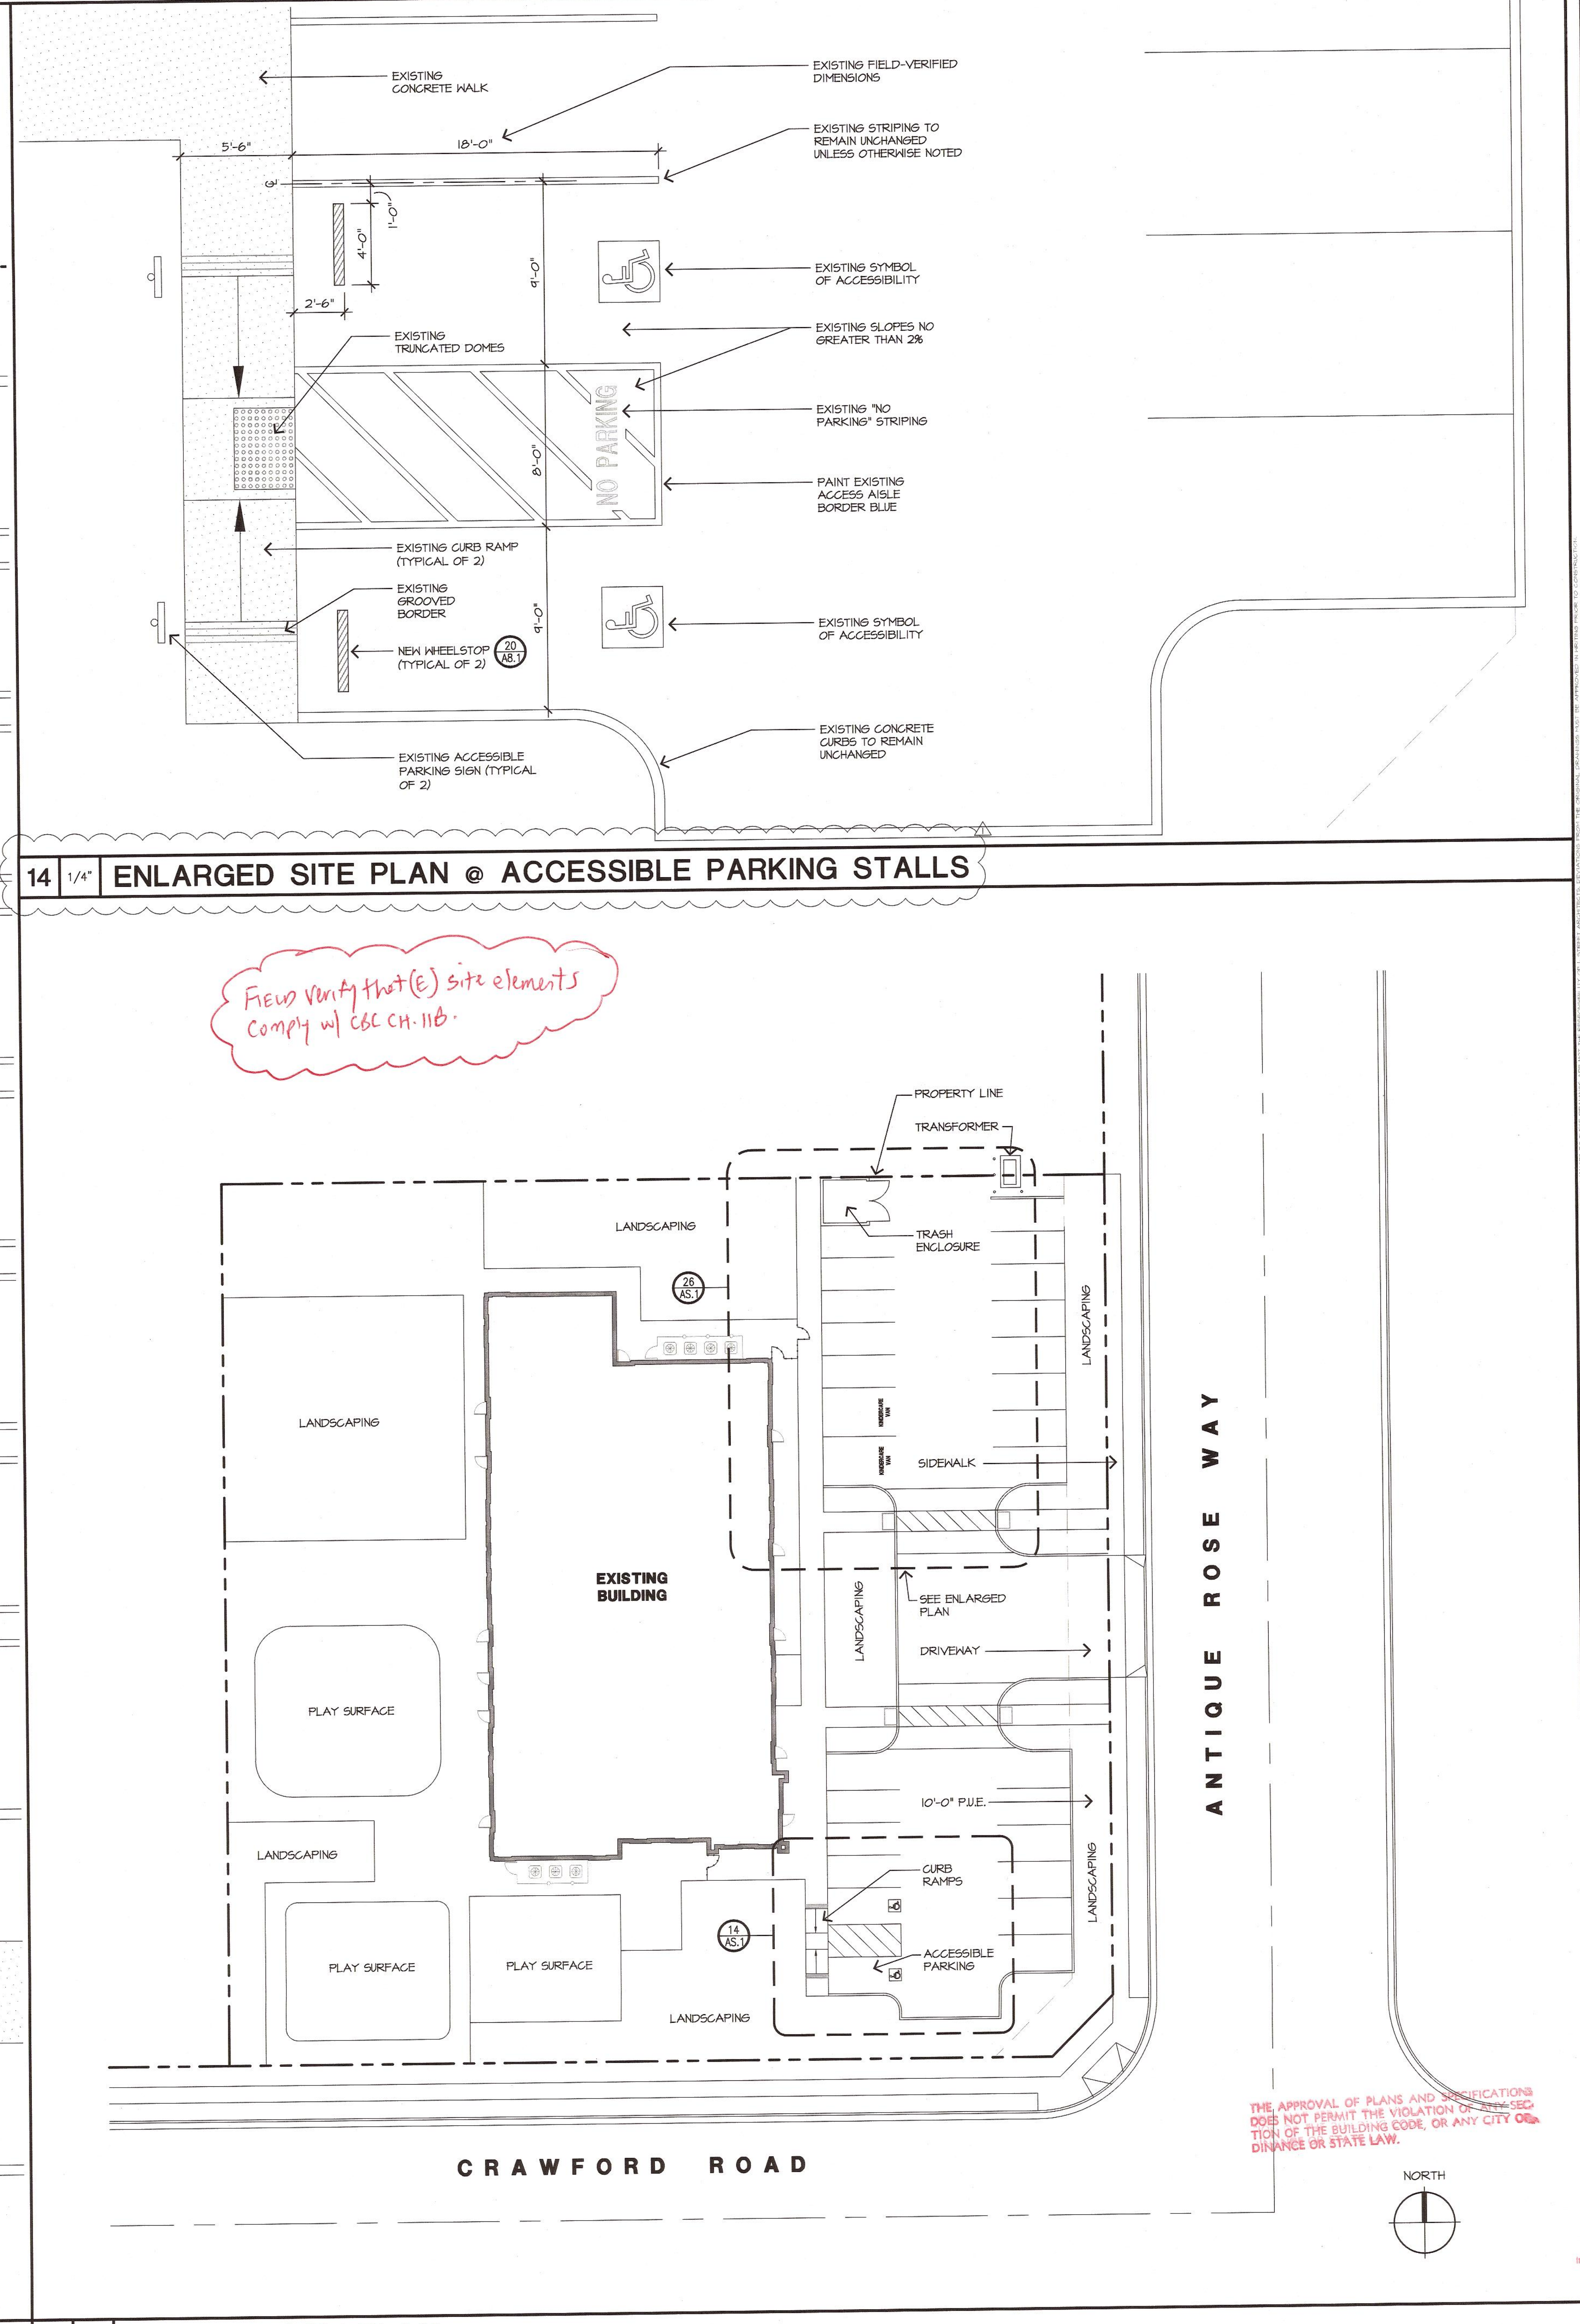


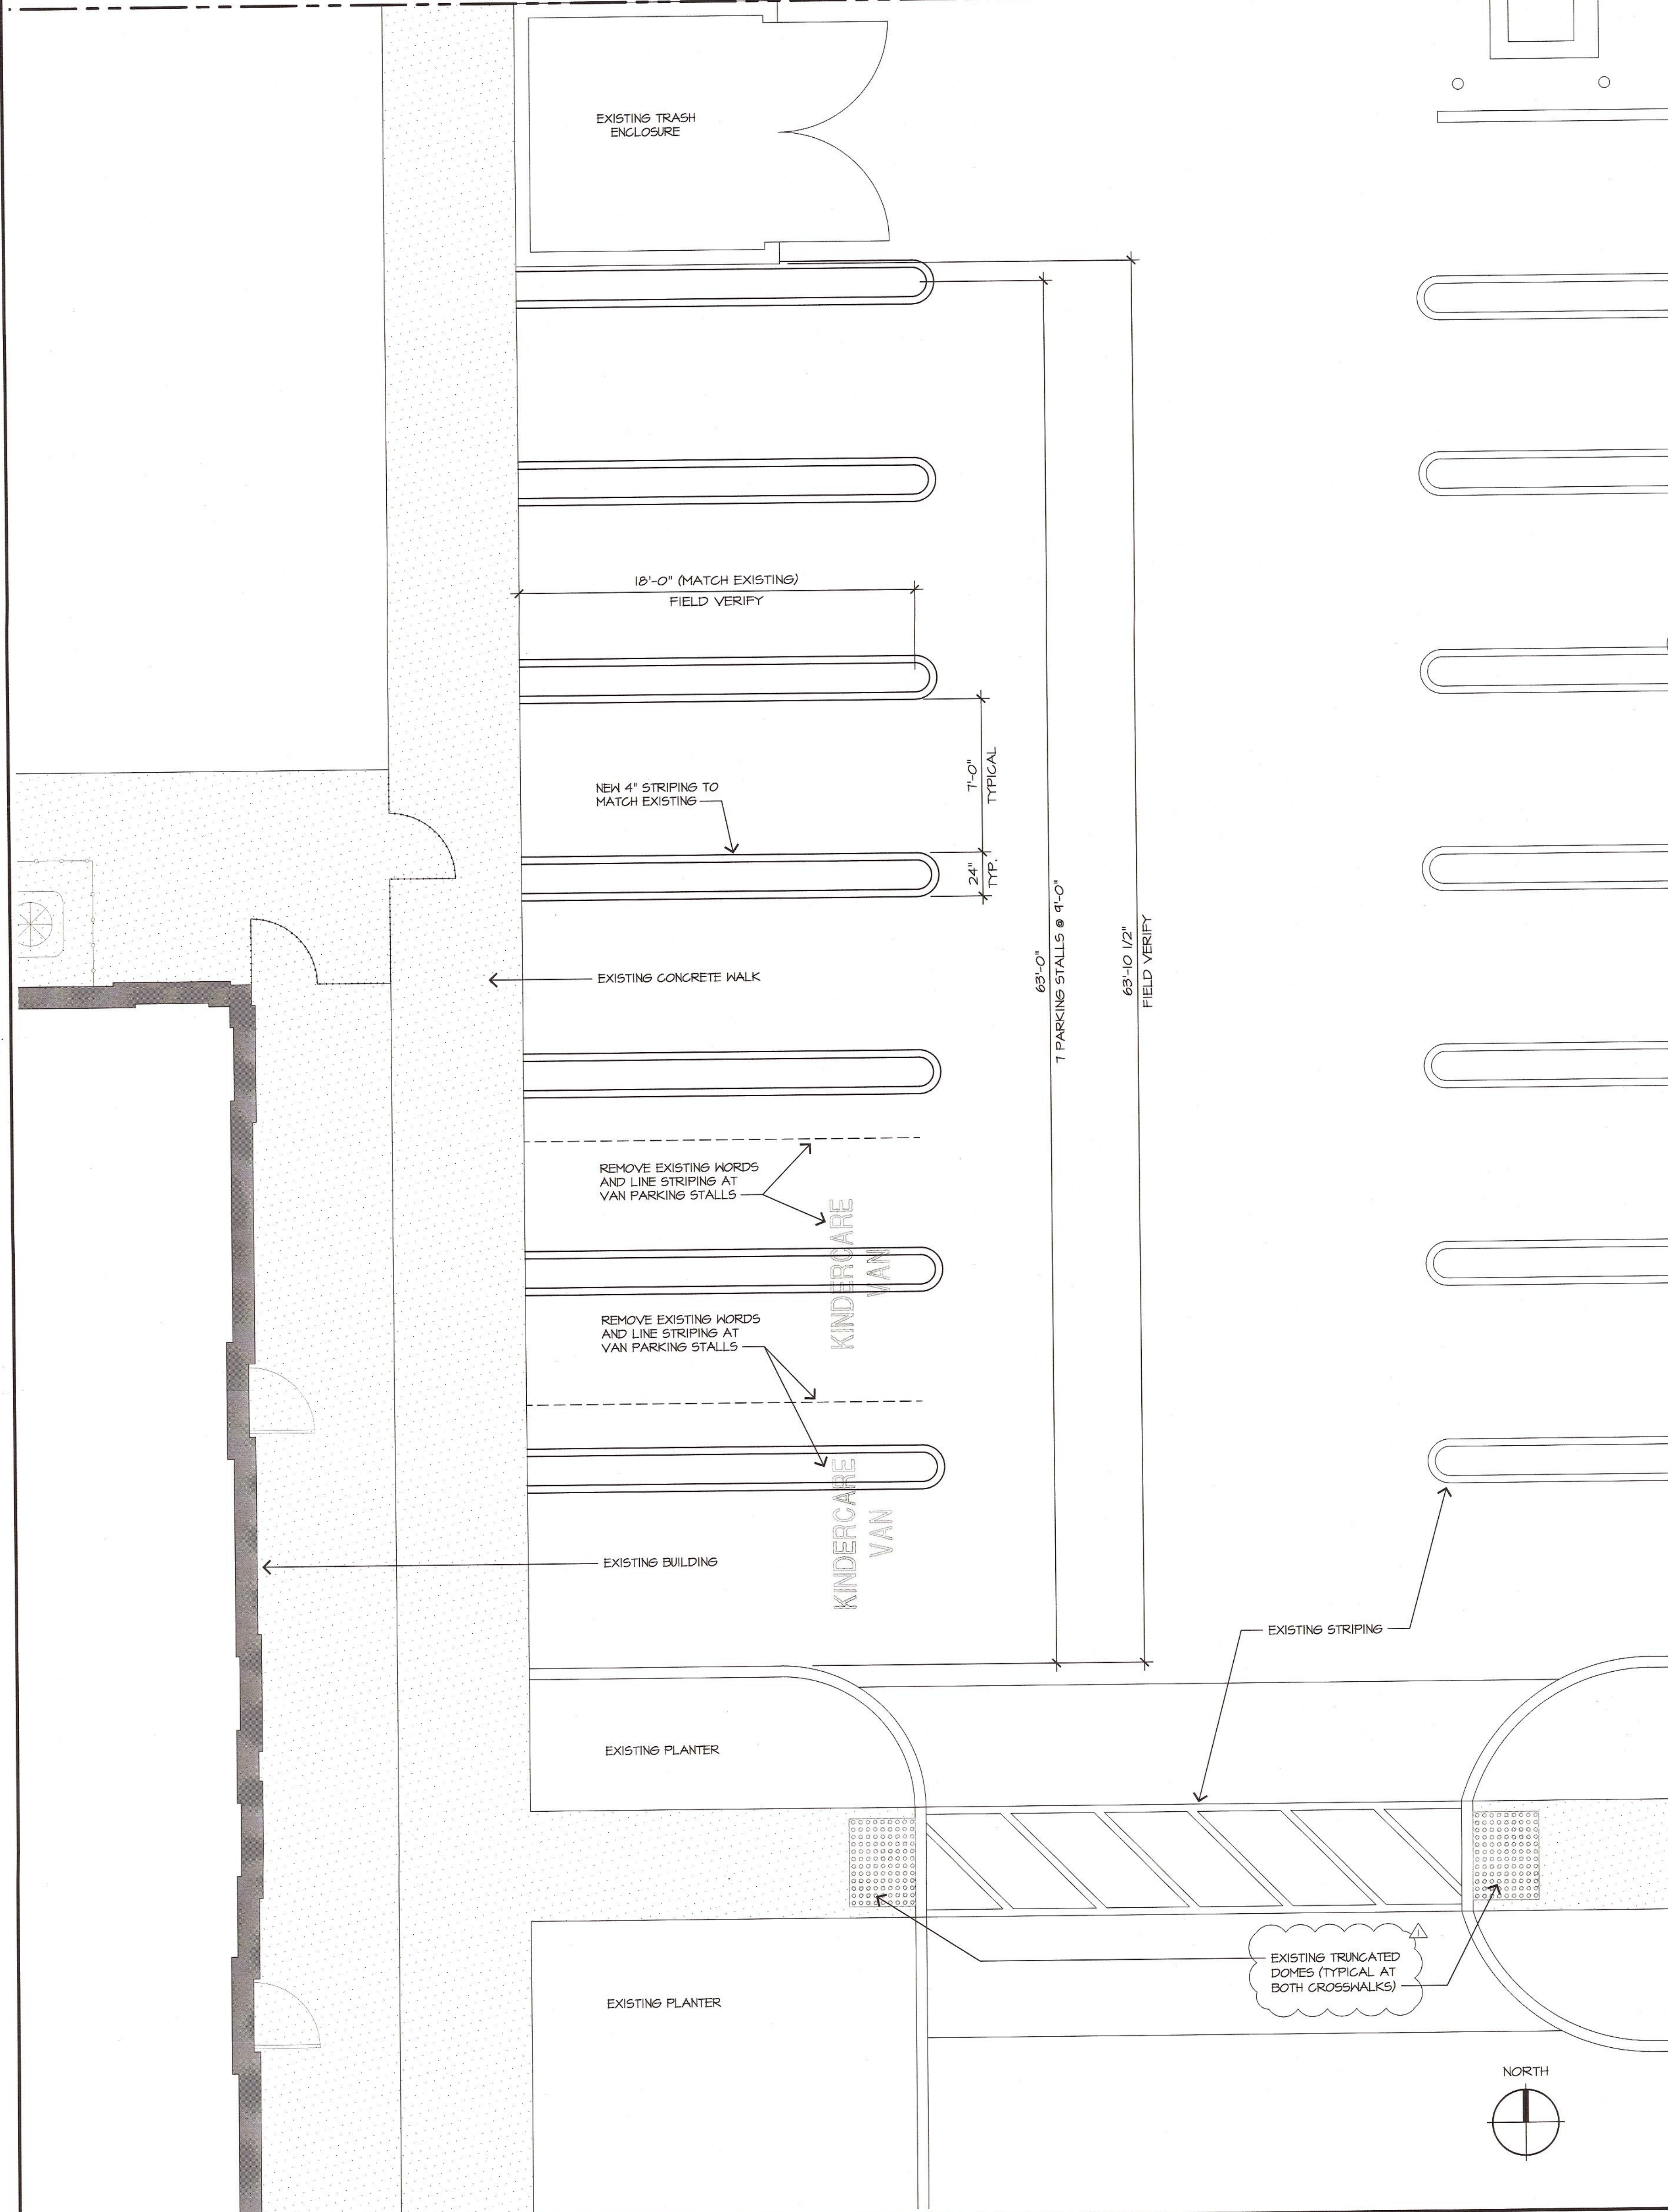

L Street Architects
L i m i t e d
1644 L Street
Pasadena, California 91104
209-375-4405 209-375-4574 Fax
www.lstreetarchitects.com

STATE OF CALIFORNIA
ARCHITECT
C-8827
JULY 1997
JULY 2016

TENANT IMPROVEMENT FOR:
CENTRAL VALLEY AUTISM PROJECT
5501 ANTIQUE ROSE WAY
RIVERBANK, CA 95367

REVISIONS:
△ OS-11-16 BLDG P.C.

DRAWN: H. HADARI
DATE: 01/22/2016
FILE: 286-AS1
JOB: 64-286
PRINT DATE:

SITE PLAN

PLANS REVIEWED BY:
Traffic Plan Review
and Plan Check Services
of

AS.1