

SECTION 009113 – ADDENDUM TWO

PART 1 - ADDENDA

1.1 PROJECT INFORMATION

- A. Project Identification: West Bolivar Consolidated School District Renovation Projects

Building A – West Bolivar Elementary, 1212 Main St, Rosedale, MS 38769

Building B – West Bolivar High School (formally Middle School), 1213 Main St, Rosedale, MS 38769

Building C – McEvans Elementary School, 601 Highway 61 North, Shaw, MS 38773

- B. Owner: West Bolivar Consolidated School District

- C. Architect: Dale | Bailey, an Association

- D. Architect Project Number: 20018

- E. Date of Addendum Two: 12 June 2020

1.2 NOTICE TO BIDDERS

- A. This Addendum is issued to all registered plan holders pursuant to the Instructions to Bidders and Conditions of the Contract. This Addendum serves to clarify, revise, and supersede information in the Project Manual, Drawings, and previously issued Addenda. Portions of the Addendum affecting the Contract Documents will be incorporated into the Contract by enumeration of the Addendum in the Owner/Contractor Agreement.

- B. The Bidder shall acknowledge receipt of this Addendum in the appropriate space on the Bid Form.

1.3 GENERAL RESPONSES TO BIDDER QUESTIONS VIA RFI'S

- A. QUESTION: Will the school be responsible for moving furniture, book shelves, filing cabinets, etc. away from the walls for summer work? It clarifies in the addendum that the contractor will be responsible during the school year.

ANSWER: Contractor will be responsible for moving furniture and equipment. Owner will be responsible for moving electronics and personal items.

- B. QUESTION: Will the school be responsible for taking down and reinstalling window blinds.

ANSWER: Contractor is responsible for taking down and reinstalling window blinds if required.



- C. QUESTION: Please clarify whether or not the fixed in place millwork is to be painted.

ANSWER: Millwork with existing paint is to be repainted.

- D. QUESTION: West Bolivar High: On Sheet G-301 B, Picture 8 says to refer to drawings for ADA ramp work in the boys' and girls' home locker rooms, which it shows on sheet A-402B. Picture 17 looks to be the guest locker rooms, and it says to raise the floor to FF level. Is this correct? Are these the only two rooms that are getting raised floors?

ANSWER: We are adding the ADA to rooms L2 and L4 which are the Home Team lockers. We are only adding a 4' landing level with FF right inside the entrance with an ADA compliant (1/12 slope) ramp extending from the landing. The ramp is to be as long as necessary to maintain slope and reach from FF level to the locker floor level.

1.4 REVISIONS TO DIVISION 00 – PROCUREMENT REQUIREMENTS AND CONTRACTING REQUIREMENTS

- A. DOCUMENT AIA A101-2017 EXHIBIT A – INSURANCE AND BONDS DRAFT. Reissued. Delete this section in its entirety and replace with revised Section attached to this addendum. Added insurance limits.

1.5 REVISIONS TO DRAWINGS

- A. Sheet E-000, E-100, E-101, E-102, E-104, E-105, E-108, E-109, E-110, ED-100s. ED-100, ED-101, Ed-102, ED-103, ED-104, ED-107, ED-108, and ED-109 (Revised). Delete these sheets in their entirety and replace with revised sheets attached. See Addendum #2 Narrative for description of changes.

1.6 ATTACHMENTS

- A. This Addendum includes the following attached Specifications:

1. Document AIA 101-2017 Exhibit A.

- B. This Addendum includes the following attached Sheets:

1. Addendum #2 Narrative dated 12 June 2020.
2. Sheet E-000 Electrical Legend dated 12 June 2020.
3. Sheet ED-100 Overall Demolition Plan dated 12 June 2020.
4. Sheet ED-101 Partial Demolition Plan – Part A, B, C dated 12 June 2020.
5. Sheet ED-102 Partial Demolition Plan – Part D, E, F dated 12 June 2020.
6. Sheet ED-103 Overall Demolition Plan dated 12 June 2020.
7. Sheet ED-104 Partial Demolition Plan – Part A dated 12 June 2020.
8. Sheet ED-105 Partial Demolition Plan – Part B dated 12 June 2020.
9. Sheet ED-106 Partial Demolition Plan – Part C dated 12 June 2020.
10. Sheet ED-107 Overall Demolition Plan dated 12 June 2020.
11. Sheet ED-108 Partial Demolition Plan – Part A dated 12 June 2020.
12. Sheet ED-109 Partial Demolition Plan – Part B dated 12 June 2020.
13. Sheet ED-110 Partial Demolition Plan – Part C dated 12 June 2020.

14. Sheet ED-111 Partial Demolition Plan – Part D dated 12 June 2020.
15. Sheet E-100 Overall Lighting Plan dated 12 June 2020.
16. Sheet E-101 Partial Lighting Plan dated 12 June 2020.
17. Sheet E-102 Partial Lighting Plan dated 12 June 2020.
18. Sheet E-104 Partial Lighting Plan – Part A dated 12 June 2020.
19. Sheet E-105 Partial Lighting Plan – Part B dated 12 June 2020.
20. Sheet E-108 Partial Lighting Plan – Part A dated 12 June 2020.
21. Sheet E-109 Partial Lighting Plan – Part B dated 12 June 2020.
22. Sheet E-110 Partial Lighting Plan – Part C dated 12 June 2020.

END OF ADDENDUM TWO

DRAFT AIA® Document A101™ – 2017

Exhibit A

Insurance and Bonds

This Insurance and Bonds Exhibit is part of the Agreement, between the Owner and the Contractor, dated the « » day of «TBD » in the year «Two Thousand Twenty »
(In words, indicate day, month and year.)

for the following **PROJECT**:
(Name and location or address)

2018 West Bolivar Consolidated School District Renovation Projects
Building A – West Bolivar Elementary, Rosedale, MS
Building B – West Bolivar High (formally Middle), Rosedale, MS
Building C – McEvans, Shaw, MS

THE OWNER:
(Name, legal status and address)

«West Bolivar Consolidated School District»
«909 Highway 8
Rosedale, MS 38769»
« »

THE CONTRACTOR:
(Name, legal status and address)

«TBD »« »
« »

TABLE OF ARTICLES

- A.1 GENERAL
- A.2 OWNER'S INSURANCE
- A.3 CONTRACTOR'S INSURANCE AND BONDS
- A.4 SPECIAL TERMS AND CONDITIONS

ARTICLE A.1 GENERAL

The Owner and Contractor shall purchase and maintain insurance, and provide bonds, as set forth in this Exhibit. As used in this Exhibit, the term General Conditions refers to AIA Document A201™–2017, General Conditions of the Contract for Construction.

ARTICLE A.2 OWNER'S INSURANCE

§ A.2.1 General

Prior to commencement of the Work, the Owner shall secure the insurance, and provide evidence of the coverage, required under this Article A.2 and, upon the Contractor's request, provide a copy of the property insurance policy or policies required by Section A.2.3. The copy of the policy or policies provided shall contain all applicable conditions, definitions, exclusions, and endorsements.

ADDITIONS AND DELETIONS:
The author of this document has added information needed for its completion. The author may also have revised the text of the original AIA standard form. An *Additions and Deletions Report* that notes added information as well as revisions to the standard form text is available from the author and should be reviewed.

This document has important legal consequences. Consultation with an attorney is encouraged with respect to its completion or modification.

This document is intended to be used in conjunction with AIA Document A201™–2017, General Conditions of the Contract for Construction. Article 11 of A201™–2017 contains additional insurance provisions.

ELECTRONIC COPYING of any portion of this AIA® Document to another electronic file is prohibited and constitutes a violation of copyright laws as set forth in the footer of this document.

§ A.2.2 Liability Insurance

The Contractor will pay for and maintain such insurance as will protect the Owner and Architect from their contingent liability to others from damages because of bodily injury, including death, which may arise from operations under this Contract and other liability for damages which the Contractor is required to insure under any provision of this Contract. Certificate of this insurance shall be filed with the Owner and Architect and will be the same limits set forth in this Exhibit A, Article A3.2.2.

§ A.2.3 Required Property Insurance

§ A.2.3.1 Unless this obligation is placed on the Contractor pursuant to Section A.3.3.2.1, the Owner shall purchase and maintain, from an insurance company or insurance companies lawfully authorized to issue insurance in the jurisdiction where the Project is located, property insurance written on a builder's risk "all-risks" completed value or equivalent policy form and sufficient to cover the total value of the entire Project on a replacement cost basis. The Owner's property insurance coverage shall be no less than the amount of the initial Contract Sum, plus the value of subsequent Modifications and labor performed and materials or equipment supplied by others. The property insurance shall be maintained until Substantial Completion and thereafter as provided in Section A.2.3.1.3, unless otherwise provided in the Contract Documents or otherwise agreed in writing by the parties to this Agreement. This insurance shall include the interests of the Owner, Contractor, Subcontractors, and Sub-subcontractors in the Project as insureds. This insurance shall include the interests of mortgagees as loss payees.

§ A.2.3.1.1 Causes of Loss. The insurance required by this Section A.2.3.1 shall provide coverage for direct physical loss or damage, and shall not exclude the risks of fire, explosion, theft, vandalism, malicious mischief, collapse, earthquake, flood, or windstorm. The insurance shall also provide coverage for ensuing loss or resulting damage from error, omission, or deficiency in construction methods, design, specifications, workmanship, or materials. Sub-limits, if any, are as follows:

(Indicate below the cause of loss and any applicable sub-limit.)

Causes of Loss	Sub-Limit

§ A.2.3.1.2 Specific Required Coverages. The insurance required by this Section A.2.3.1 shall provide coverage for loss or damage to falsework and other temporary structures, and to building systems from testing and startup. The insurance shall also cover debris removal, including demolition occasioned by enforcement of any applicable legal requirements, and reasonable compensation for the Architect's and Contractor's services and expenses required as a result of such insured loss, including claim preparation expenses. Sub-limits, if any, are as follows:

(Indicate below type of coverage and any applicable sub-limit for specific required coverages.)

Coverage	Sub-Limit

§ A.2.3.1.3 Unless the parties agree otherwise, upon Substantial Completion, the Owner shall continue the insurance required by Section A.2.3.1 or, if necessary, replace the insurance policy required under Section A.2.3.1 with property insurance written for the total value of the Project that shall remain in effect until expiration of the period for correction of the Work set forth in Section 12.2.2 of the General Conditions.

§ A.2.3.1.4 Deductibles and Self-Insured Retentions. If the property insurance requires minimum deductibles, the Contractor shall pay the deductible and all other costs not covered because of such deductibles. If the Contractor or insurer increases the required minimum deductibles above the amounts so identified or if the Contractor elects to purchase this insurance with voluntary deductible amounts, the Contractor shall be responsible for the payment of the additional costs not covered because of such increased or voluntary deductibles.

§ A.2.3.2 Occupancy or Use Prior to Substantial Completion. The Owner's occupancy or use of any completed or partially completed portion of the Work prior to Substantial Completion shall not commence until the insurance company or companies providing the insurance under Section A.2.3.1 have consented in writing to the continuance of coverage. The Owner and the Contractor shall take no action with respect to partial occupancy or use that would cause cancellation, lapse, or reduction of insurance, unless they agree otherwise in writing.

§ A.2.3.3 Insurance for Existing Structures

If the Work involves remodeling an existing structure or constructing an addition to an existing structure, the Owner shall purchase and maintain, until the expiration of the period for correction of Work as set forth in Section 12.2.2 of the General Conditions, “all-risks” property insurance, on a replacement cost basis, protecting the existing structure against direct physical loss or damage from the causes of loss identified in Section A.2.3.1, notwithstanding the undertaking of the Work. The Owner shall be responsible for all co-insurance penalties.

§ A.2.4 Optional Extended Property Insurance.

The Owner shall purchase and maintain the insurance selected and described below.

(Select the types of insurance the Owner is required to purchase and maintain by placing an X in the box(es) next to the description(s) of selected insurance. For each type of insurance selected, indicate applicable limits of coverage or other conditions in the fill point below the selected item.)

- [] § A.2.4.1 **Loss of Use, Business Interruption, and Delay in Completion Insurance**, to reimburse the Owner for loss of use of the Owner’s property, or the inability to conduct normal operations due to a covered cause of loss.
- [] § A.2.4.2 **Ordinance or Law Insurance**, for the reasonable and necessary costs to satisfy the minimum requirements of the enforcement of any law or ordinance regulating the demolition, construction, repair, replacement or use of the Project.
- [] § A.2.4.3 **Expediting Cost Insurance**, for the reasonable and necessary costs for the temporary repair of damage to insured property, and to expedite the permanent repair or replacement of the damaged property.
- [] § A.2.4.4 **Extra Expense Insurance**, to provide reimbursement of the reasonable and necessary excess costs incurred during the period of restoration or repair of the damaged property that are over and above the total costs that would normally have been incurred during the same period of time had no loss or damage occurred.
- [] § A.2.4.5 **Civil Authority Insurance**, for losses or costs arising from an order of a civil authority prohibiting access to the Project, provided such order is the direct result of physical damage covered under the required property insurance.
- [] § A.2.4.6 **Ingress/Egress Insurance**, for loss due to the necessary interruption of the insured’s business due to physical prevention of ingress to, or egress from, the Project as a direct result of physical damage.
- [] § A.2.4.7 **Soft Costs Insurance**, to reimburse the Owner for costs due to the delay of completion of the Work, arising out of physical loss or damage covered by the required property insurance: including construction loan fees; leasing and marketing expenses; additional fees, including those of architects, engineers, consultants, attorneys and accountants, needed for the completion of the construction,

repairs, or reconstruction; and carrying costs such as property taxes, building permits, additional interest on loans, realty taxes, and insurance premiums over and above normal expenses.

« »

§ A.2.5 Other Optional Insurance.

The Owner shall purchase and maintain the insurance selected below.

(Select the types of insurance the Owner is required to purchase and maintain by placing an X in the box(es) next to the description(s) of selected insurance.)

[] **§ A.2.5.1 Cyber Security Insurance** for loss to the Owner due to data security and privacy breach, including costs of investigating a potential or actual breach of confidential or private information. *(Indicate applicable limits of coverage or other conditions in the fill point below.)*

« »

[] **§ A.2.5.2 Other Insurance**
(List below any other insurance coverage to be provided by the Owner and any applicable limits.)

Coverage	Limits

ARTICLE A.3 CONTRACTOR'S INSURANCE AND BONDS

§ A.3.1 General

§ A.3.1.1 Certificates of Insurance. The Contractor shall provide certificates of insurance acceptable to the Owner evidencing compliance with the requirements in this Article A.3 at the following times: (1) prior to commencement of the Work; (2) upon renewal or replacement of each required policy of insurance; and (3) upon the Owner's written request. An additional certificate evidencing continuation of commercial liability coverage, including coverage for completed operations, shall be submitted with the final Application for Payment and thereafter upon renewal or replacement of such coverage until the expiration of the periods required by Section A.3.2.1 and Section A.3.3.1. The certificates will show the Owner and Architect as an additional insured on the Contractor's Commercial General Liability and excess or umbrella liability policy or policies and the Contractor's certificate of insurance must state that the Owner and the Architect are additional insureds under the referenced CGL policy and that all of the Contractor's contractual liabilities, including but not limited to its indemnity obligations, are covered by such CGL policy.

Any language contained on the certificate of insurance form or elsewhere to the contrary is deemed stricken.

The certificate of insurance must also state that all of the Contractor's contractual liabilities, including but not limited its indemnity obligations, are covered. Any terms and conditions contained in the certificate of insurance which are contrary to the Contractor's contractual obligations are hereby stricken from the certificate.

§ A.3.1.2 Deductibles and Self-Insured Retentions. The Contractor shall disclose to the Owner any deductible or self-insured retentions applicable to any insurance required to be provided by the Contractor.

§ A.3.1.3 Additional Insured Obligations. To the fullest extent permitted by law, the Contractor shall cause the commercial general liability coverage to include (1) the Owner, the Architect, and the Architect's consultants as additional insureds for claims caused in whole or in part by the Contractor's negligent acts or omissions during the Contractor's operations; and (2) the Owner as an additional insured for claims caused in whole or in part by the Contractor's negligent acts or omissions for which loss occurs during completed operations. The additional insured coverage shall be primary and non-contributory to any of the Owner's general liability insurance policies and shall apply to both ongoing and completed operations. To the extent commercially available, the additional insured coverage shall be no less than that provided by Insurance Services Office, Inc. (ISO) forms CG 20 10 07 04, CG 20 37 07 04, and, with respect to the Architect and the Architect's consultants, CG 20 32 07 04.

§ A.3.1.4 Copies of Certificates. Furnish one copy of the certificate herein required for each copy of the Agreement, specifically setting forth evidence of all coverage required. Furnish to the Owner and Architect, copies of any

endorsements that are subsequently issued amending coverage or limits. If the coverages are provided on a claims-made basis, the policy date or retroactive date shall predate the Contract and the termination date of the policy, or the applicable extended reporting period shall be no earlier than the termination date of coverages required to be maintained after final payment.

§ A.3.2 Contractor's Required Insurance Coverage

§ A.3.2.1 The Contractor shall purchase and maintain the following types and limits of insurance from an insurance company or insurance companies lawfully authorized to issue insurance in the jurisdiction where the Project is located. The Contractor shall maintain the required insurance until the expiration of the period for correction of Work as set forth in Section 12.2.2 of the General Conditions, unless a different duration is stated below:

(If the Contractor is required to maintain insurance for a duration other than the expiration of the period for correction of Work, state the duration.)

<< >>

§ A.3.2.2 Commercial General Liability

§ A.3.2.2.1 Commercial General Liability insurance for the Project written on an occurrence form with policy limits of not less than One Million Dollars (\$ 1,000,000.00) each occurrence, Two Million Dollars (\$ 2,000,000.00) general aggregate, and << >> (\$ << >>) aggregate for products-completed operations hazard, providing coverage for claims including

- .1 damages because of bodily injury, sickness or disease, including occupational sickness or disease, and death of any person;
- .2 personal injury and advertising injury;
- .3 damages because of physical damage to or destruction of tangible property, including the loss of use of such property;
- .4 bodily injury or property damage arising out of completed operations; and
- .5 the Contractor's indemnity obligations under Section 3.18 of the General Conditions.

§ A.3.2.2.2 The Contractor's Commercial General Liability policy under this Section A.3.2.2 shall not contain an exclusion or restriction of coverage for the following:

- .1 Claims by one insured against another insured, if the exclusion or restriction is based solely on the fact that the claimant is an insured, and there would otherwise be coverage for the claim.
- .2 Claims for property damage to the Contractor's Work arising out of the products-completed operations hazard where the damaged Work or the Work out of which the damage arises was performed by a Subcontractor.
- .3 Claims for bodily injury other than to employees of the insured.
- .4 Claims for indemnity under Section 3.18 of the General Conditions arising out of injury to employees of the insured.
- .5 Claims or loss excluded under a prior work endorsement or other similar exclusionary language.
- .6 Claims or loss due to physical damage under a prior injury endorsement or similar exclusionary language.
- .7 Claims related to residential, multi-family, or other habitational projects, if the Work is to be performed on such a project.
- .8 Claims related to roofing, if the Work involves roofing.
- .9 Claims related to exterior insulation finish systems (EIFS), synthetic stucco or similar exterior coatings or surfaces, if the Work involves such coatings or surfaces.
- .10 Claims related to earth subsidence or movement, where the Work involves such hazards.
- .11 Claims related to explosion, collapse and underground hazards, where the Work involves such hazards.

§ A.3.2.3 Automobile Liability covering vehicles owned, and non-owned vehicles used, by the Contractor, with policy limits of not less than One Million Dollars (\$ 1,000,000.00) per accident, for bodily injury, death of any person, and property damage arising out of the ownership, maintenance and use of those motor vehicles along with any other statutorily required automobile coverage.

§ A.3.2.4 The Contractor may achieve the required limits and coverage for Commercial General Liability and Automobile Liability through a combination of primary and excess or umbrella liability insurance, provided such primary and excess or umbrella insurance policies result in the same or greater coverage as the coverages required under Section A.3.2.2 and A.3.2.3, and in no event shall any excess or umbrella liability insurance provide narrower coverage than the primary policy. The excess policy shall not require the exhaustion of the underlying limits only through the actual payment by the underlying insurers.

§ A.3.2.5 Workers' Compensation at statutory limits.

§ A.3.2.6 Employers' Liability with policy limits not less than One Hundred Thousand Dollars (\$ 100,000.00) each accident, One Hundred Thousand Dollars (\$ 100,00.00) each employee, and One Hundred Thousand Dollars (\$ 100,000.00) policy limit.

§ A.3.2.7 Jones Act, and the Longshore & Harbor Workers' Compensation Act, as required, if the Work involves hazards arising from work on or near navigable waterways, including vessels and docks

§ A.3.2.8 If the Contractor is required to furnish professional services as part of the Work, the Contractor shall procure Professional Liability insurance covering performance of the professional services, with policy limits of not less than One Million Dollars (\$ 1,000,000.00) per claim and One Million Dollars (\$ 1,000,000.00) in the aggregate.

§ A.3.2.9 Paragraph Intentionally Deleted.

§ A.3.2.10 Paragraph Intentionally Deleted.

§ A.3.2.11 Paragraph Intentionally Deleted.

§ A.3.3 Contractor's Other Insurance Coverage

§ A.3.3.1 Insurance selected and described in this Section A.3.3 shall be purchased from an insurance company or insurance companies lawfully authorized to issue insurance in the jurisdiction where the Project is located. The Contractor shall maintain the required insurance until the expiration of the period for correction of Work as set forth in Section 12.2.2 of the General Conditions, unless a different duration is stated below:

(If the Contractor is required to maintain any of the types of insurance selected below for a duration other than the expiration of the period for correction of Work, state the duration.)

« »

§ A.3.3.2 The Contractor shall purchase and maintain the following types and limits of insurance in accordance with Section A.3.3.1.

(Select the types of insurance the Contractor is required to purchase and maintain by placing an X in the box(es) next to the description(s) of selected insurance. Where policy limits are provided, include the policy limit in the appropriate fill point.)

- [] § A.3.3.2.1 Property insurance of the same type and scope satisfying the requirements identified in Section A.2.3, which, if selected in this section A.3.3.2.1, relieves the Owner of the responsibility to purchase and maintain such insurance except insurance required by Section A.2.3.1.3 and Section A.2.3.3. The Contractor shall comply with all obligations of the Owner under Section A.2.3 except to the extent provided below. The Contractor shall disclose to the Owner the amount of any deductible, and the Owner shall be responsible for losses within the deductible. Upon request, the Contractor shall provide the Owner with a copy of the property insurance policy or policies required. The Owner shall adjust and settle the loss with the insurer and be the trustee of the proceeds of the property insurance in accordance with Article 11 of the General Conditions unless otherwise set forth below: *(Where the Contractor's obligation to provide property insurance differs from the Owner's obligations as described under Section A.2.3, indicate such differences in the space below. Additionally, if a party other than the Owner will be responsible for adjusting and settling a loss with*

the insurer and acting as the trustee of the proceeds of property insurance in accordance with Article 11 of the General Conditions, indicate the responsible party below.)

« »

[« »] § A.3.3.2.2 Railroad Protective Liability Insurance, with policy limits of not less than « » (\$ « ») per claim and « » (\$ « ») in the aggregate, for Work within fifty (50) feet of railroad property.

[« »] § A.3.3.2.3 Asbestos Abatement Liability Insurance, with policy limits of not less than « » (\$ « ») per claim and « » (\$ « ») in the aggregate, for liability arising from the encapsulation, removal, handling, storage, transportation, and disposal of asbestos-containing materials.

[« X »] § A.3.3.2.4 Insurance for physical damage to property while it is in storage and in transit to the construction site on an “all-risks” completed value form.

[« X »] § A.3.3.2.5 Property insurance on an “all-risks” completed value form, covering property owned by the Contractor and used on the Project, including scaffolding and other equipment.

[« »] § A.3.3.2.6 Other Insurance
(List below any other insurance coverage to be provided by the Contractor and any applicable limits.)

Coverage

Limits

§ A.3.4 Performance Bond and Payment Bond

The Contractor shall provide surety bonds, from a company or companies lawfully authorized to issue surety bonds in the jurisdiction where the Project is located, as follows:
(Specify type and penal sum of bonds.)

Type

Payment Bond

Penal Sum (\$0.00)

The amount of the initial Contract Sum, plus the value of subsequent modifications and labor performed and materials or equipment supplied by others.

Performance Bond

The amount of the initial Contract Sum, plus the value of subsequent modifications and labor performed and materials or equipment supplied by others.

Payment and Performance Bonds shall be AIA Document A312™, Payment Bond and Performance Bond, or contain provisions identical to AIA Document A312™, current as of the date of this Agreement.

ARTICLE A.4 SPECIAL TERMS AND CONDITIONS

Special terms and conditions that modify this Insurance and Bonds Exhibit, if any, are as follows:

«Owner shall be included as an additional insured on all insurance policies obtained and maintained by Contractor.

If requested by Owner, Contractor shall obtain and maintain a Dual Obligee rider in favor of Owner’s lender, if any, for the Payment and Performance Bonds required under this Agreement. »

The Power Source, PLLC

Consulting Engineers

945 Madison Avenue
Madison, MS 39110

Telephone: (601) 605-4820
Fax: (601) 605-4875

ADDENDUM #2

Date: 12 June 2020
To: Luigia Butler
From: Chris Green
Project #: 20062
Project Name: West Bolivar Consolidated School District Renovation Project
Location: West Bolivar, MS

Luigia,

Please issue the following with your next addendum.

E-000 – Modified Legend.

E-100 – Modified Sheet Title.

E-101 – Modified Sheet Titles.

E-101 – Added Alternate #4.

E-101 – Added Alternate #5.

E-101 – Modified Fixture Types.

E-102 – Modified Sheet Titles.

E-102 – Added Alternate #5.

E-102 – Modified Fixture Types.

E-102 – Additional Fixture were added.

E-104 – Modified Sheet Titles, Details & References.

E-104 – Modified Notes.

E-104 – Additional Fixtures were added.

E-105 – Additional Fixtures were added.

E-108 – Additional Fixtures were added due to a floor plan change.

The Power Source, PLLC

Consulting Engineers

945 Madison Avenue
Madison, MS 39110

Telephone: (601) 605-4820
Fax: (601) 605-4875

E-108 – Door was added.

E-108 – Additional Power was added.

E-108 – Modified Fixture Type.

E-109 – Modified Fixture Type.

E-110 – Floor Plan Changed.

E-110 – Fixture Type was Corrected.

E-110 – Modified Switching locations.

E-110 – Additional Power was added.

ED-100s – Modified Master Demolition Notes.

ED-100s – Added General Note.

ED-100 – Added Alternate #5.

ED-101 – Modified Sheet Titles.

ED-101 – Added Alternate #4.

ED-101 – Added Alternate #5.

ED-101 – Added Additional Drinking Fountains to be replaced.

ED-102 – Modified Sheet Titles.

ED-102 – Added Alternate #4.

ED-102 – Added Alternate #5.

ED-103 – Added General Notes and Keyed Notes.

ED-104 – Modified Sheet Titles & Details.

ED-104 – Modified Notes on the Plan.

The Power Source, PLLC

Consulting Engineers

945 Madison Avenue
Madison, MS 39110

Telephone: (601) 605-4820
Fax: (601) 605-4875

ED-104 – Took out a Drinking Fountain.


ED-107 – Added General Notes and Keyed Notes.

ED-108 – Floor Plan Changes.

ED-109 – Floor Plan Changes.

ED-109 – Added Additional Drinking Fountain to be replaced.


Sincerely,
Chris Green
The Power Source, PLLC

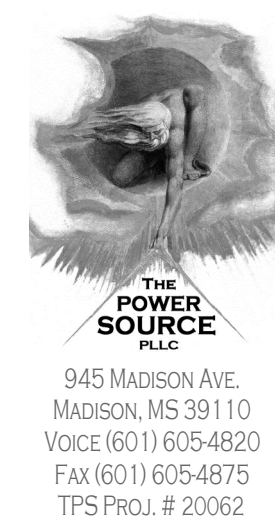

945 MADISON AVE.
MADISON, MS 39110
TPS PROJ. # 20062

AN ASSOCIATION
M I S S I S S I P P I

DALE BAILEY
JACKSON, MISSISSIPPI

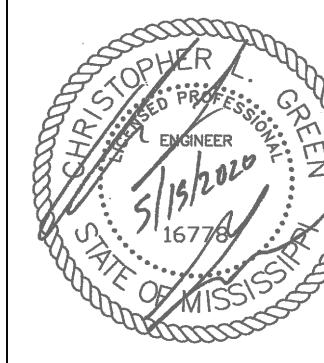

West Bolivar Consolidated School
District Renovation Project


100%
Construction
Documents

Project No 20018
Date 2020-05-15
Drawn FAB
Checked CLG
Revisions Rev Date
ADD#2 2020-06-12

E-000
ELECTRICAL LEGEND

LIGHTING FIXTURE SCHEDULE

TYPE	MANUFACTURER	PART NUMBER	LAMPS	MOUNTING	REMARKS
A	LITHONIA	EPANL-2X4-5400LM-80CRI-40K-MIN10-ZT-MVOLT	LED - 49W 5,679 LUMENS	RECESSED	
AE	LITHONIA	EPANL-2X4-5400LM-80CRI-40K-MIN10-ZT-MVOLT-E10WCP	LED - 49W 5,679 LUMENS	RECESSED	WITH EMERGENCY BATTERY PACK
B	LITHONIA	EPANL-2X4-4800LM-80CRI-40K-MIN10-ZT-MVOLT	LED - 45W 5,119 LUMENS	RECESSED	
BE	LITHONIA	EPANL-2X4-4800LM-80CRI-40K-MIN10-ZT-MVOLT-E10WCP	LED - 45W 5,119 LUMENS	RECESSED	WITH EMERGENCY BATTERY PACK
C	LITHONIA	EPANL-2X4-4000LM-80CRI-40K-MIN10-ZT-MVOLT-E10WCP	LED - 38W 4,403 LUMENS	RECESSED	
CE	LITHONIA	EPANL-2X4-4000LM-80CRI-40K-MIN10-ZT-MVOLT-E10WCP	LED - 38W 4,403 LUMENS	RECESSED	WITH EMERGENCY BATTERY PACK
D	LITHONIA	EPANL-2X4-3000LM-80CRI-40K-MIN10-ZT-MVOLT	LED - 29W 3,266 LUMENS	RECESSED	
DE	LITHONIA	EPANL-2X4-3000LM-80CRI-40K-MIN10-ZT-MVOLT-E10WCP	LED - 29W 3,266 LUMENS	RECESSED	WITH EMERGENCY BATTERY PACK
F	JUNO	JSF-13IN 18LM-40K-90CRI-MVOLT-ZT-WH	LED - 20W 1,800 LUMENS	SURFACE	
FE	JUNO	JSF-13IN 18LM-40K-90CRI-MVOLT-ZT-WH-EL	LED - 20W 1,800 LUMENS	SURFACE	WITH EMERGENCY BATTERY PACK
G1	LITHONIA	LBLA-6000LM-80CRI-40K-MIN1-GZT-MVOLT	LED - 49.7W 6,196 LUMENS	SURFACE/ SUSPENDED	
G1E	LITHONIA	LBLA-6000LM-80CRI-40K-MIN1-GZT-MVOLT-EL14L	LED - 49.7W 6,196 LUMENS	SURFACE/ SUSPENDED	WITH EMERGENCY BATTERY PACK
G2	LITHONIA	LBLA-3000LM-80CRI-40K-MIN1-GZT-MVOLT	LED - 25.6W 3,288 LUMENS	SURFACE/ SUSPENDED	
G2E	LITHONIA	LBLA-3000LM-80CRI-40K-MIN1-GZT-MVOLT-EL14L	LED - 25.6W 3,288 LUMENS	SURFACE/ SUSPENDED	WITH EMERGENCY BATTERY PACK
H	LITHONIA	FMVCSLS-36IN-40K-90CRI-*	LED - 30W 2,560 LUMENS	WALL	* - FINISH BY ARCHITECT
J	LITHONIA	FEM-L48-3000LM-LPAFL-WD-MVOLT-GZ10-40K-80CRI	LED - 18W 3,042 LUMENS	SURFACE/ SUSPENDED	
JE	LITHONIA	FEM-L48-3000LM-LPAFL-WD-MVOLT-GZ10-40K-80CRI-E10WCP	LED - 18W 3,042 LUMENS	SURFACE/ SUSPENDED	WITH EMERGENCY BATTERY PACK
J2	LITHONIA	FEM-L48-4000LM-LPAFL-WD-MVOLT-GZ10-40K-80CRI	LED - 23.8W 4,009 LUMENS	SURFACE/ SUSPENDED	
J2E	LITHONIA	FEM-L48-4000LM-LPAFL-WD-MVOLT-GZ10-40K-80CRI-E10WCP	LED - 23.8W 4,009 LUMENS	SURFACE/ SUSPENDED	WITH EMERGENCY BATTERY PACK
J3	LITHONIA	FEM-L48-XXXXLM-LPAFL-WD-MVOLT-GZ10-40K-80CRI	LED - 62W 9,782 LUMENS	SURFACE/ SUSPENDED	
J3E	LITHONIA	FEM-L48-XXXXLM-LPAFL-WD-MVOLT-GZ10-40K-80CRI-E10WCP	LED - 62W 9,782 LUMENS	SURFACE/ SUSPENDED	WITH EMERGENCY BATTERY PACK
K1	LITHONIA	WDGE2 LED-P1-40K-80CRI-VF-MVOLT-SRM-*	LED - 10W 1,251 LUMENS	WALL	* - FINISH BY ARCHITECT
K1E	LITHONIA	WDGE2 LED-P1-40K-80CRI-VF-MVOLT-SRM-EZ0WC-*	LED - 10W 1,251 LUMENS	WALL	WITH EMERGENCY BATTERY PACK * - FINISH BY ARCHITECT
K2	LITHONIA	WDGE2 LED-P3-40K-80CRI-VF-MVOLT-SRM-*	LED - 23 3,132 LUMENS	WALL	* - FINISH BY ARCHITECT
L	LITHONIA	IBG-24000LM-SEF-AFL-GND-MVOLT-GZ10-40K-80CRI-*	LED - 147W 24,490 LUMENS	SURFACE/ SUSPENDED	* - FINISH BY ARCHITECT
LE	LITHONIA	IBG-24000LM-SEF-AFL-GND-MVOLT-GZ10-40K-80CRI-PS30250-*	LED - 147W 24,490 LUMENS	SURFACE/ SUSPENDED	WITH EMERGENCY BATTERY PACK * - FINISH BY ARCHITECT
RH	LITHONIA	ELA-QWP-L0309	LED	WALL	
X	LITHONIA	LHQM-LED-R-HO RO	LED	UNIVERSAL	

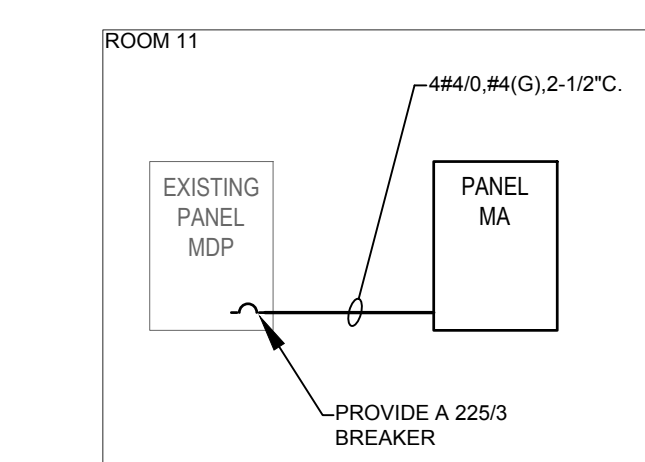

1 SINGLE LINE DIAGRAM - WEST BOLIVAR MIDDLE SCHOOL
Scale: 1/8" = 1'-0"

CIRCUIT NO.	PANEL MA	BREAKER	DESCRIPTION	LUG LOCATION: MAIN BUS: MOUNTING:			BOTTOM FEED MAIN LUGS ONLY SURFACE			PANELBOARD AIC RATING (A): 22,000			
				A	B	C	A	B	C	DESCRIPTION	BREAKER	CIRCUIT NO.	
1	20"	1	REC - (BOYS LOCKER VISITORS - DRINKING FOUNTAIN)	0.5	0.5		0.5	0.5		REC - (BOYS LOCKER HOME - DRINKING FOUNTAIN)	20"	1	2
3	20"	1	REC - (BOYS LOCKER VISITORS - DRINKING FOUNTAIN)							REC - (BOYS LOCKER HOME - DRINKING FOUNTAIN)	20"	1	4
5	30	2	DCU-01b & DSS-01b				1.9	1.9		DCU-02b & DSS-02b	30	2	6
7	-	-	-	1.9	1.9					-	-	-	8
9	20"	1	REC - (GIRLS LOCKER VISITORS - DRINKING FOUNTAIN)				0.5	0.5		REC - (GIRLS LOCKER HOME - DRINKING FOUNTAIN)	20"	1	10
11	20"	1	REC - (GIRLS LOCKER VISITORS - DRINKING FOUNTAIN)				0.5	0.5		REC - (GIRLS LOCKER HOME - DRINKING FOUNTAIN)	20"	1	12
13	30	2	DCU-03b & DSS-03b	1.9	1.9					DCU-04b & DSS-04b	30	2	14
15	-	-	-				1.9	1.9		-	-	-	16
17	20	1	LTS - (EXTERIOR FRONT CANOPY)					0.2	0.1	LTS - (EXTERIOR BACK CANOPY)	20	1	18
19	20	1	SPARE							SPARE	20	1	20
21	20	1	SPARE	0.0	0.0		0.0	0.0		SPARE	20	1	22
23	20	1	SPARE				0.0	0.0		SPARE	20	1	24
25	20	1	SPARE	0.0	0.0					SPARE	20	1	26
27	20	1	SPARE				0.0	0.0		SPARE	20	1	28
29	20	1	SPARE				0.0	0.0		SPARE	20	1	30
31	20	1	SPARE	0.0	0.0					SPARE	20	1	32
33	20	1	SPARE				0.0	0.0		SPARE	20	1	34
35	20	1	SPARE							SPARE	20	1	36
37	20	1	SPARE	0.0	0.0		0.0	0.0		SPARE	20	1	38
39	20	1	SPARE				0.0	0.0		SPARE	20	1	40
41	20	1	SPARE				0.0	0.0		SPARE	20	1	42
43	20	1	SPARE	0.0	0.0					SPARE	20	1	44
45	20	1	SPARE				0.0	0.0		SPARE	20	1	46
47	20	1	SPARE				0.0	0.0		SPARE	20	1	48
49	20	1	SPARE	0.0	0.0					SPARE	20	1	50
51	20	1	SPARE				0.0	0.0		SPARE	20	1	52
53	20	1	SPARE							SPARE	20	1	54
TOTAL				8.7			5.8		5.1	*GFCI BREAKER			

SHEET INDEX

Mark	Description
E-000	ELECTRICAL LEGEND
E-100	OVERALL LIGHTING PLAN - WEST BOLIVAR ELEMENTARY SCHOOL
E-101	PARTIAL LIGHTING PLAN - WEST BOLIVAR ELEMENTARY SCHOOL - PART A, B, C
E-102	PARTIAL LIGHTING PLAN - WEST BOLIVAR ELEMENTARY SCHOOL - PART D, E, F
E-103	OVERALL LIGHTING PLAN - WEST BOLIVAR MIDDLE SCHOOL
E-104	PARTIAL LIGHTING PLAN - WEST BOLIVAR MIDDLE SCHOOL - PART A
E-105	PARTIAL LIGHTING PLAN - WEST BOLIVAR MIDDLE SCHOOL - PART B
E-106	PARTIAL LIGHTING PLAN - WEST BOLIVAR MIDDLE SCHOOL - PART C
E-107	OVERALL LIGHTING PLAN - MCEVANS ELEMENTARY SCHOOL
E-108	PARTIAL LIGHTING PLAN - MCEVANS ELEMENTARY SCHOOL - PART A
E-109	PARTIAL LIGHTING PLAN - MCEVANS ELEMENTARY SCHOOL - PART B
E-110	PARTIAL LIGHTING PLAN - MCEVANS ELEMENTARY SCHOOL - PART C
E-111	PARTIAL LIGHTING PLAN - MCEVANS ELEMENTARY SCHOOL - PART D
ED-100	OVERALL DEMOLITION PLAN - WEST BOLIVAR ELEMENTARY SCHOOL
ED-101	PARTIAL DEMOLITION PLAN - WEST BOLIVAR ELEMENTARY SCHOOL - PART A, B, C
ED-102	PARTIAL DEMOLITION PLAN - WEST BOLIVAR ELEMENTARY SCHOOL - PART D, E, F
ED-103	OVERALL DEMOLITION PLAN - WEST BOLIVAR MIDDLE SCHOOL
ED-104	PARTIAL DEMOLITION PLAN - WEST BOLIVAR MIDDLE SCHOOL - PART A
ED-105	PARTIAL DEMOLITION PLAN - WEST BOLIVAR MIDDLE SCHOOL - PART B
ED-106	PARTIAL DEMOLITION PLAN - WEST BOLIVAR MIDDLE SCHOOL - PART C
ED-107	OVERALL DEMOLITION PLAN - MCEVANS ELEMENTARY SCHOOL
ED-108	PARTIAL DEMOLITION PLAN - MCEVANS ELEMENTARY SCHOOL - PART A
ED-109	PARTIAL DEMOLITION PLAN - MCEVANS ELEMENTARY SCHOOL - PART B
ED-110	PARTIAL DEMOLITION PLAN - MCEVANS ELEMENTARY SCHOOL - PART C
ED-111	PARTIAL DEMOLITION PLAN - MCEVANS ELEMENTARY SCHOOL - PART D

ELECTRICAL LEGEND

GENERAL NOTES

- ALL EQUIPMENT AND DEVICES ARE TO BE FLUSH MOUNTED UNLESS OTHERWISE NOTED.
- DEVICES NOTED AS "GF" SHALL BE GROUND FAULT CIRCUIT INTERRUPTING DEVICES.
- DEVICES NOTED AS "WP" SHALL BE WEATHERPROOF WHILE-IN-USE.
- PROVIDE UNSWITCHED POWER TO EMERGENCY BATTERY PACKS.

LUMINAIRES (See Light Fixture Schedule)
NOTE: THE NUMBER INSIDE THE CIRCLE IS THE CIRCUIT NUMBER. THE LETTER BESIDE THE SYMBOL IS THE FIXTURE TYPE DESCRIBED IN THE LIGHT FIXTURE SCHEDULE.

CONDUIT AND WIRING

CONDUCTORS IN CONDUIT CONCEALED WITHIN WALL OR CEILING. TIC MARKS INDICATE NUMBER OF CONDUCTORS. THE EQUIPMENT GROUNDING CONDUCTOR IS NOT SHOWN, BUT SHALL BE PROVIDED. SIZE THE EQUIPMENT GROUNDING CONDUCTOR AND THE CONDUIT PER THE NEC. THE ABSENCE OF TIC MARKS SIGNIFIES THAT TWO CONDUCTORS PLUS AN EQUIPMENT GROUNDING CONDUCTOR SHOULD BE PROVIDED. FOR EXAMPLE, THE MARKINGS TO THE LEFT SIGNIFY THAT THREE CONDUCTORS PLUS AN EQUIPMENT GROUNDING CONDUCTOR SHOULD BE PROVIDED.

THE TEXT INSIDE THE ARC INDICATES THE AWG SIZE OF THE CONDUCTORS THAT SHALL BE RUN IN THE CONDUIT. THE ABSENCE OF TEXT SIGNIFIES THAT THE CONDUCTORS SHOULD BE #12 AWG.

CIRCUITRY RUN IN STRAIGHT LINE SEGMENTS SIGNIFIES EXPOSED SURFACE-MOUNTED RACEWAY (SEE SPECIFICATIONS).

CONDUCTORS IN CONDUIT CONCEALED BELOW GRADE OR FLOOR. TIC MARKS INDICATE NUMBER OF CONDUCTORS. THE EQUIPMENT GROUNDING CONDUCTOR IS NOT SHOWN, BUT SHALL BE PROVIDED. SIZE THE EQUIPMENT GROUNDING CONDUCTOR AND THE CONDUIT PER THE NEC. THE ABSENCE OF TIC MARKS SIGNIFIES THAT TWO CONDUCTORS PLUS AN EQUIPMENT GROUNDING CONDUCTOR SHOULD BE PROVIDED. THE MARKINGS TO THE LEFT SIGNIFY THAT THREE CONDUCTORS PLUS AN EQUIPMENT GROUNDING CONDUCTOR SHOULD BE PROVIDED.

HOMERUN TO PANELBOARD. ARC DENOTES CONCEALED CIRCUITRY. TEXT DENOTES PANELBOARD NAME WITH CIRCUIT NUMBER. DEVICES HAVING CIRCUIT NUMBERS LOCATED BESIDE THEM MAY NOT SHOW THE CIRCUIT NUMBERS AT THE HOMERUN ARROWS.

PARTIAL HOMERUN TO PANELBOARD. COMBINE ALL PARTIAL HOMERUNS THAT ARE ON THE SAME CIRCUIT IN A JUNCTION BOX PRIOR TO ENTERING THE PANELBOARD.

LOW VOLTAGE CONDUCTORS USED FOR MOTION DETECTOR CIRCUITRY. SEE MANUFACTURER'S RECOMMENDATIONS FOR CONDUCTOR REQUIREMENTS.

VOLTAGE DROP CHART FOR 20A, 1Ø CIRCUITS

Voltage	Circuit Length	Conductor Size (AWG)
120	< 50'	#12
120	> 50'	#10
120	> 90'	#8
120	> 140'	#6
277	< 130'	#12
277	> 130'	#10
277	> 200'	#8
277	> 330'	#6

VOLTAGE DROP CHART NOTES:
1) CIRCUIT SIZES INDICATED ON THE DRAWINGS ARE MINIMUM REQUIREMENTS. REFER TO THIS CHART FOR UPSIZING CONDUCTORS AS NEEDED.
2) DO NOT CONNECT CONDUCTORS LARGER THAN #10 DIRECTLY TO A RECEPTACLE OR A SWITCH. PROVIDE A JUNCTION BOX TO DOWNSIZE THE CONDUCTOR TO #12 AT THE DEVICE.
3) FOR CIRCUITS LONGER THAN THOSE LISTED ABOVE, CONSULT WITH THE ENGINEER FOR CONDUCTOR SIZES.

MISCELLANEOUS

- CEILING MOUNTED JUNCTION BOX.
- WALL MOUNTED JUNCTION BOX.
- FLEXIBLE CONNECTION TO EQUIPMENT.

SWITCHES

- SINGLE-POLE, SINGLE-THROW SWITCH. MOUNT CENTERLINE OF BOX AT 45"A.F.F. UNLESS NOTED OTHERWISE.
- DOUBLE-POLE, SINGLE-THROW, 30 AMP SWITCH. MOUNT CENTERLINE OF BOX AT 45"A.F.F. UNLESS NOTED OTHERWISE.
- THREE-WAY SWITCH. MOUNT CENTERLINE OF BOX AT 45"A.F.F. UNLESS NOTED OTHERWISE.
- LED DIMMER EQUAL TO LEVITON #P710-LFZ MOUNT CENTERLINE OF BOX AT 45"A.F.F. UNLESS NOTED OTHERWISE.
- THREE WAY LED DIMMER EQUAL TO LEVITON #P710-LFZ MOUNT CENTERLINE OF BOX AT 45"A.F.F. UNLESS NOTED OTHERWISE.
- AUTOMATIC WALL SWITCH, SENSORSWITCH #WSD-PDT OR APPROVED EQUAL. MOUNT CENTERLINE OF BOX AT 45" A.F.F. UNLESS NOTED OTHERWISE.
- AUTOMATIC WALL SWITCH WITH INTEGRAL 0-10V DIMMER, SENSORSWITCH #WSX-PDT-D-VA OR APPROVED EQUAL. MOUNT CENTERLINE OF BOX AT 45"A.F.F. UNLESS NOTED OTHERWISE.
- HORSEPOWER RATED SWITCH WITH THERMAL OVERLOADS (MANUAL MOTOR STARTER).
- PASSIVE INFRARED AND ULTRASONIC DUAL TECHNOLOGY OCCUPANCY SENSOR WITH A 12" RADIAL COVERAGE. CEILING MOUNTED. SENSORSWITCH #OM-PDT-9 OR APPROVED EQUAL.
- PASSIVE INFRARED AND ULTRASONIC DUAL TECHNOLOGY OCCUPANCY SENSOR WITH A 28" RADIAL COVERAGE. CEILING MOUNTED. SENSORSWITCH #OM-PDT-10 OR APPROVED EQUAL.
- PASSIVE INFRARED AND ULTRASONIC DUAL TECHNOLOGY OCCUPANCY SENSOR WITH A 2000 SQ. FT. COVERAGE. MOUNT IMMEDIATELY BELOW CEILING. SENSORSWITCH #WV-PDT-16 OR APPROVED EQUAL.
- POWER PACK MOUNTED ABOVE CEILING. SENSORSWITCH #PP20 OR APPROVED EQUAL.

GEAR

- FUSED DISCONNECT SWITCH. TEXT INDICATES AMPACITY/NUMBER OF POLES/ENCLOSURE TYPE; F-(RATING OF FUSES).
- NON-FUSED DISCONNECT SWITCH. TEXT INDICATES AMPACITY/NUMBER OF POLES/ENCLOSURE TYPE.
- PANELBOARD.

COMMUNICATIONS

- DATA OUTLET MOUNTED 18" A.F.F. TO CENTERLINE OF BOX UNLESS NOTED OTHERWISE.
- DATA OUTLET MOUNTED WITH BOTTOM OF BOX 2" ABOVE COUNTER BACKSPLASH, WHERE THERE IS NO BACKSPLASH MOUNT 6" ABOVE COUNTER. WHERE TELEPHONE/DATA OUTLET IS SHOWN IN AN AREA WITH NO COUNTER, MOUNT 45" A.F.F. TO CENTERLINE OF BOX.

RECEPTACLES


- DOUBLE DUPLEX RECEPTACLE, NEMA 5-20R, ONE COVER PLATE, MOUNTED 18" A.F.F. TO CENTERLINE OF BOX UNLESS NOTED OTHERWISE.
- DOUBLE DUPLEX RECEPTACLE, NEMA 5-20R, ONE COVER PLATE, MOUNTED WITH BOTTOM OF BOX 2" ABOVE COUNTER BACKSPLASH, WHERE THERE IS NO BACKSPLASH MOUNT 6" ABOVE COUNTER. WHERE RECEPTACLE IS SHOWN IN AN AREA WITH NO COUNTER, MOUNT 45"A.F.F. TO CENTERLINE OF BOX.

MASTER DEMOLITION KEYED NOTES


Mark	Description
①	FIELD VERIFY LOCATION AND NUMBER OF EXISTING SWITCHES/CONTROLS CONTROLLING LIGHTING FIXTURES AND CEILING FANS. EXISTING LIGHTING FIXTURE SWITCHES SHALL BE DEMOLISHED AND REPLACED WITH A NEW SWITCHING DEVICE THAT SHALL CONTROL. ALL LIGHTING FIXTURES IN THE AREA. EXISTING FAN SWITCH SHALL BE DEMOLISHED. IT IS THE INTENT TO RE-USE ONE OF THE EXISTING SWITCH BOXES IF NO CEILING FAN IS PRESENT. UN-USED BOXES SHALL BE COVERED WITH A BLANK PLATE. SEE LIGHTING PLANS FOR NEW SWITCHING DEVICES.
②	FIXTURE MOUNTED ABOVE BLEACHERS
③	ALTERNATE #2 (WEST BOLIVAR HIGH & MCEVANS) ALTERNATE #5 (WEST BOLIVAR ELEMENTARY) DRINKING FOUNTAIN SHALL BE DEMOLISHED AND REPLACED WITH A NEW DRINKING FOUNTAIN. REPLACE EXISTING RECEPTACLE WITH A NEW GFI RECEPTACLE AND CONNECT BACK TO THE ORIGINAL CIRCUITRY. FIELD VERIFY ALL LOCATIONS OF EXISTING DRINKING FOUNTAINS, THOSE THAT ARE NOT SHOWN ON THE PLAN SHALL BE REPLACED IN THE SAME MANNER.
④	SEE GENERAL NOTE #3 ON LIGHTING PLANS FOR SWITCHING INFORMATION.
NOTE:	IF A KEYED NOTE IS NOT SHOWN ON A DRAWING, THEN THE KEYED NOTE SHALL BE IGNORED FOR THAT PARTICULAR DRAWING. THIS SHALL DIFFER FROM DRAWING TO DRAWING.

GENERAL NOTES

Mark	Description
1	DEMOLISH ALL EXISTING TVS AND ASSOCIATED CABLING/CONDUIT IN EACH CLASSROOM.

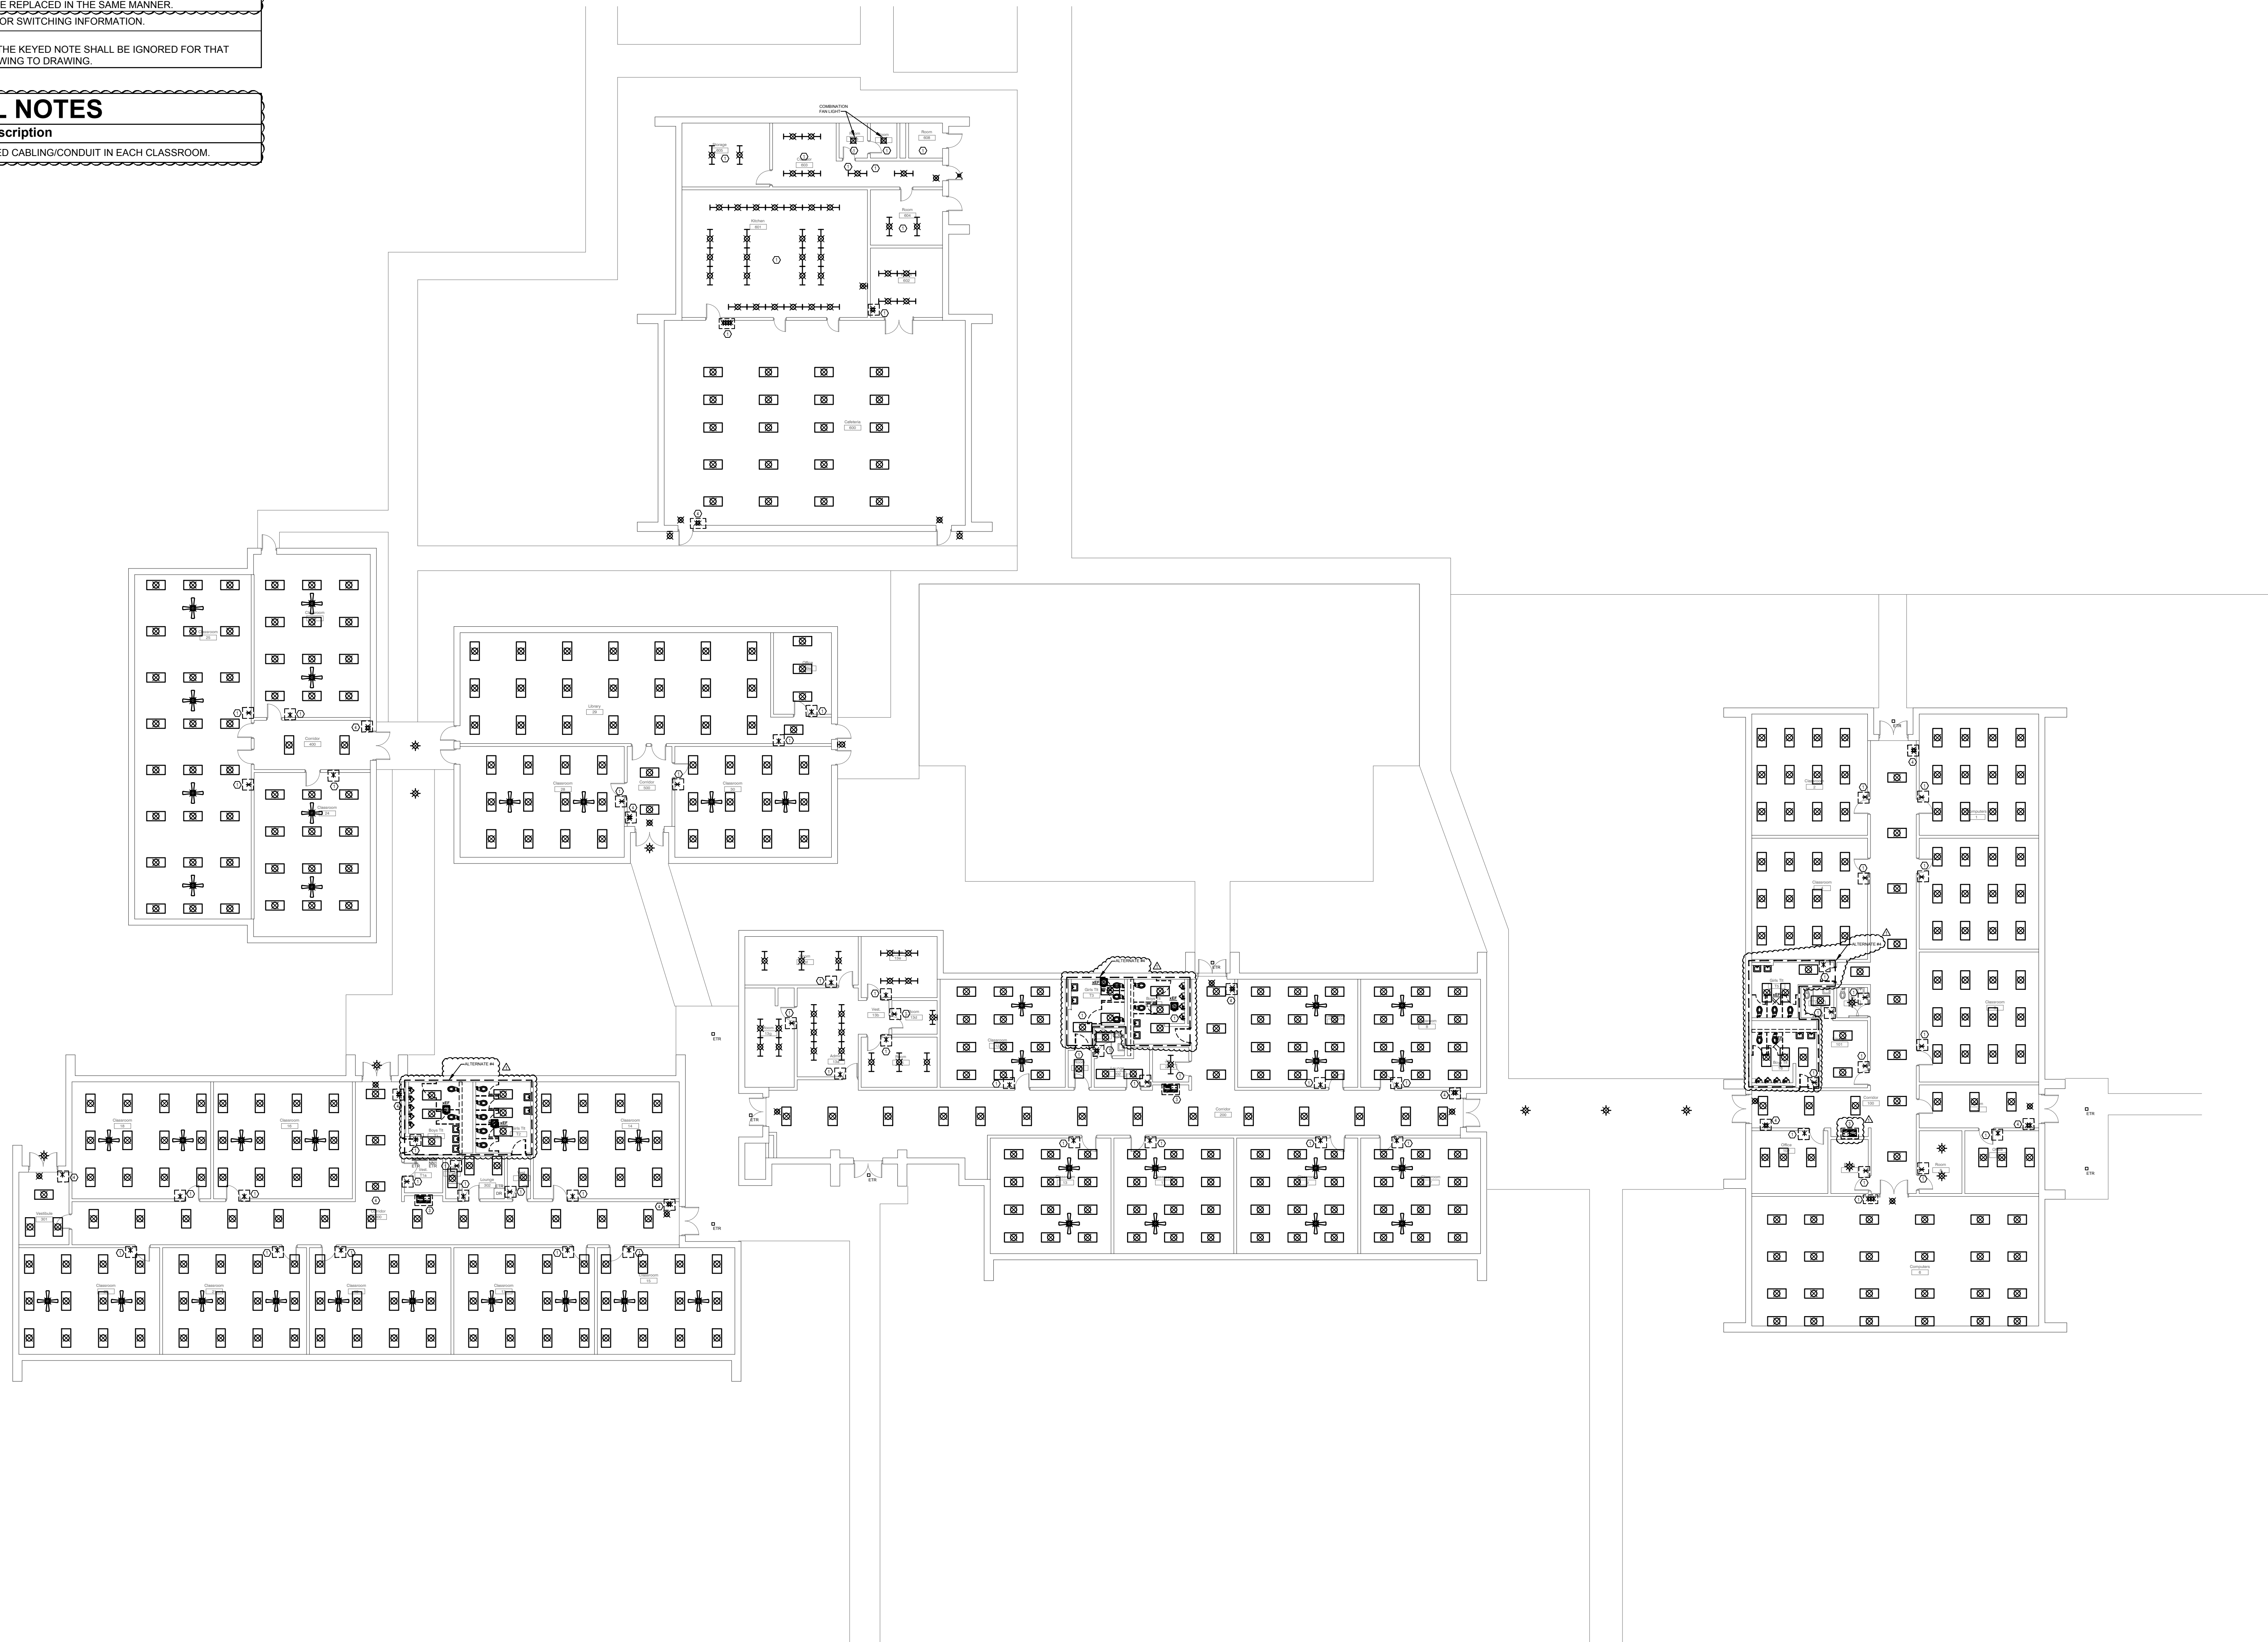


① OVERALL DEMOLITION PLAN - WEST BOLIVAR ELEMENTARY SCHOOL - ALTERNATE #5
 ED-100 Scale: 1/16" = 1'-0"

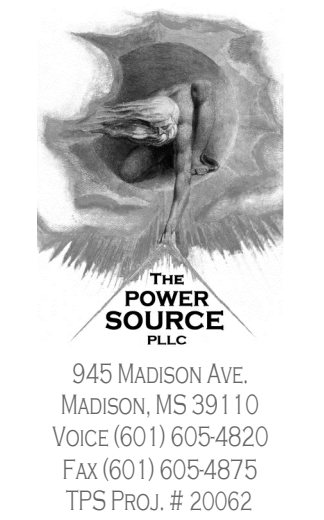

945 MADISON AVE.
 MADISON, MS 39110
 VOICE (601) 605-4820
 FAX (601) 605-4875
 TPO PROJ. # 20062

AN ASSOCIATION
DALE BAILEY
 JACKSON • BILOXI

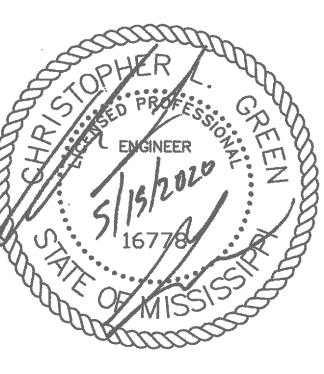

**West Bolivar Consolidated School
 District Renovation Project**





100%
 Construction
 Documents

Project No	20018
Date	2020-05-15
Drawn	FAB
Checked	CLG
Revisions	Rev Date
ADD#2	2020-06-12


West Bolivar Elementary
ED-100
 OVERALL DEMOLITION
 PLAN

MASTER DEMOLITION KEYED NOTES	
Mark	Description
①	FIELD VERIFY LOCATION AND NUMBER OF EXISTING SWITCHES CONTROLLING LIGHTING FIXTURES AND CEILING FANS. EXISTING LIGHTING FIXTURE SWITCHES SHALL BE DEMOLISHED AND REPLACED WITH A NEW SWITCHING DEVICE THAT SHALL CONTROL ALL LIGHTING FIXTURES IN THE AREA. EXISTING FAN SWITCH SHALL BE DEMOLISHED. IT IS THE INTENT TO RE-USE ONE OF THE EXISTING SWITCH BOXES IF NO CEILING FAN IS PRESENT. UNUSED BOXES SHALL BE COVERED WITH A BLANK PLATE. SEE LIGHTING PLANS FOR NEW SWITCHING DEVICES.
②	FIXTURE MOUNTED ABOVE BLEACHERS.
③	ALTERNATE #2 (WEST BOLIVAR HIGH & MCEVANS) ALTERNATE #5 (WEST BOLIVAR ELEMENTARY) DRINKING FOUNTAIN SHALL BE DEMOLISHED AND REPLACED WITH A NEW DRINKING FOUNTAIN. REPLACE EXISTING RECEPTACLE WITH A NEW GFI RECEPTACLE AND CONNECT BACK TO THE ORIGINAL CIRCUITRY. FIELD VERIFY ALL LOCATIONS OF EXISTING DRINKING FOUNTAINS, THOSE THAT ARE NOT SHOWN ON THE PLAN SHALL BE REPLACED IN THE SAME MANNER.
④	SEE GENERAL NOTE #3 ON LIGHTING PLANS FOR SWITCHING INFORMATION.
NOTE:	IF A KEYED NOTE IS NOT SHOWN ON A DRAWING, THEN THE KEYED NOTE SHALL BE IGNORED FOR THAT PARTICULAR DRAWING. THIS SHALL DIFFER FROM DRAWING TO DRAWING.

GENERAL NOTES	
Mark	Description
1.	DEMOLISH ALL EXISTING TV'S AND ASSOCIATED CABLING/CONDUIT IN EACH CLASSROOM.

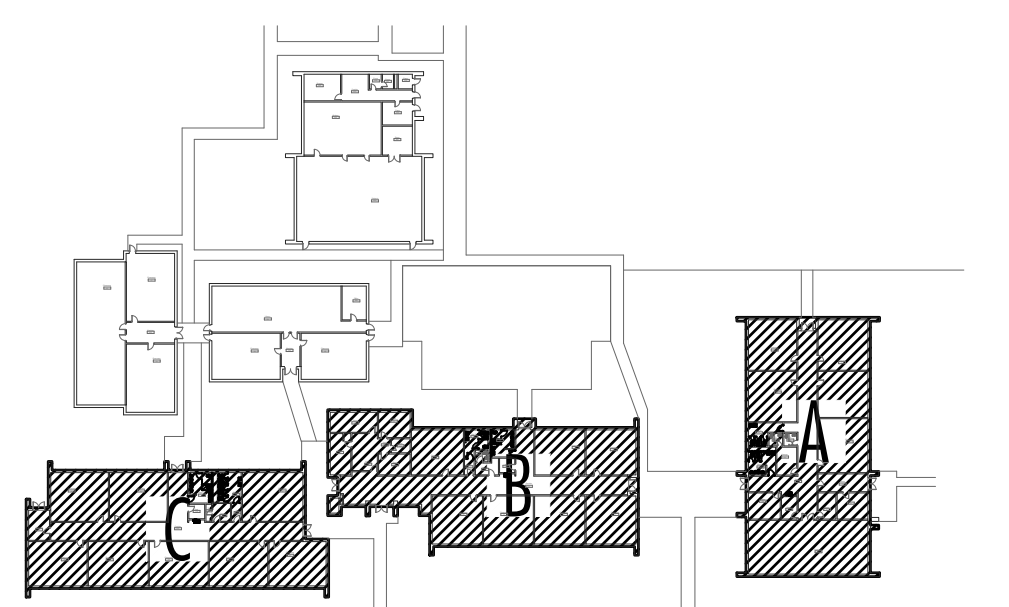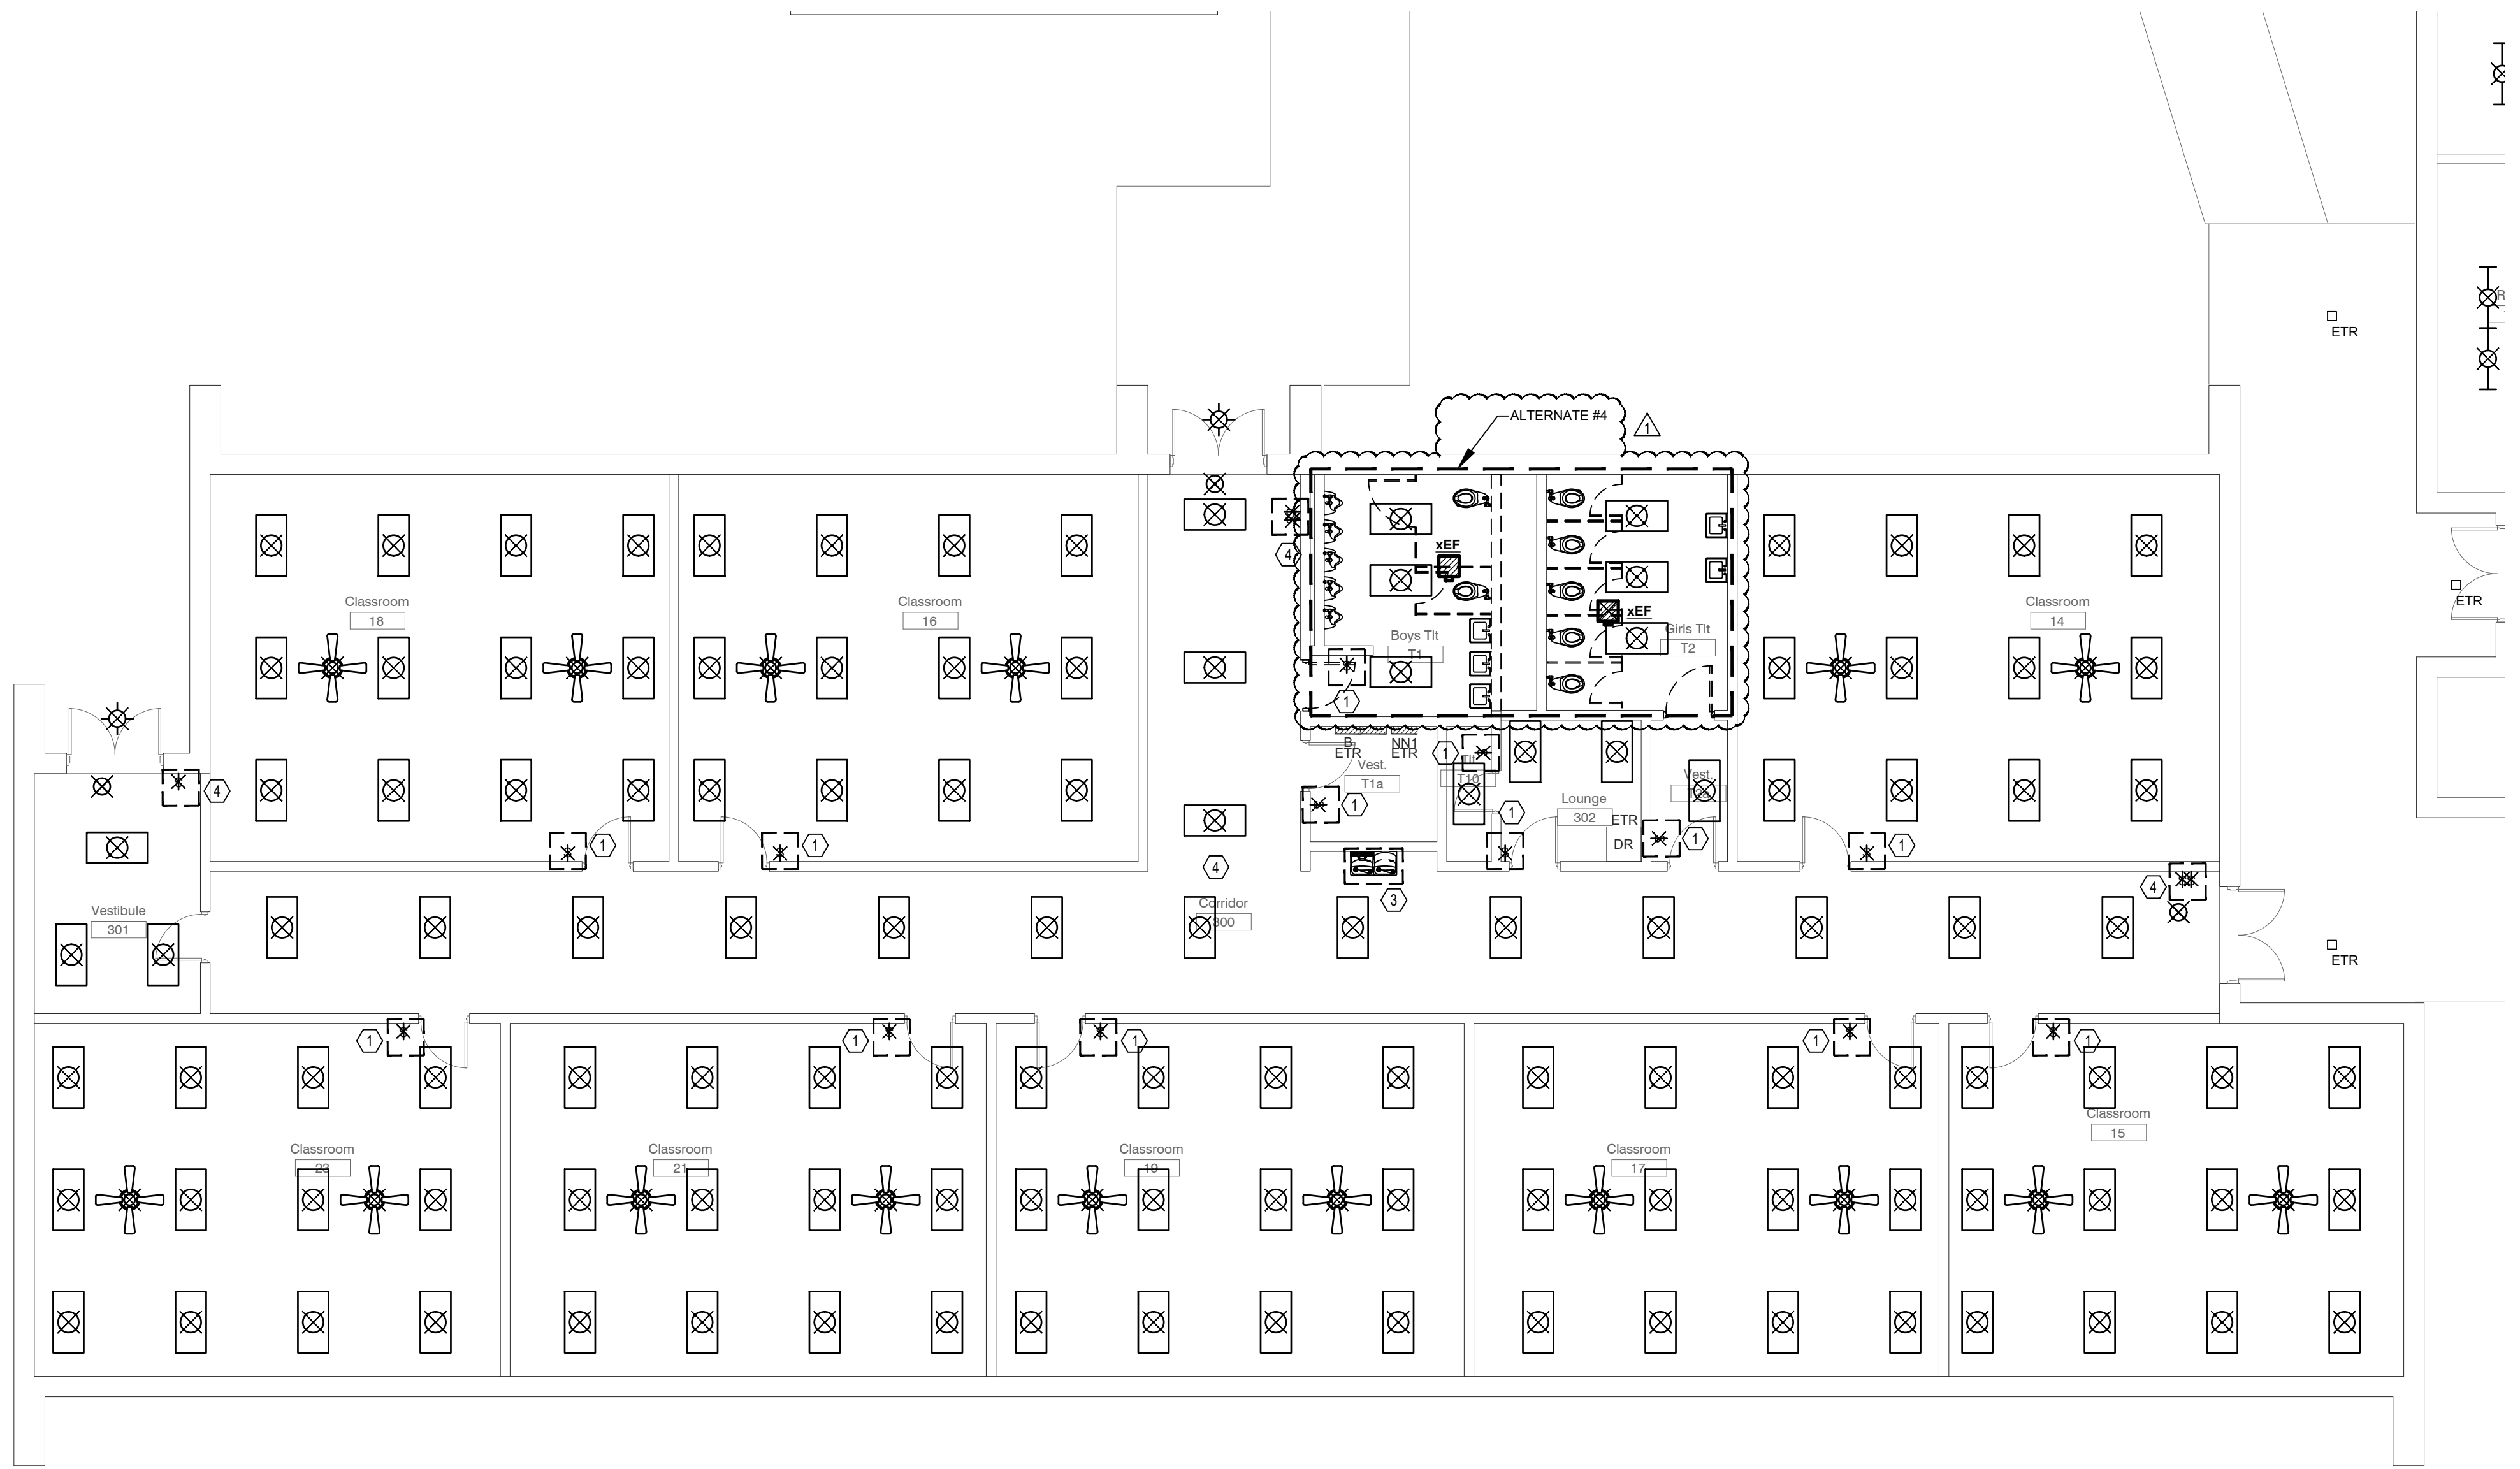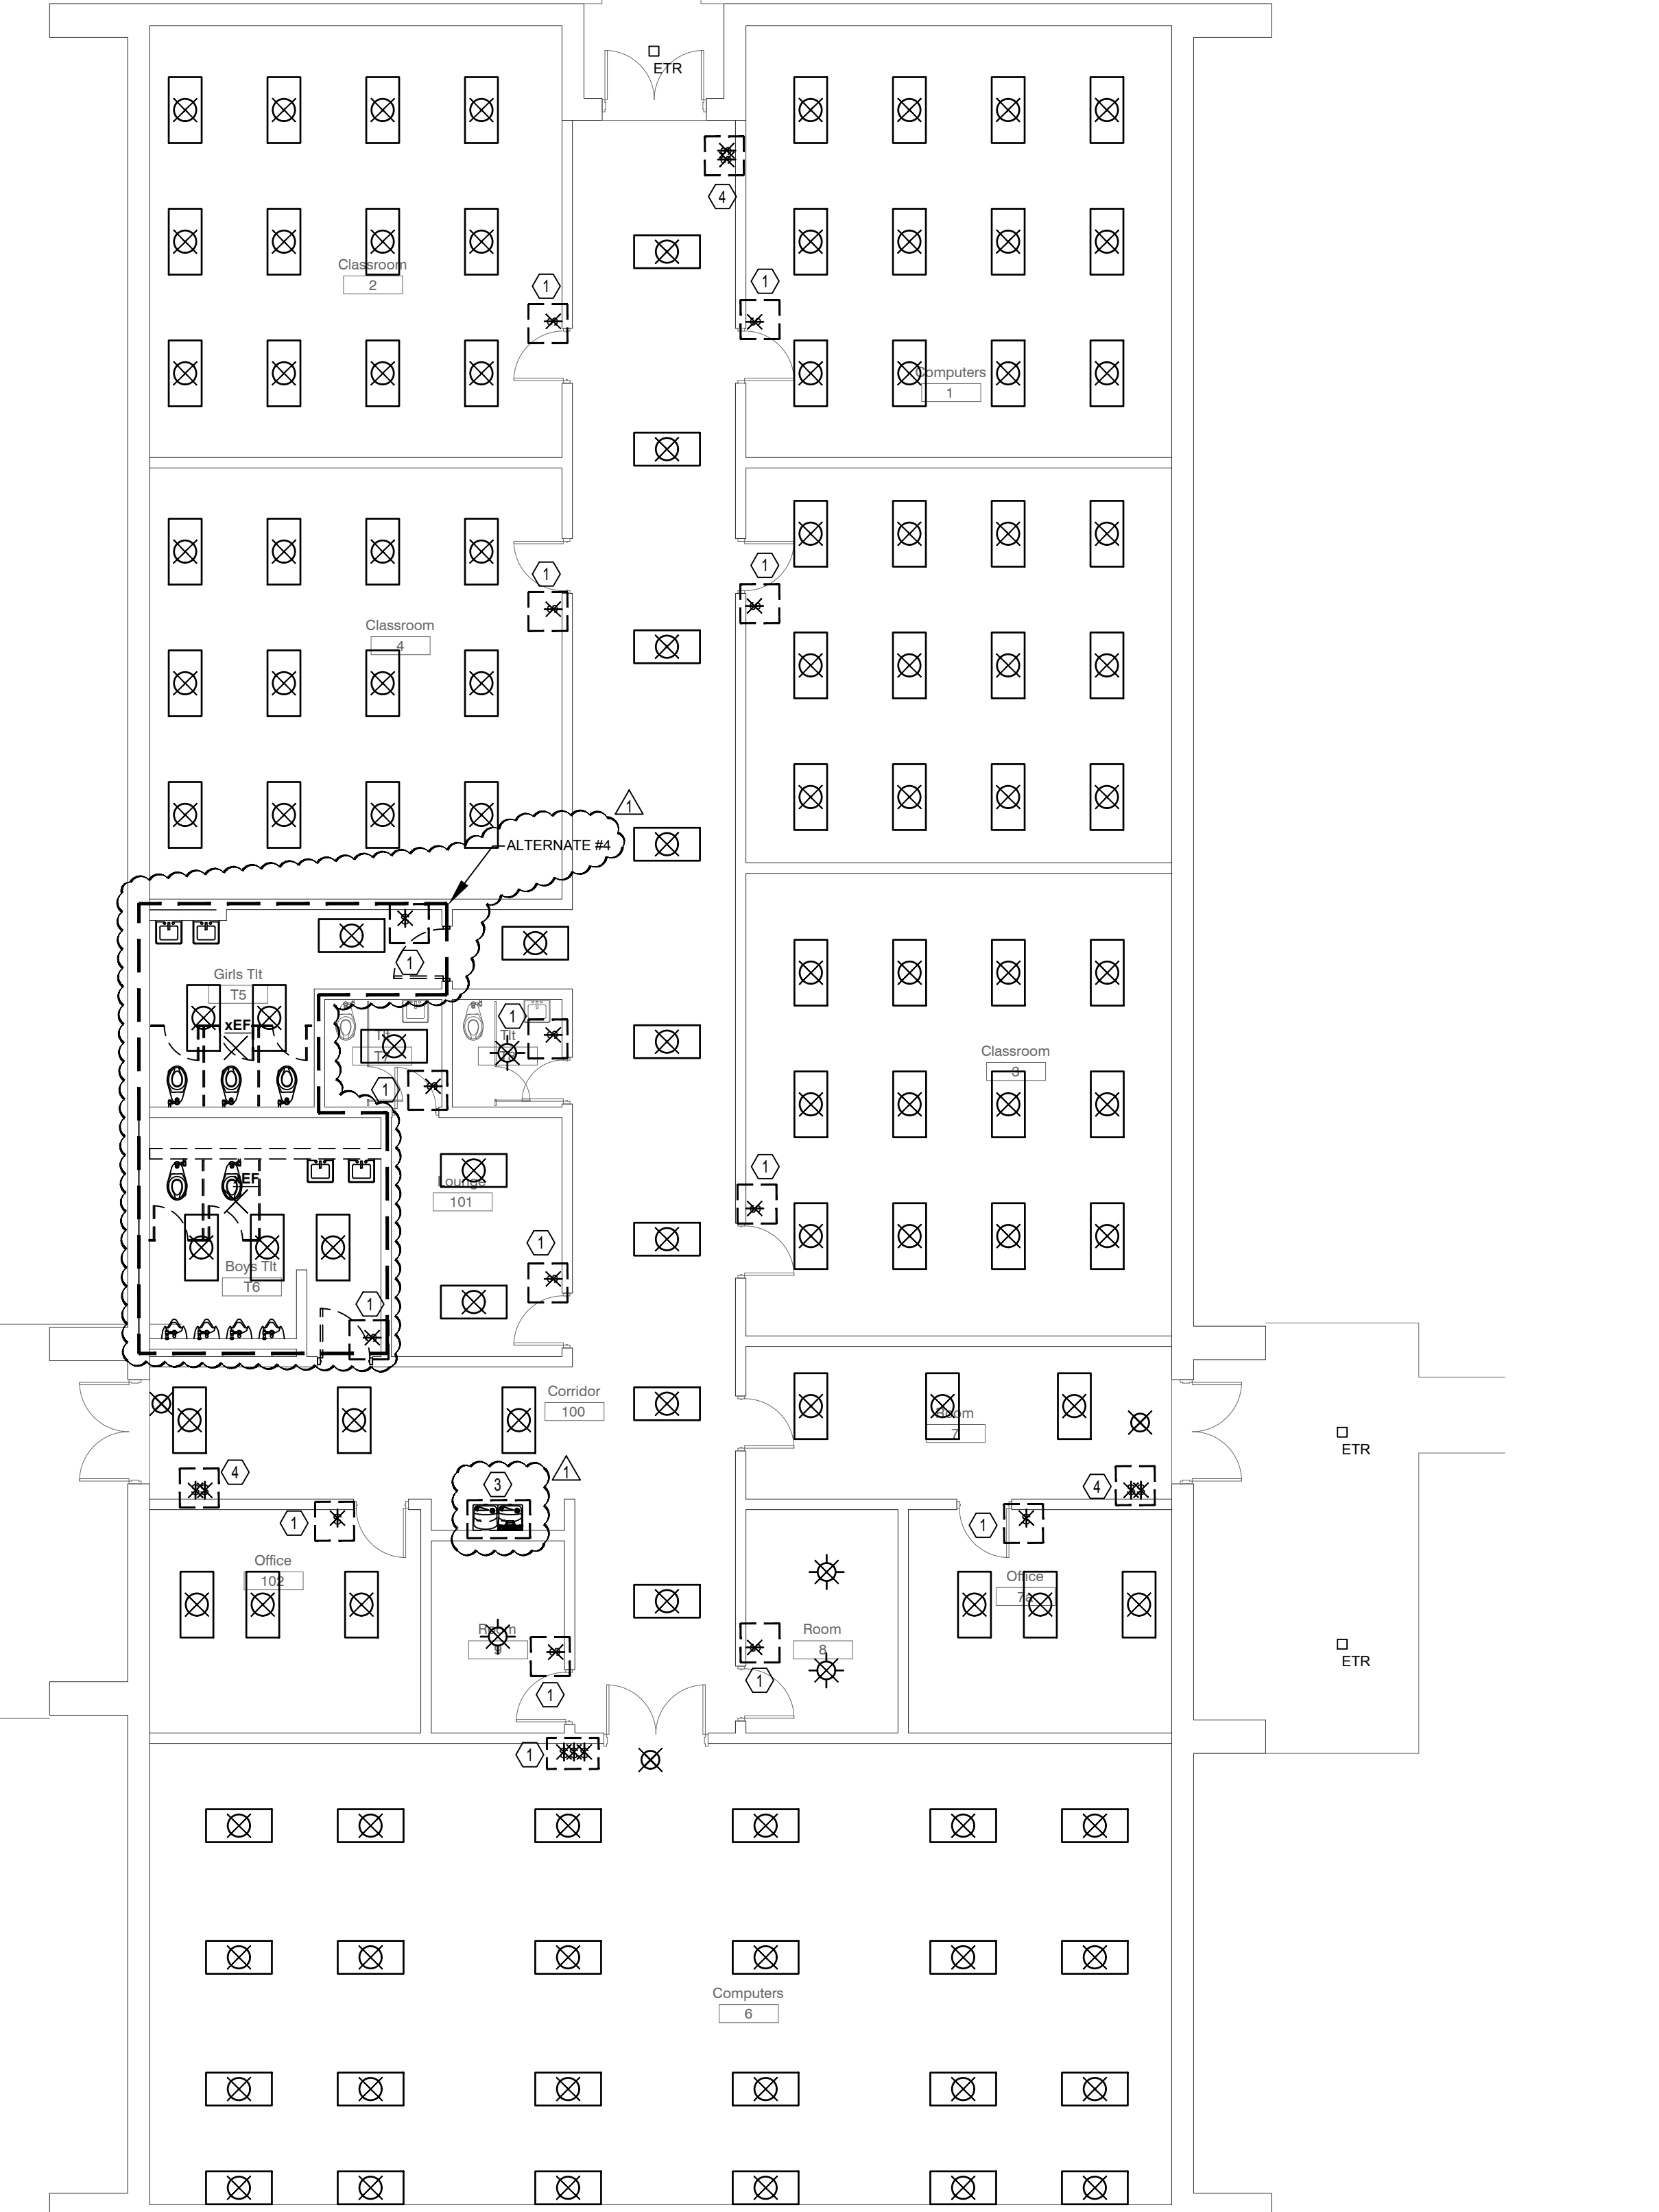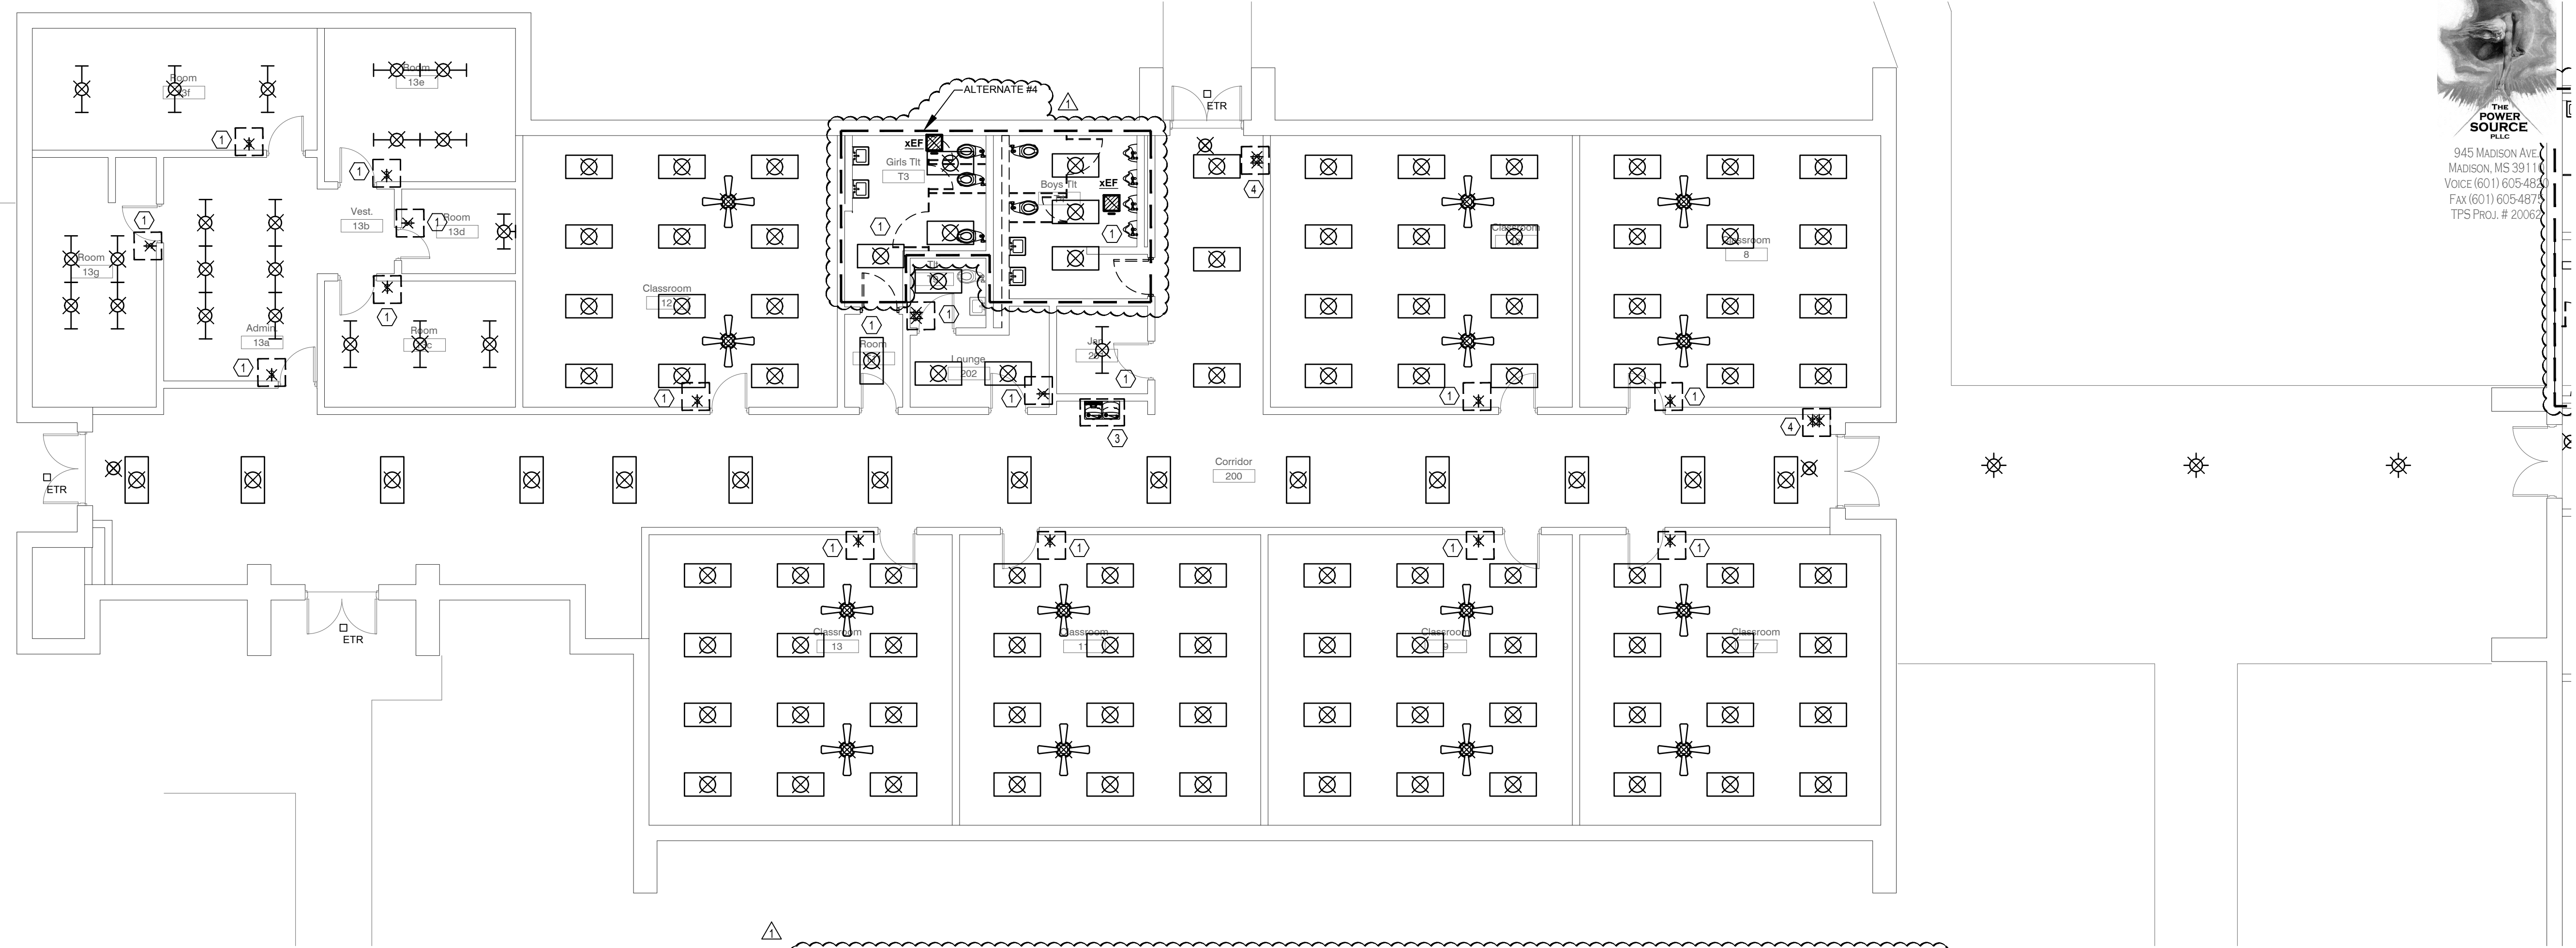


KEY PLAN - ELEMENTARY SCHOOL

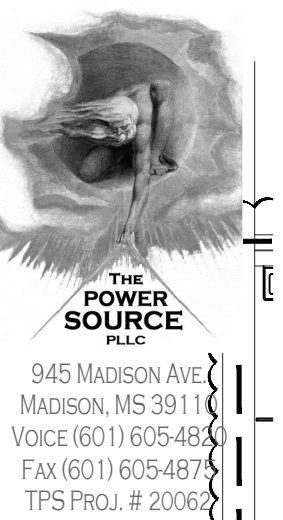

945 MADISON AVE

AN ASSOCIATION
M I S S I S S I P P I

DALE BAILEY
JACKSON • BILOXI

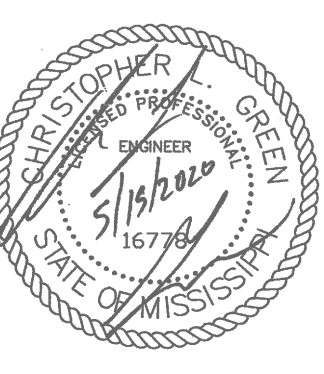

West Bolivar Consolidated School
District Renovation Project

100%
Construction
Documents

Project No	20018
Date	2020-05-15
Drawn	FAB
Checked	CLG
Revisions	Rev Date
ADD#2	2020-06-12


West Bolivar Elementary
ED-101
PARTIAL DEMOLITION
PLAN - PART A, B, C

MASTER DEMOLITION KEYED NOTES


Mark	Description
①	FIELD VERIFY LOCATION AND NUMBER OF EXISTING SWITCHES CONTROLLING LIGHTING FIXTURES AND CEILING FANS. EXISTING LIGHTING FIXTURE SWITCHES SHALL BE DEMOLISHED AND REPLACED WITH A NEW SWITCHING DEVICE THAT SHALL CONTROL ALL LIGHTING FIXTURES IN THE AREA. EXISTING FAN SWITCH SHALL BE DEMOLISHED. IT IS THE INTENT TO RE-USE ONE OF THE EXISTING SWITCH BOXES IF NO CEILING FAN IS PRESENT. UN-USED BOX/BOXES SHALL BE COVERED WITH A BLANK PLATE. SEE LIGHTING PLANS FOR NEW SWITCHING DEVICES.
②	FIXTURE MOUNTED ABOVE BLEACHERS.
③	ALTERNATE #2: (WEST BOLIVAR HIGH & MCEVANS) ALTERNATE #5: (WEST BOLIVAR ELEMENTARY) DRINKING FOUNTAIN SHALL BE DEMOLISHED AND REPLACED WITH A NEW DRINKING FOUNTAIN. REPLACE EXISTING RECEPTACLE WITH A NEW GFI RECEPTACLE AND CONNECT BACK TO THE ORIGINAL CIRCUITRY. FIELD VERIFY ALL LOCATIONS OF EXISTING DRINKING FOUNTAINS, THOSE THAT ARE NOT SHOWN ON THE PLAN SHALL BE REPLACED IN THE SAME MANNER.
④	SEE GENERAL NOTE #3 ON LIGHTING PLANS FOR SWITCHING INFORMATION.
NOTE:	IF A KEYED NOTE IS NOT SHOWN ON A DRAWING, THEN THE KEYED NOTE SHALL BE IGNORED FOR THAT PARTICULAR DRAWING. THIS SHALL DIFFER FROM DRAWING TO DRAWING.

GENERAL NOTES


Mark	Description
1.	DEMOLISH ALL EXISTING TV'S AND ASSOCIATED CABLING/CONDUIT IN EACH CLASSROOM.

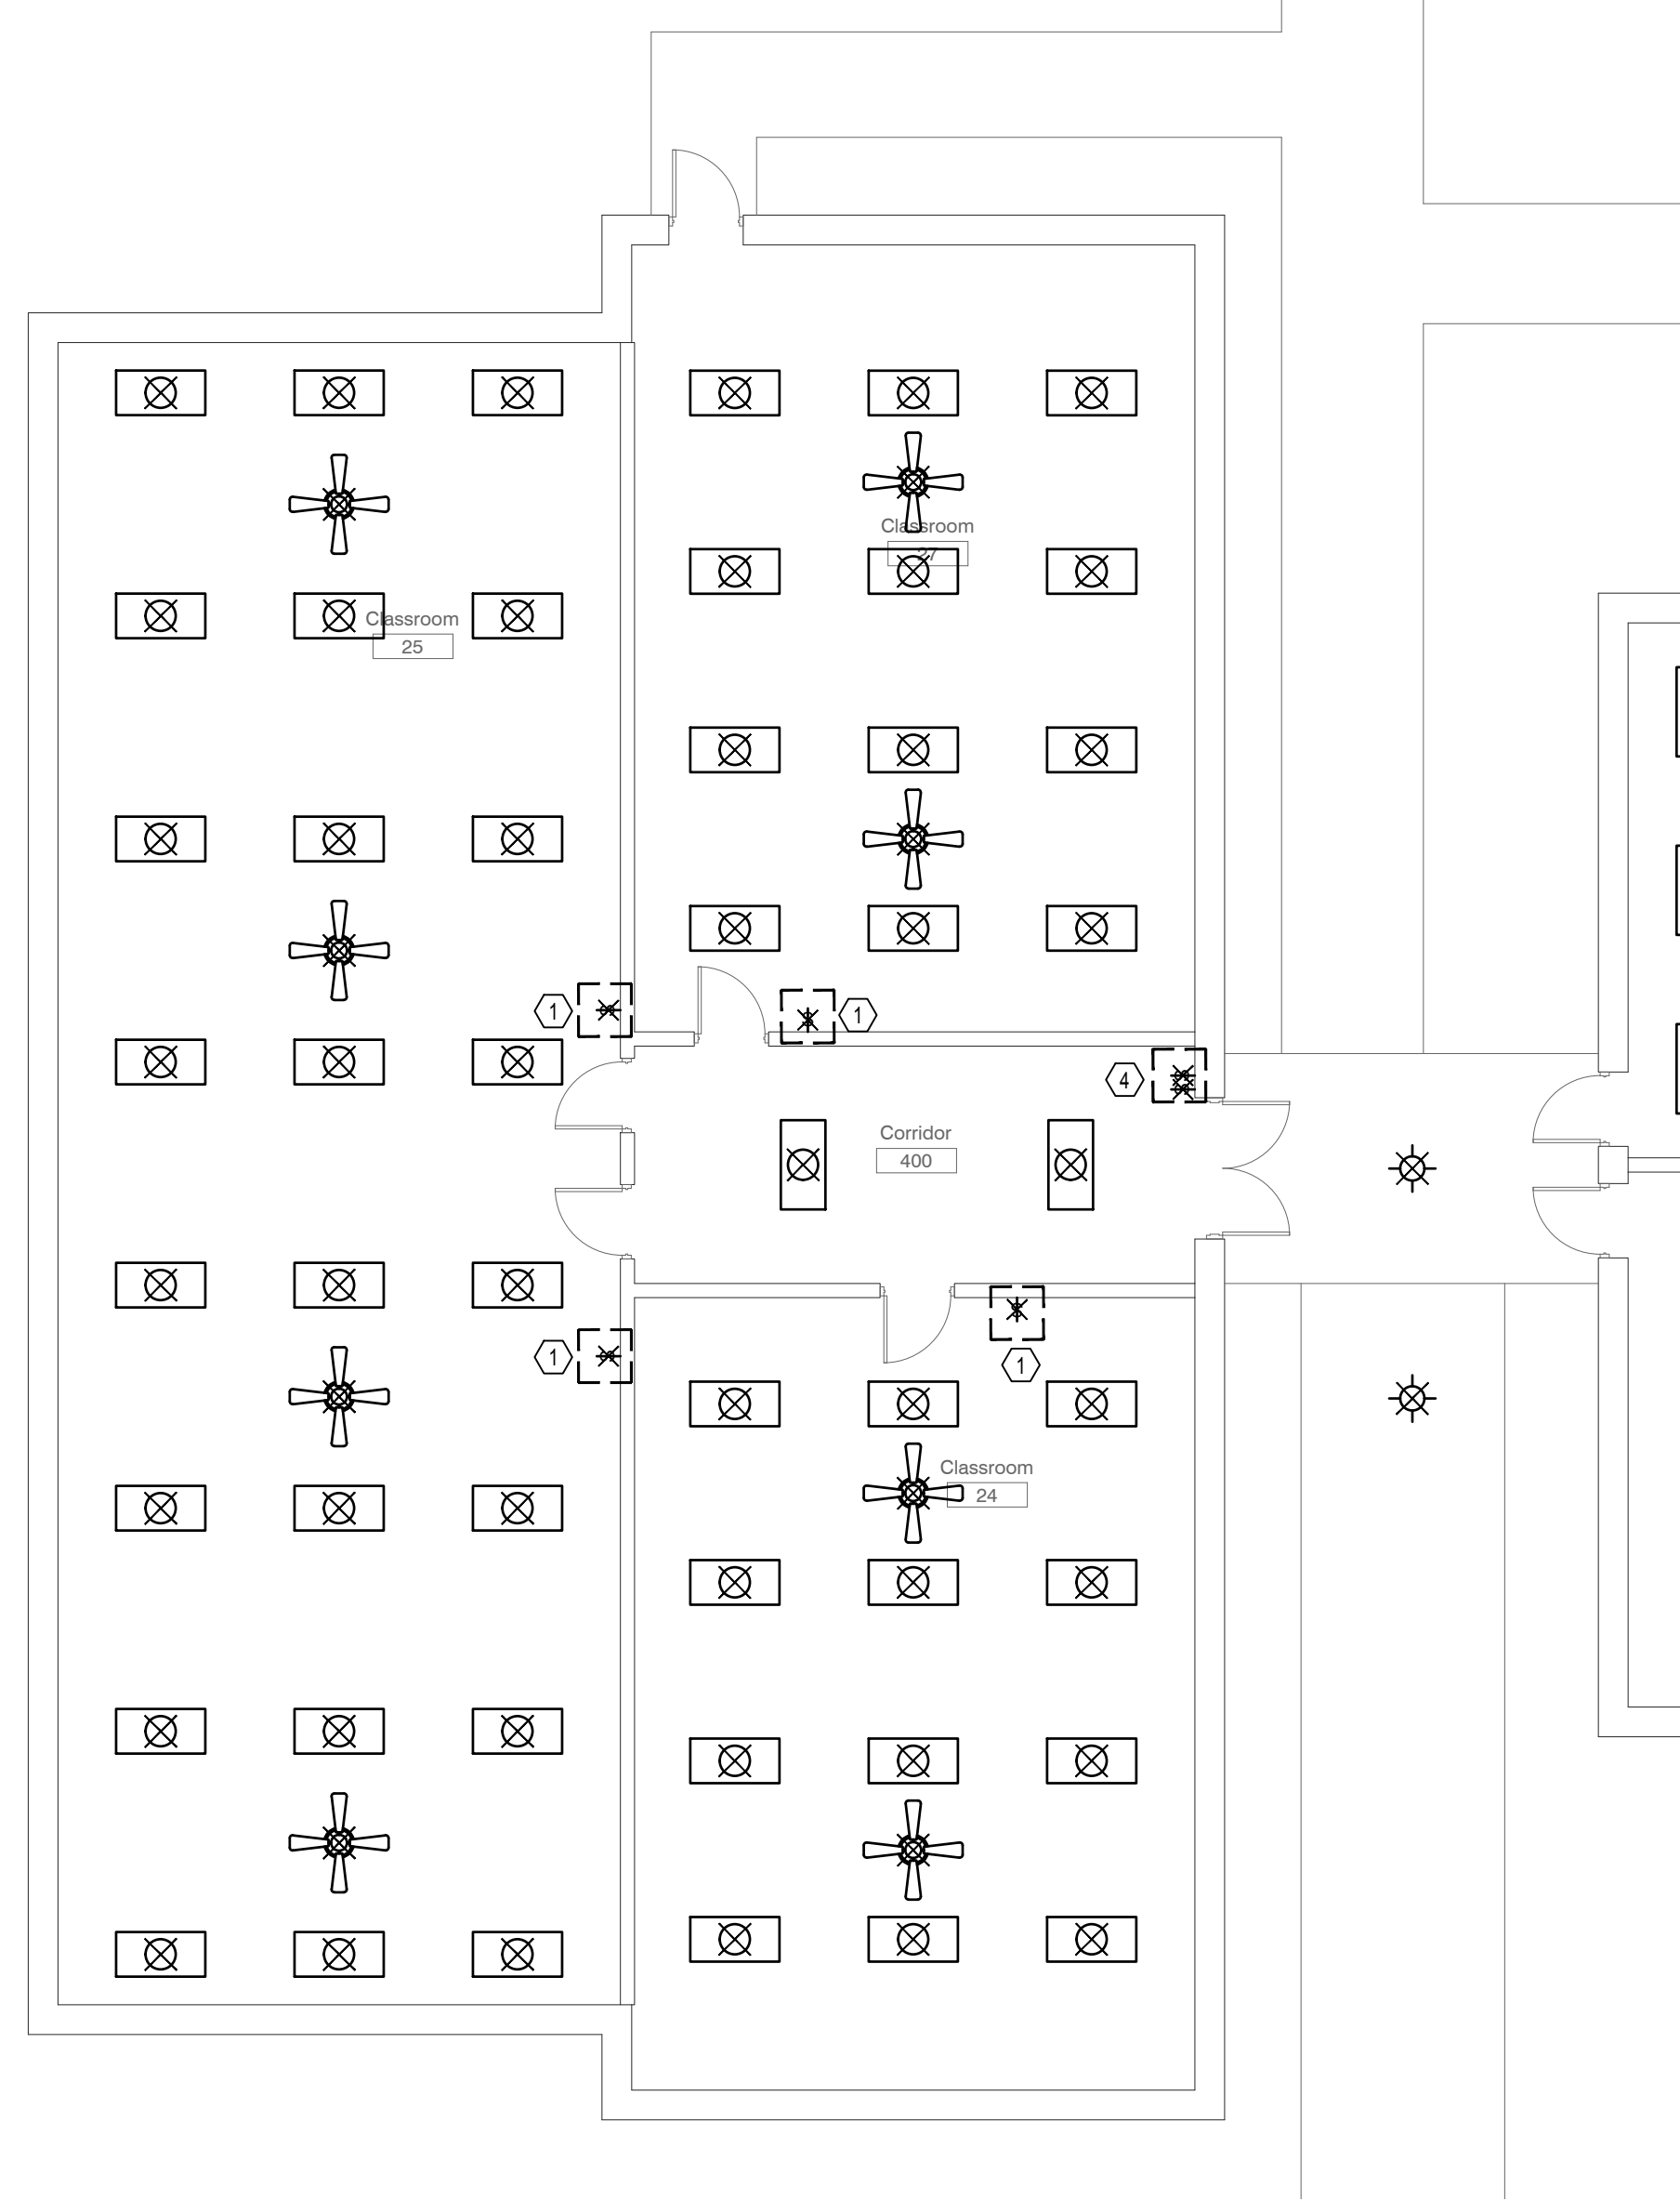

① ED-102 PARTIAL DEMOLITION PLAN - WEST BOLIVAR ELEMENTARY SCHOOL - PART D - ALTERNATE #5
Scale: 1/8" = 1'-0"

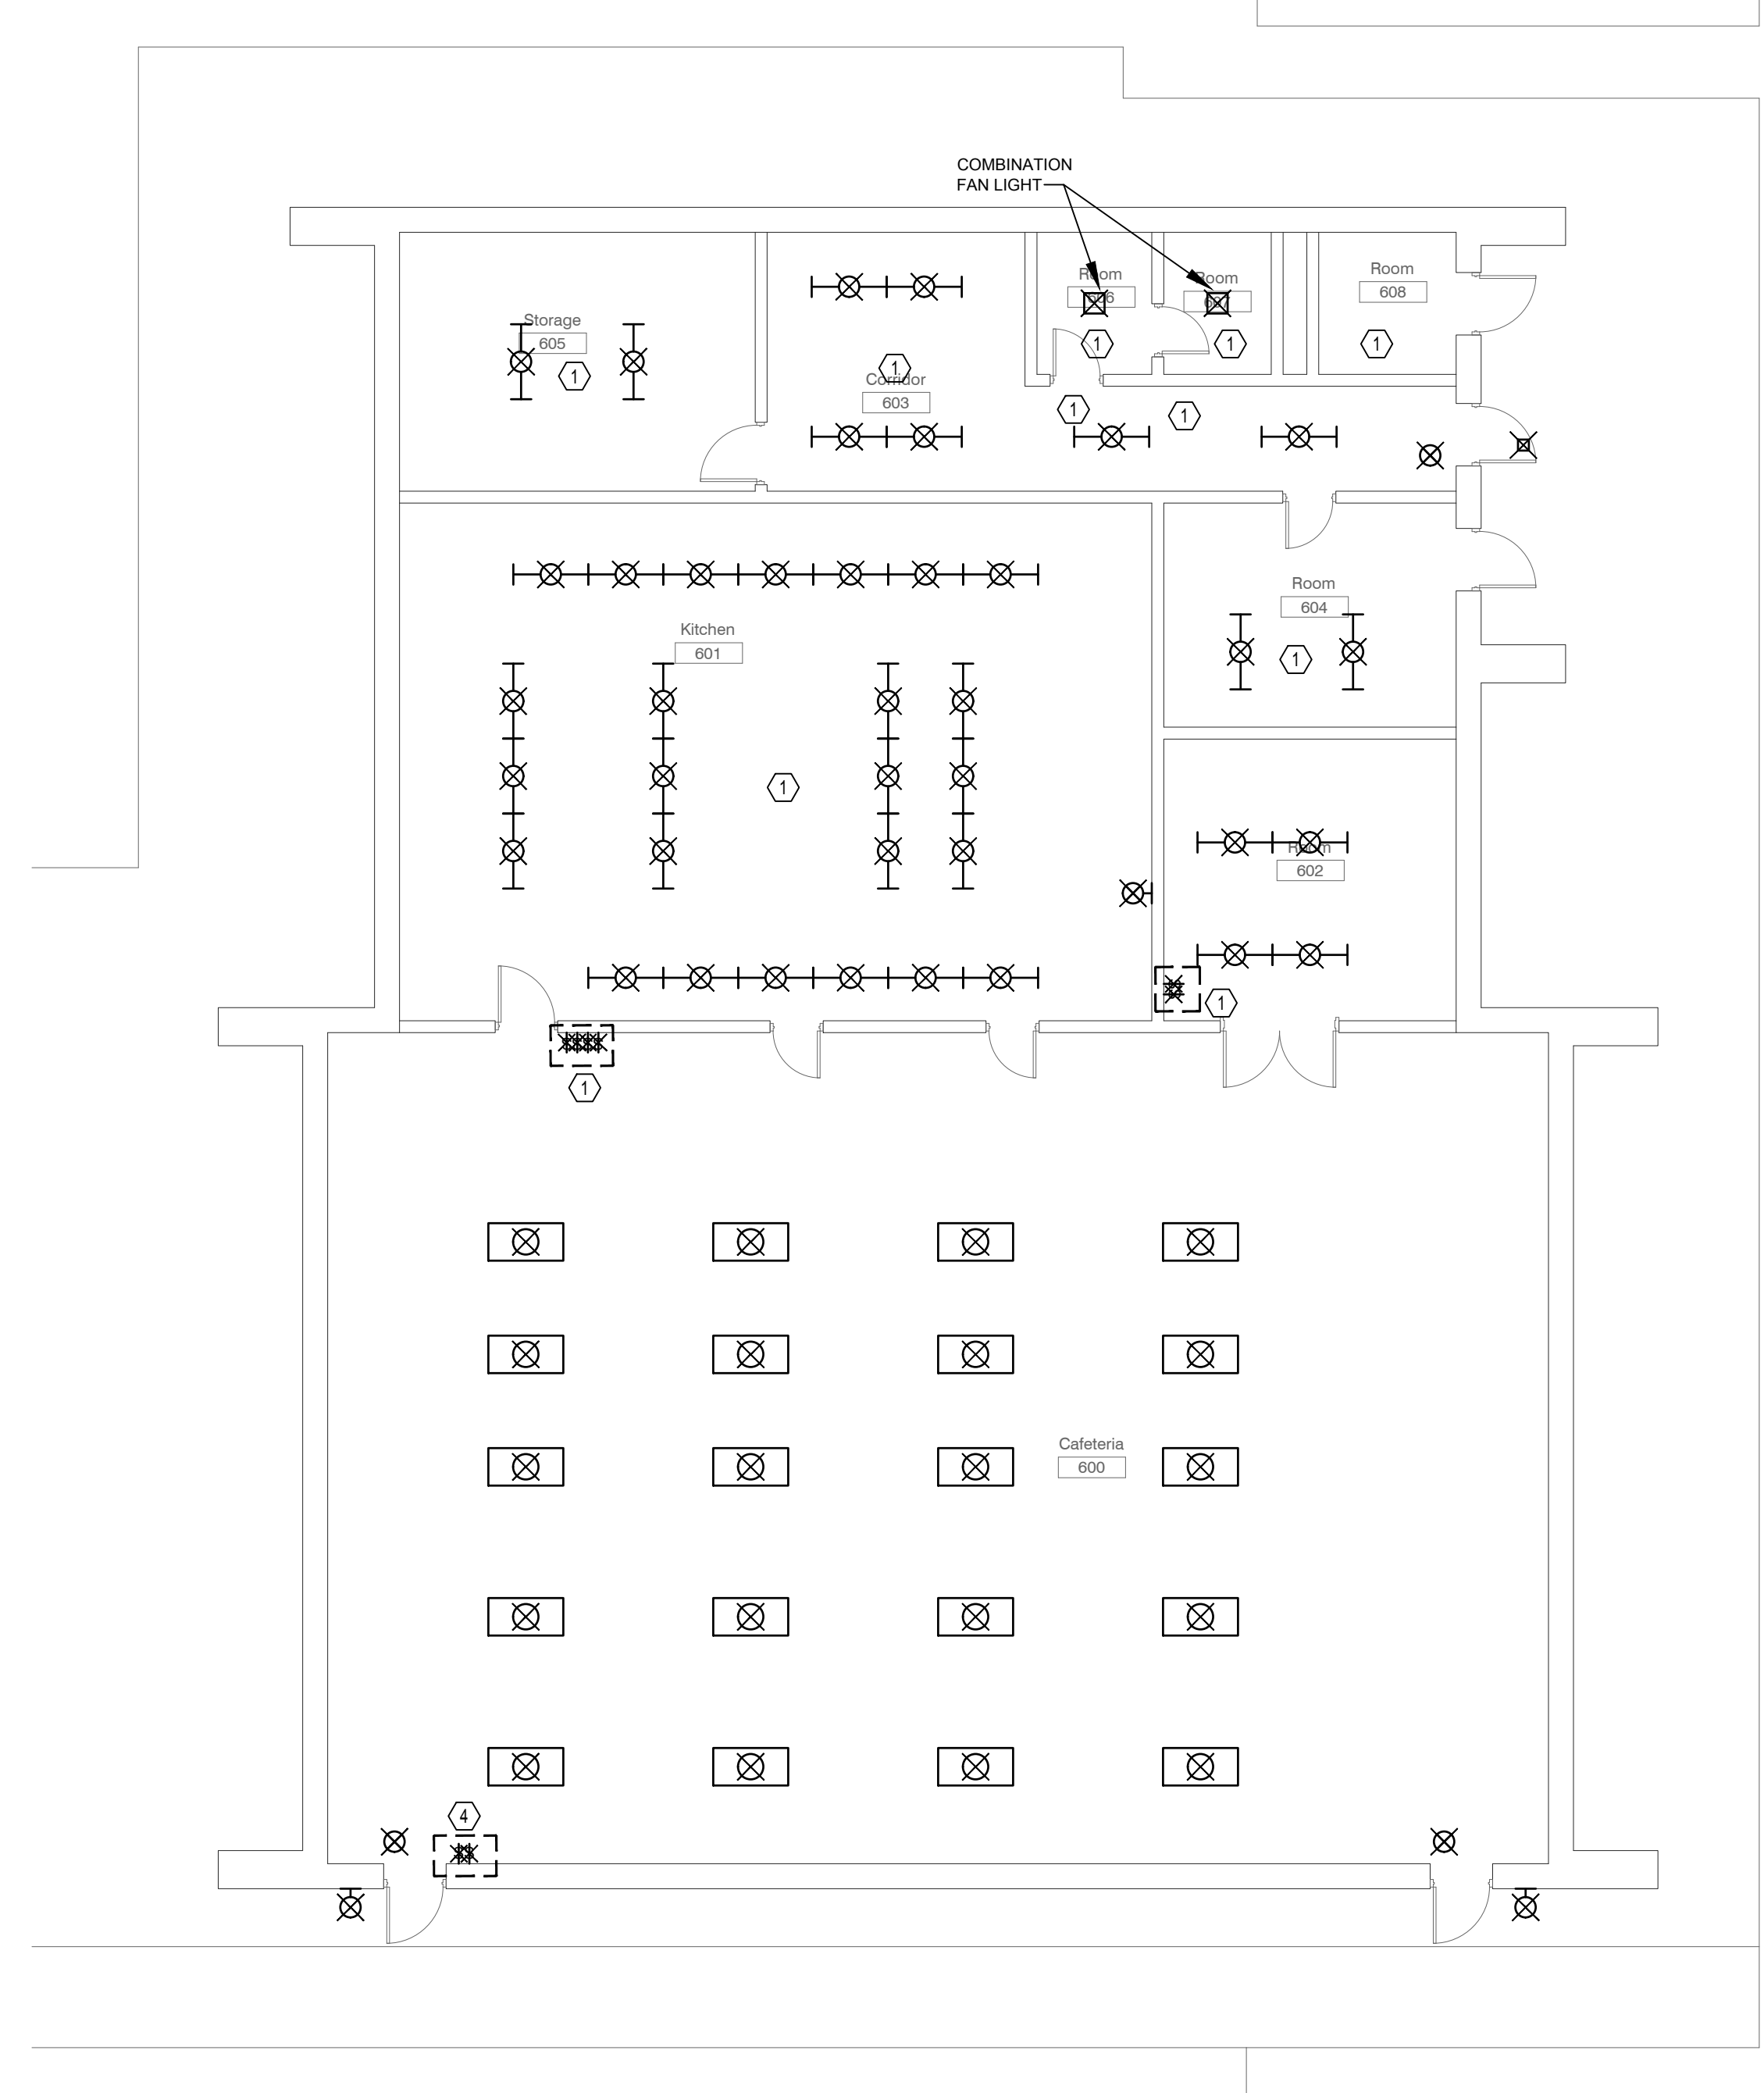


① ED-102 PARTIAL DEMOLITION PLAN - WEST BOLIVAR ELEMENTARY SCHOOL - PART F - ALTERNATE #5
Scale: 1/8" = 1'-0"

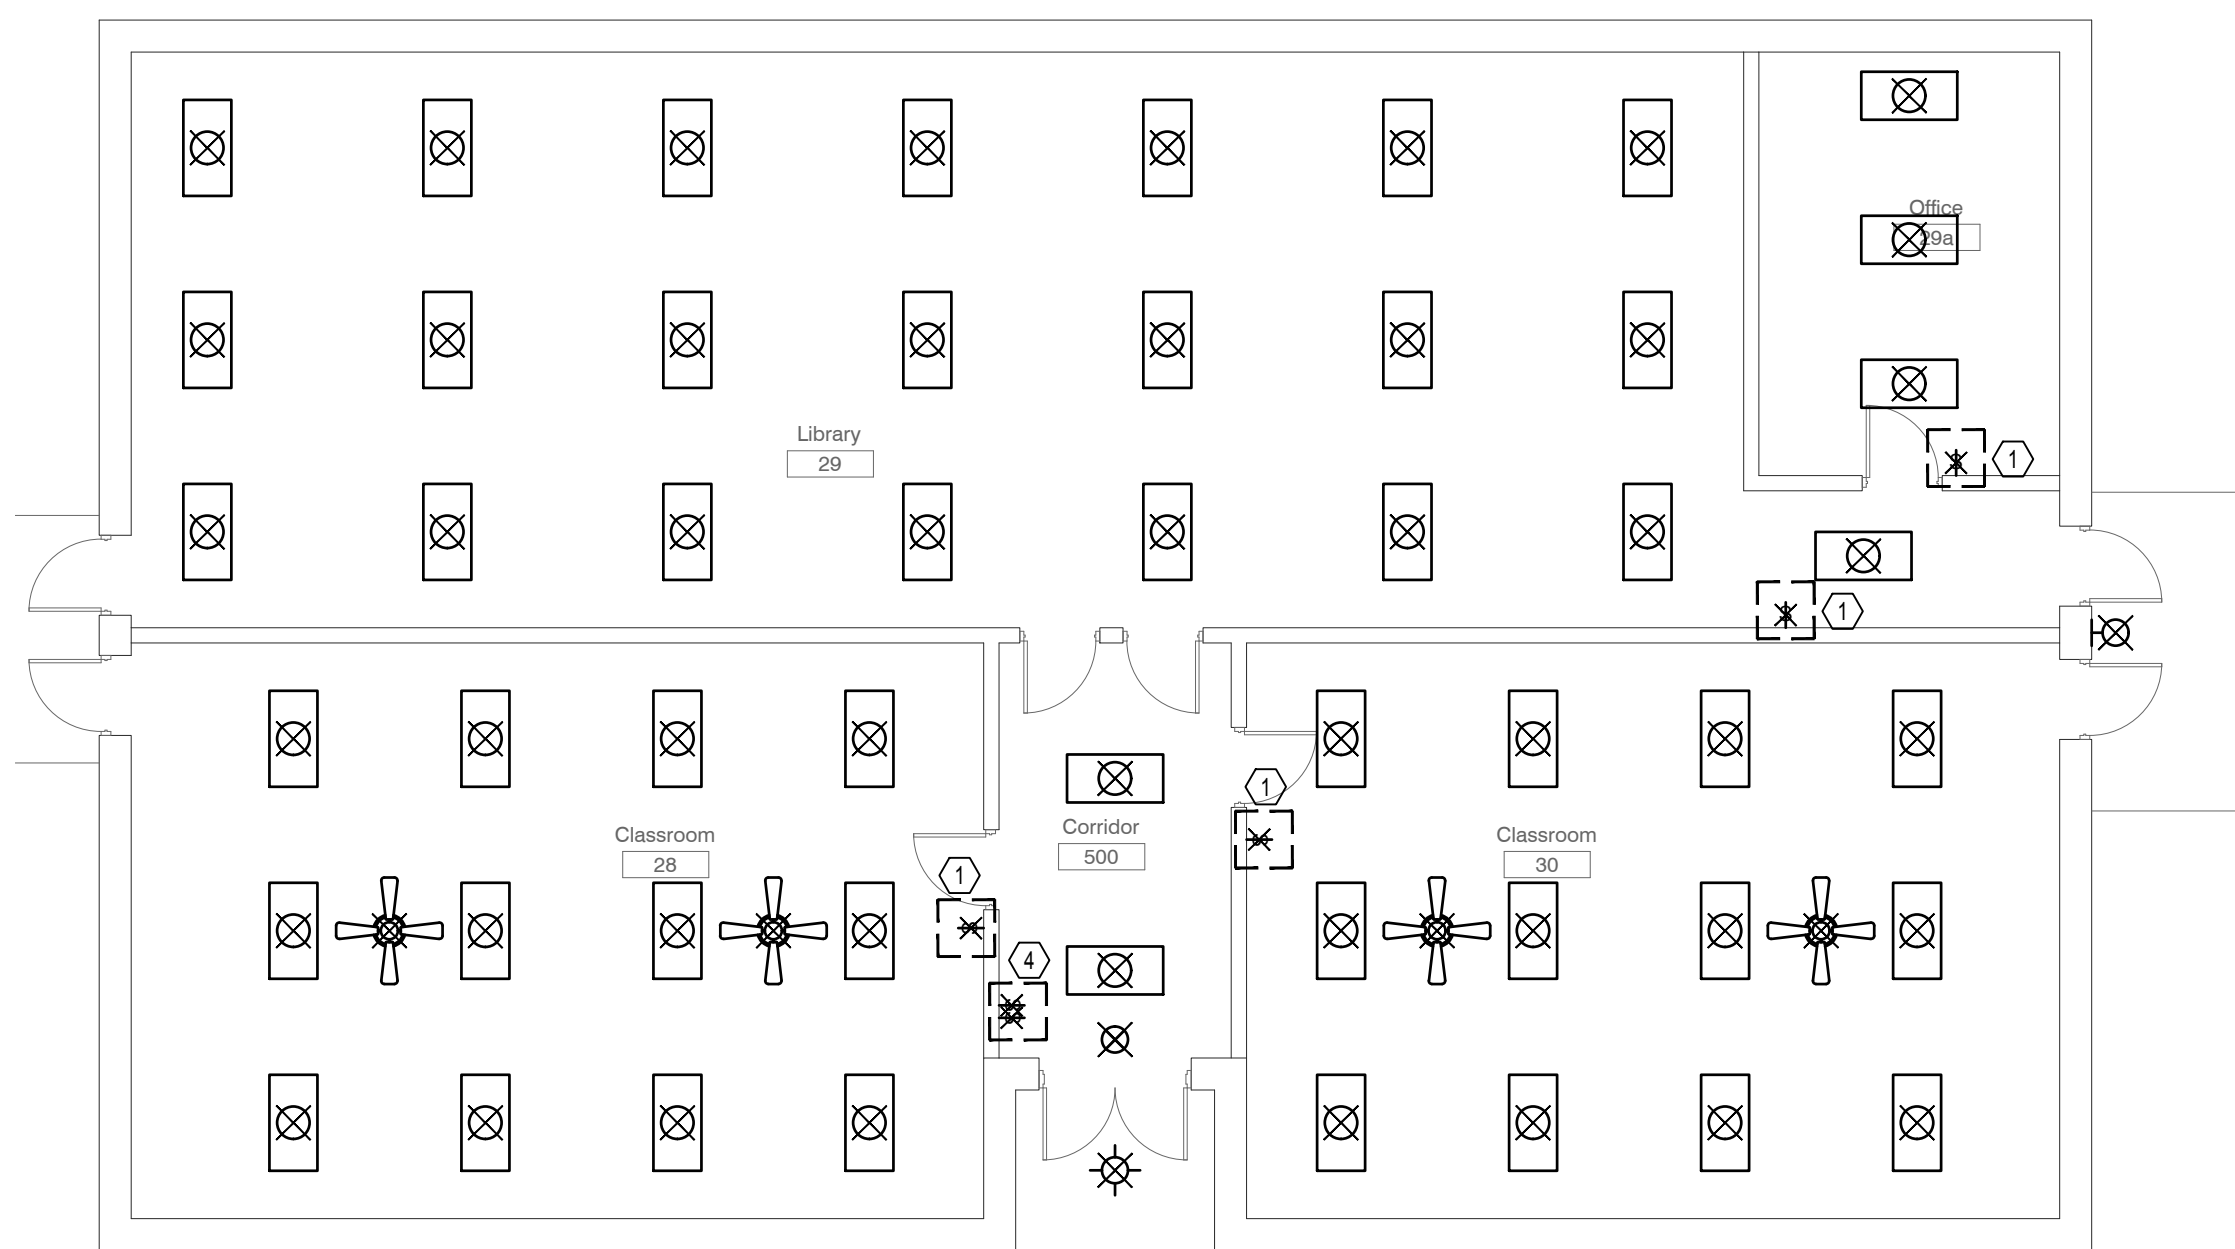

① ED-102 PARTIAL DEMOLITION PLAN - WEST BOLIVAR ELEMENTARY SCHOOL - PART E - ALTERNATE #5
Scale: 1/8" = 1'-0"




KEY PLAN - ELEMENTARY SCHOOL

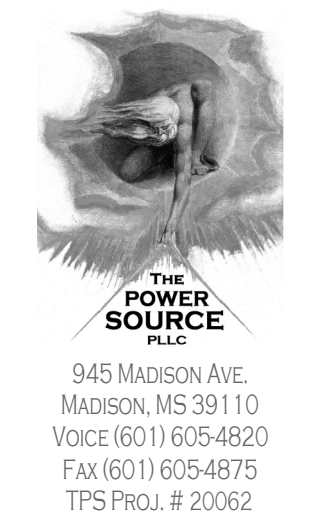

945 MADISON AVE.
MADISON, MS 39110
TPS PROJ. # 20062

AN ASSOCIATION
M I S S I S S I P P I

DALE BAILEY
JACKSON • BILOXI

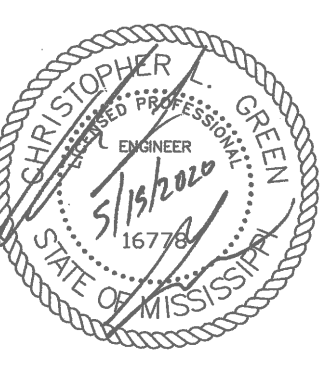


West Bolivar Consolidated School
District Renovation Project


100%
Construction
Documents

Project No	20018
Date	2020-05-15
Drawn	FAB
Checked	CLG
Revisions	Rev Date
ADD#2	2020-06-12

West Bolivar Elementary
ED-102
PARTIAL DEMOLITION
PLAN - PART D, E, F

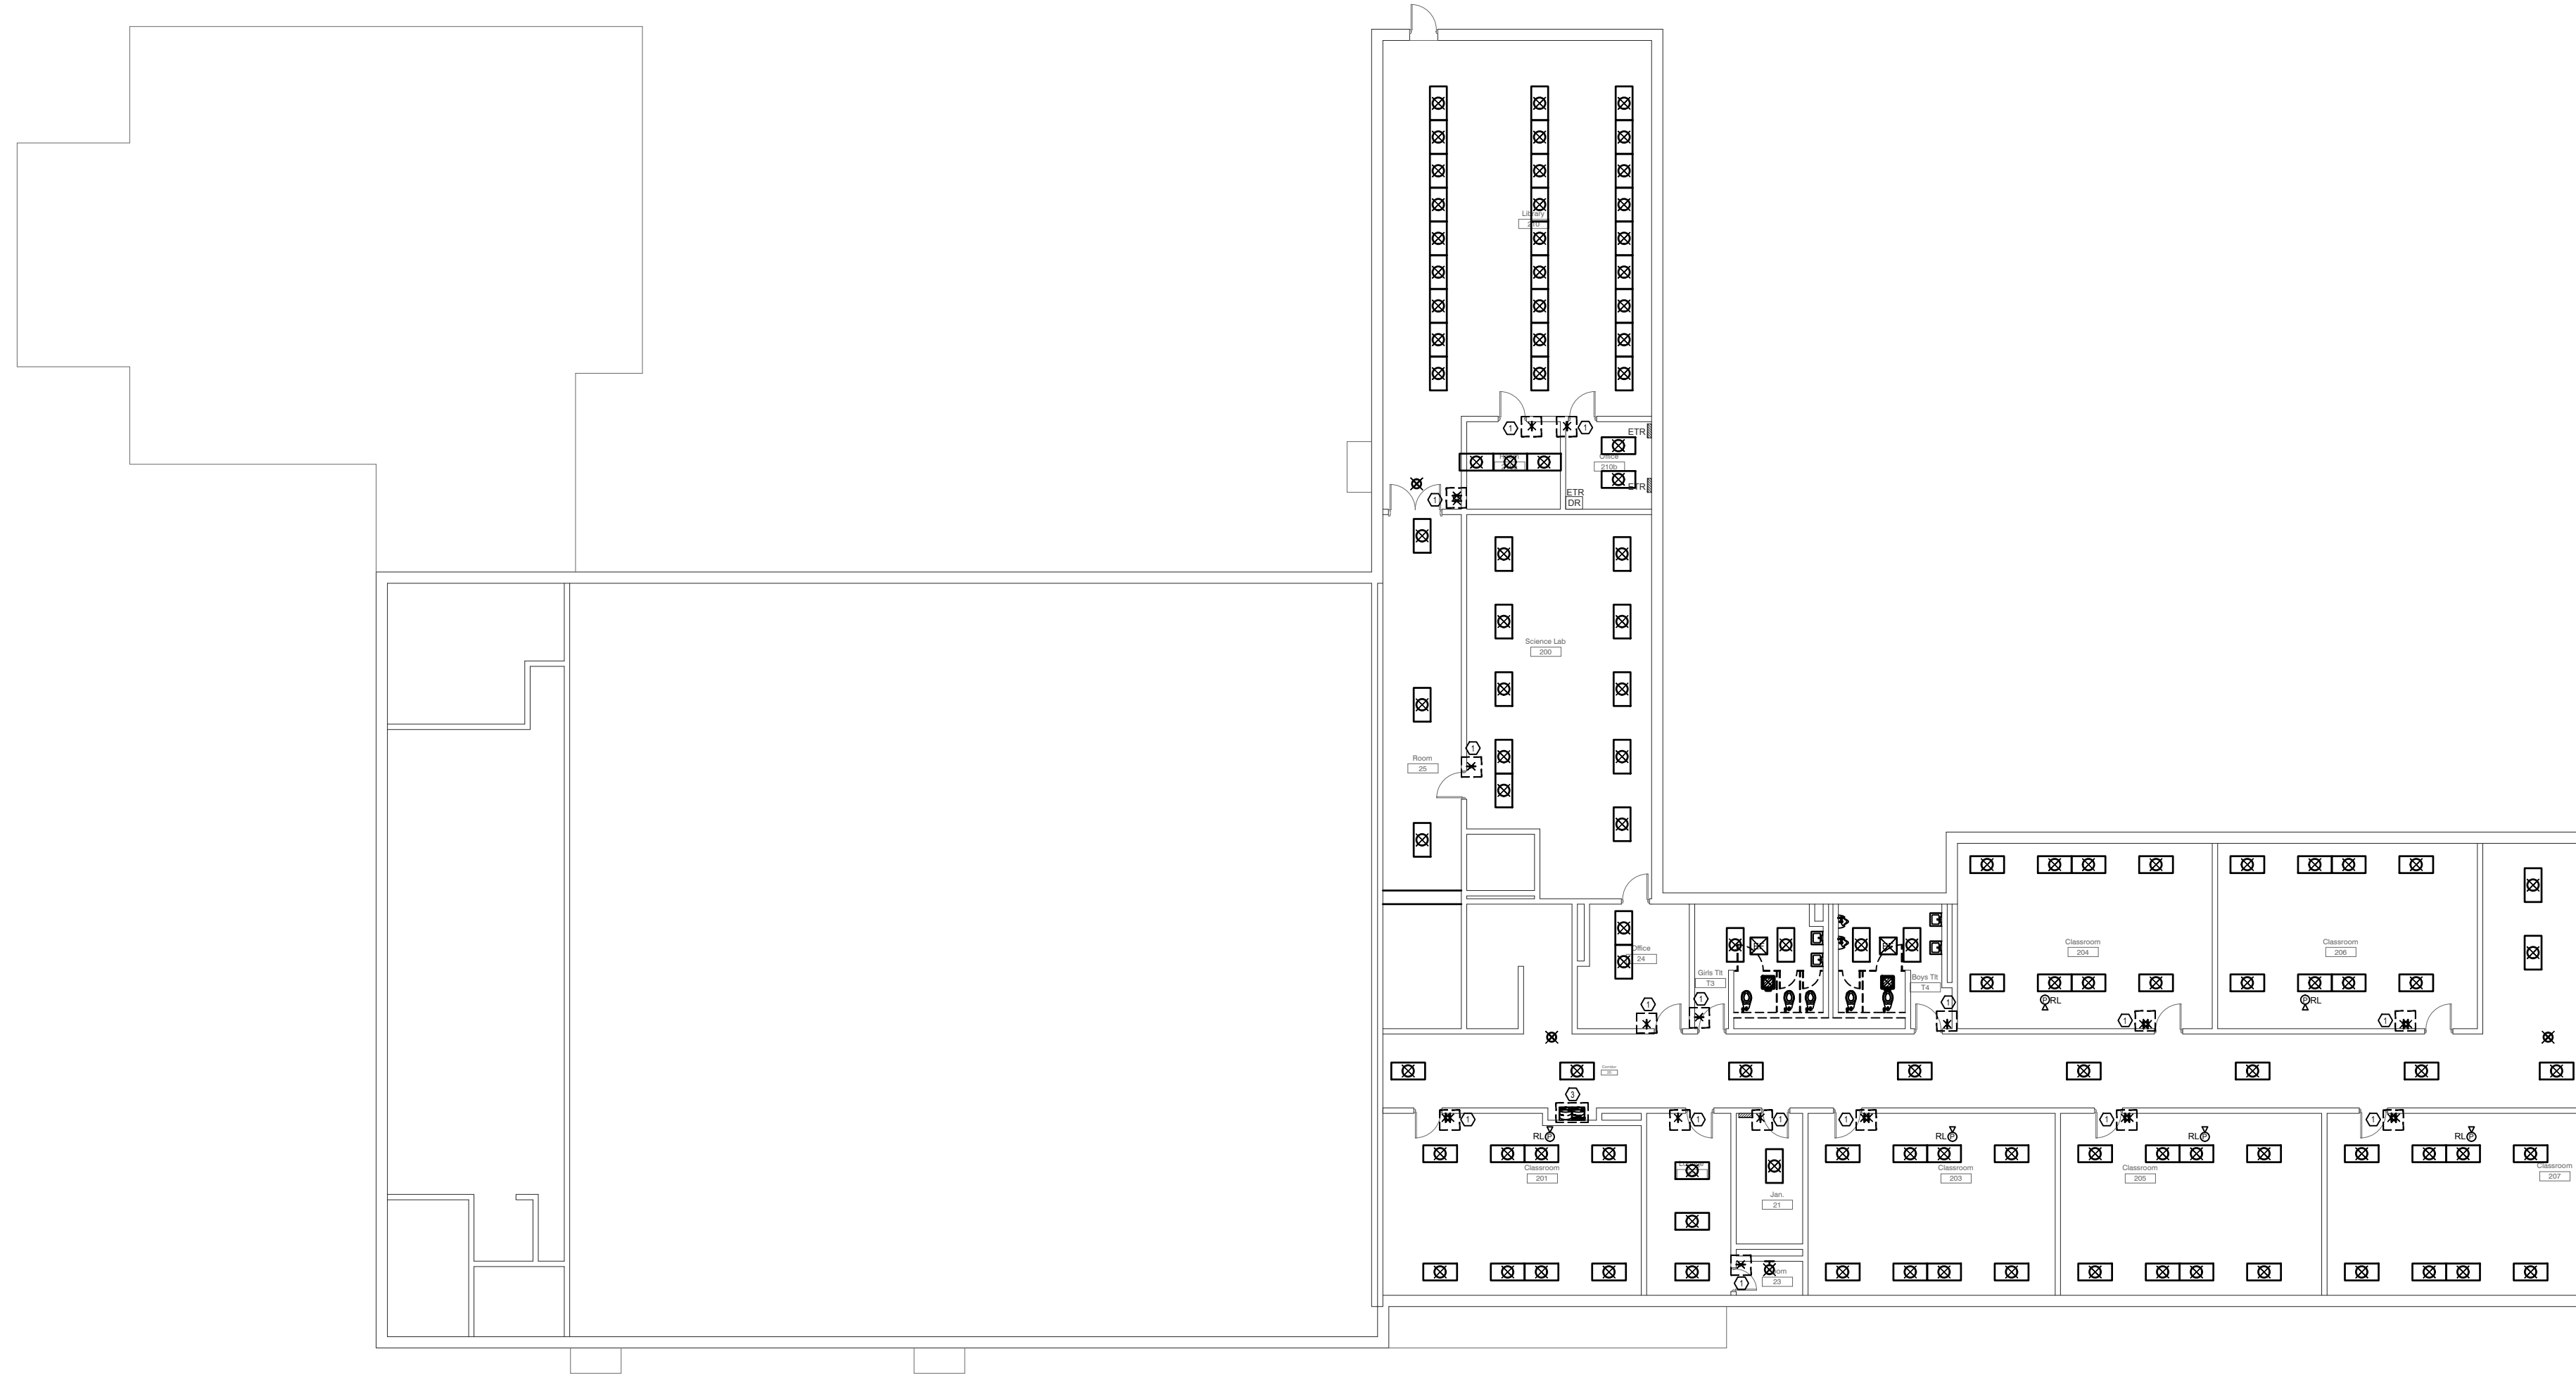


1
ED-103 ELECTRICAL DEMOLITION PLAN - MIDDLE SCHOOL - 2ND FLOOR
Scale: 1/16" = 1'-0"

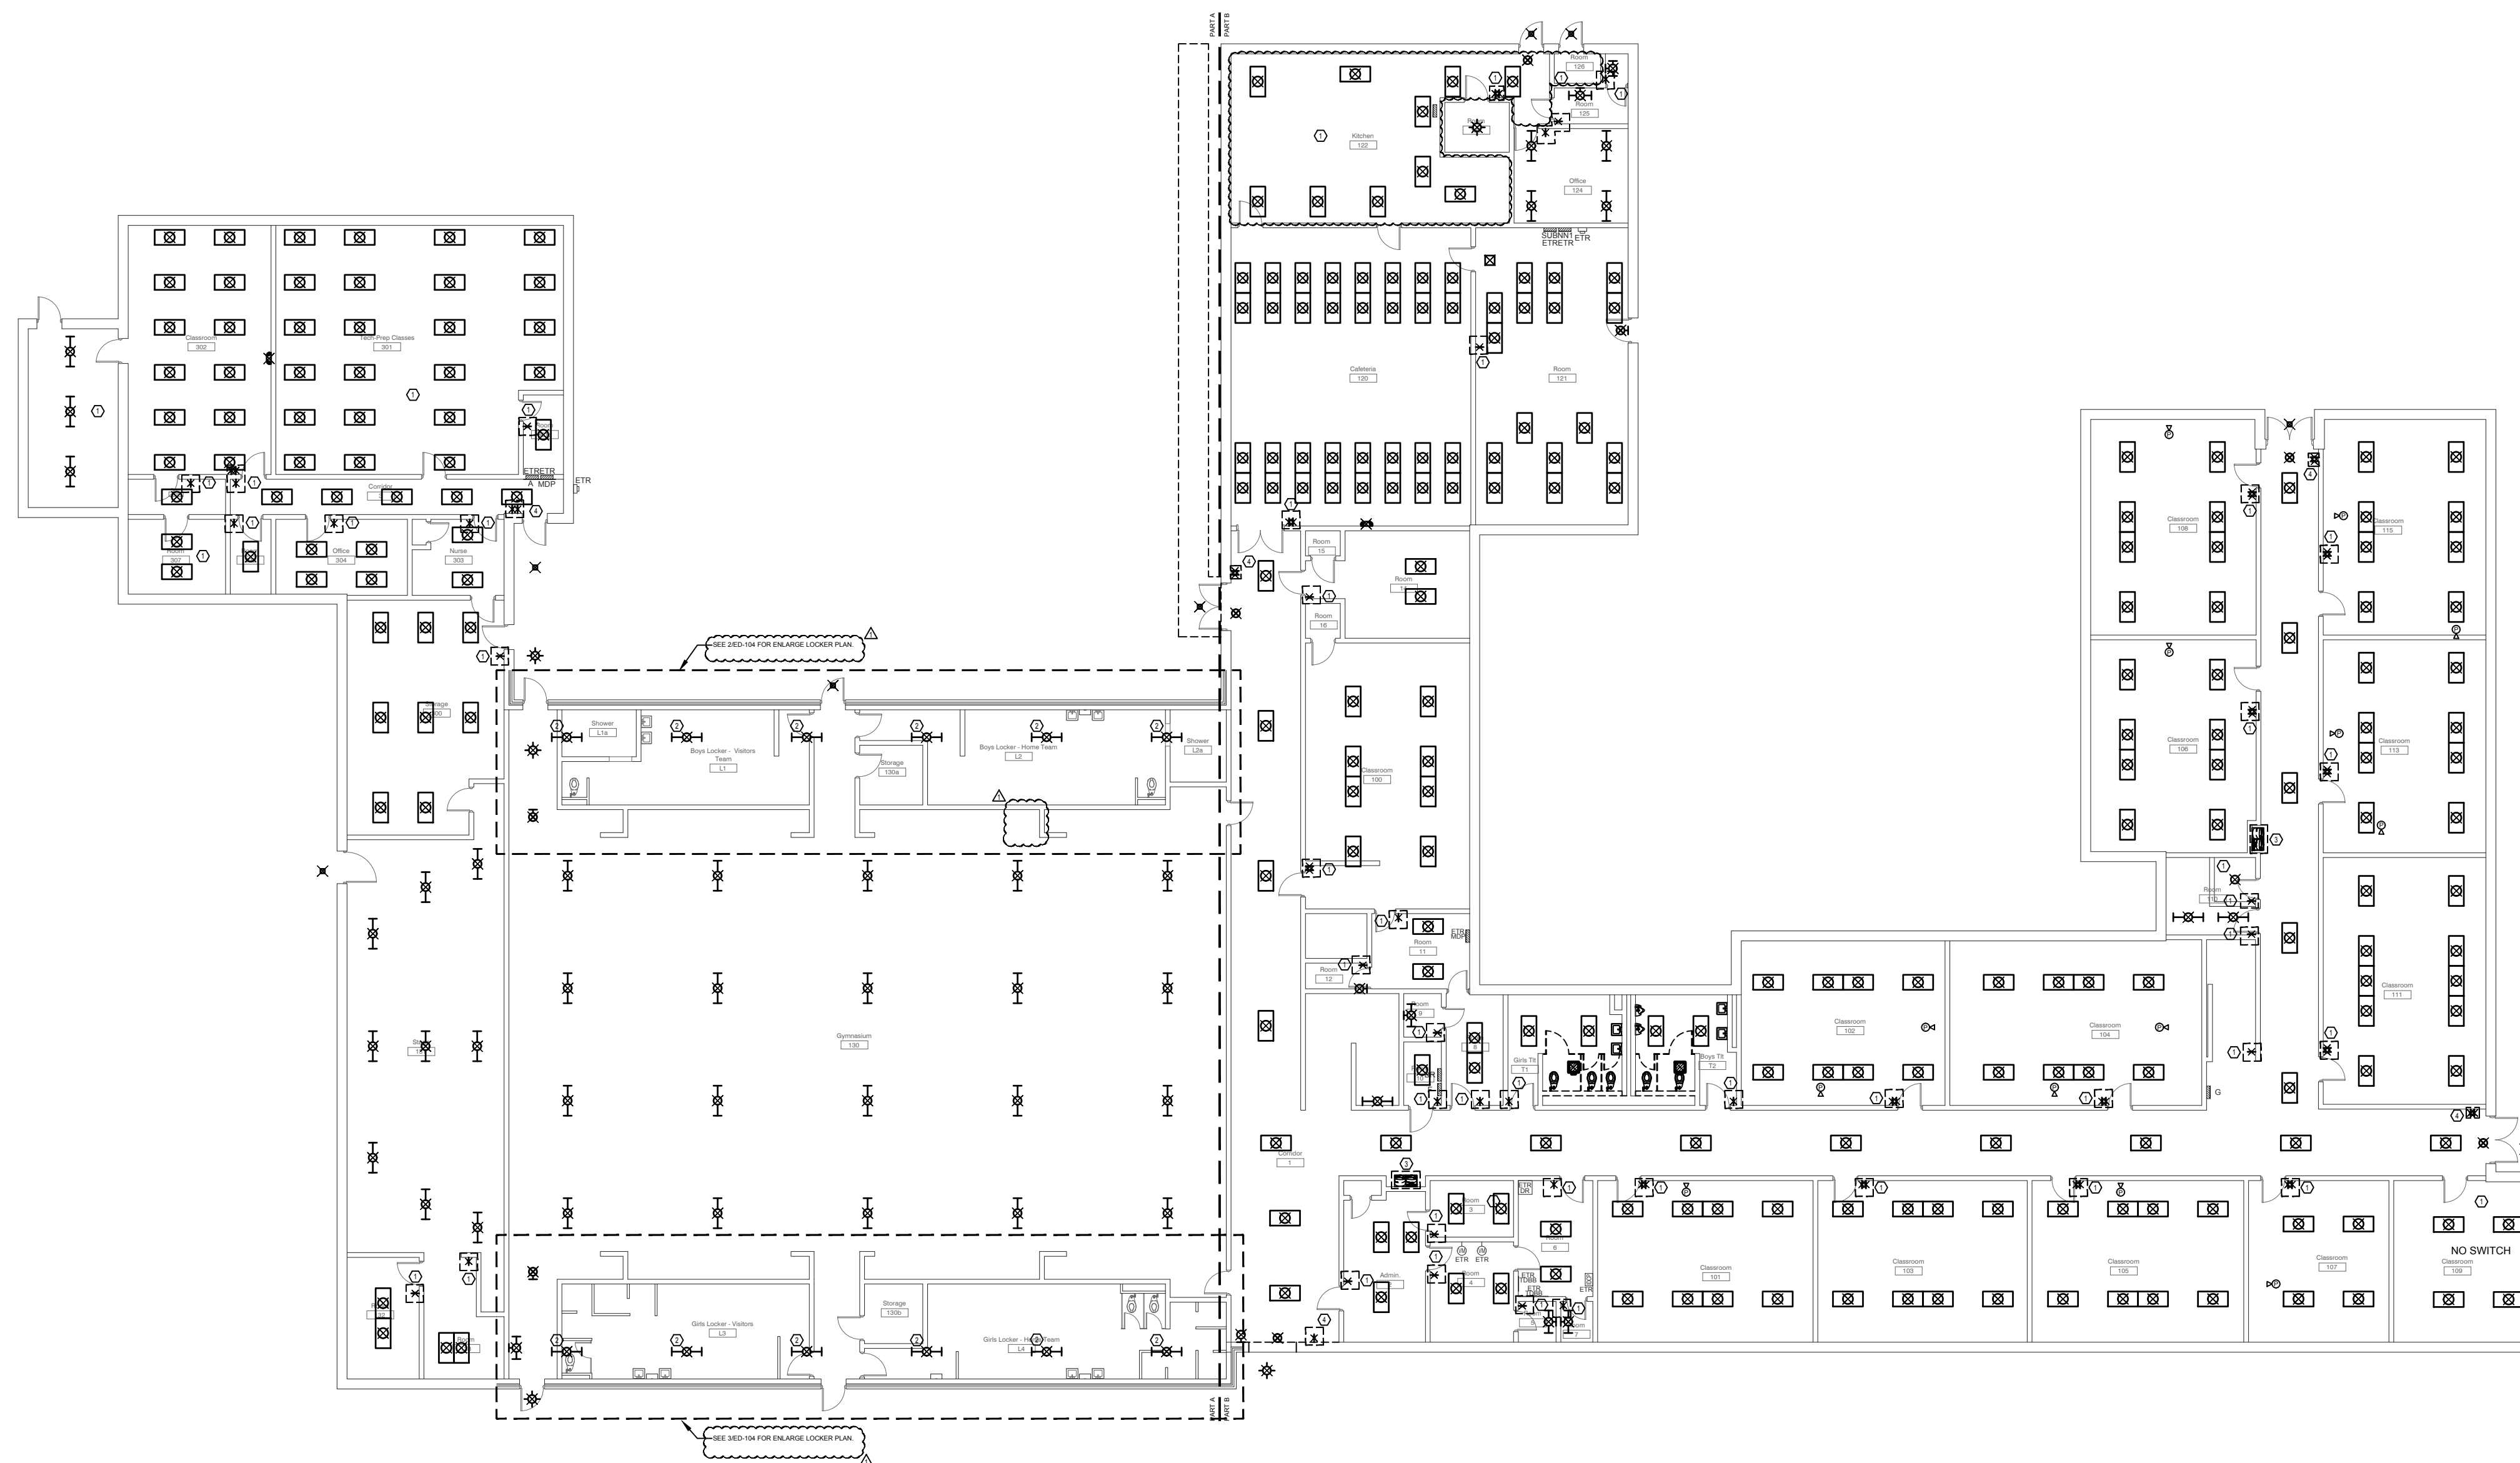


1
ED-103 OVERALL DEMOLITION PLAN - WEST BOLIVAR MIDDLE SCHOOL - 1ST FLOOR
Scale: 1/16" = 1'-0"

MASTER DEMOLITION KEYED NOTES	
Mark	Description
①	FIELD VERIFY LOCATION AND NUMBER OF EXISTING SWITCHES/CONTROLLING LIGHTING FIXTURES AND CEILING FANS. EXISTING LIGHTING FIXTURE SWITCHES SHALL BE DEMOLISHED AND REPLACED WITH A NEW SWITCHING DEVICE THAT SHALL CONTROL. ALL LIGHTING FIXTURES IN THE AREA. EXISTING FAN SWITCH SHALL BE DEMOLISHED. IT IS THE INTENT TO RE-USE ONE OF THE EXISTING SWITCH BOXES IF NO CEILING FAN IS PRESENT. UN-USED BOXES SHALL BE COVERED WITH A BLANK PLATE. SEE LIGHTING PLANS FOR NEW SWITCHING DEVICES.
②	FIXTURE MOUNTED ABOVE BLEACHERS.
③	ALTERNATE #2 (WEST BOLIVAR HIGH & MCEVANS) ALTERNATE #5 (WEST BOLIVAR ELEMENTARY) DRINKING FOUNTAIN SHALL BE DEMOLISHED AND REPLACED WITH A NEW DRINKING FOUNTAIN. REPLACE EXISTING RECEPTACLE WITH A NEW GFI RECEPTACLE AND CONNECT BACK TO THE ORIGINAL CIRCUITRY. FIELD VERIFY ALL LOCATIONS OF EXISTING DRINKING FOUNTAINS, THOSE THAT ARE NOT SHOWN ON THE PLAN SHALL BE REPLACED IN THE SAME MANNER.
④	SEE GENERAL NOTE #3 ON LIGHTING PLANS FOR SWITCHING INFORMATION.
NOTE: IF A KEYED NOTE IS NOT SHOWN ON A DRAWING, THEN THE KEYED NOTE SHALL BE IGNORED FOR THAT PARTICULAR DRAWING. THIS SHALL DIFFER FROM DRAWING TO DRAWING.	
GENERAL NOTES	
Mark	Description
1	DEMOLISH ALL EXISTING TV'S AND ASSOCIATED CABLING/CONDUIT IN EACH CLASSROOM.

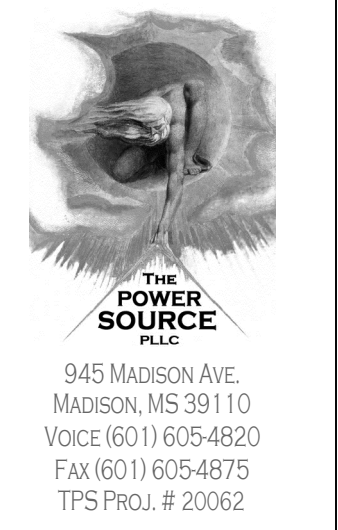

THE POWER SOURCE LLC
945 MADISON AVE.
MADISON, MS 39110
TPS PROJ. # 20062

AN ASSOCIATION
DALE BAILEY
JACKSON • BILOXI
MISSISSIPPI

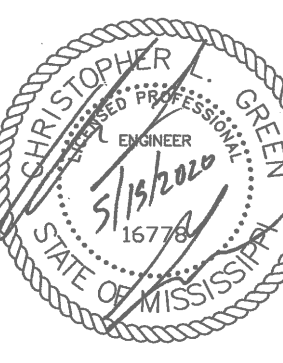

West Bolivar Consolidated School
District Renovation Project

100%
Construction
Documents

Project No	20018
Date	2020-05-15
Drawn	FAB
Checked	CLG
Revisions	Rev Date
▲ ADD#2	2020-06-12

West Bolivar Middle School
ED-103
OVERALL DEMOLITION
PLAN


MASTER DEMOLITION KEYED NOTES

Mark	Description
①	FIELD VERIFY LOCATION AND NUMBER OF EXISTING SWITCHES CONTROLLING LIGHTING FIXTURES AND CEILING FANS. EXISTING LIGHTING FIXTURE SWITCHES SHALL BE DEMOLISHED AND REPLACED WITH A NEW SWITCHING DEVICE THAT SHALL CONTROL ALL LIGHTING FIXTURES IN THE AREA. EXISTING FAN SWITCH SHALL BE DEMOLISHED. IT IS THE INTENT TO RE-USE ONE OF THE EXISTING SWITCH BOXES IF NO CEILING FAN IS PRESENT. UN-USED BOX/BOXES SHALL BE COVERED WITH A BLANK PLATE. SEE LIGHTING PLANS FOR NEW SWITCHING DEVICES.
②	FIXTURE MOUNTED ABOVE BLEACHERS.
③	ALTERNATE #2 (WEST BOLIVAR HIGH & MCEVANS) ALTERNATE #5 (WEST BOLIVAR ELEMENTARY) DRINKING FOUNTAIN SHALL BE DEMOLISHED AND REPLACED WITH A NEW DRINKING FOUNTAIN. REPLACE EXISTING RECEPTACLE WITH A NEW GFI RECEPTACLE AND CONNECT BACK TO THE ORIGINAL CIRCUITRY. FIELD VERIFY ALL LOCATIONS OF EXISTING DRINKING FOUNTAINS, THOSE THAT ARE NOT SHOWN ON THE PLAN SHALL BE REPLACED IN THE SAME MANNER.
④	SEE GENERAL NOTE #3 ON LIGHTING PLANS FOR SWITCHING INFORMATION.


NOTE:
IF A KEYED NOTE IS NOT SHOWN ON A DRAWING, THEN THE KEYED NOTE SHALL BE IGNORED FOR THAT PARTICULAR DRAWING. THIS SHALL DIFFER FROM DRAWING TO DRAWING.

GENERAL NOTES

Mark	Description
1.	DEMOLISH ALL EXISTING TV'S AND ASSOCIATED CABLING/CONDUIT IN EACH CLASSROOM.

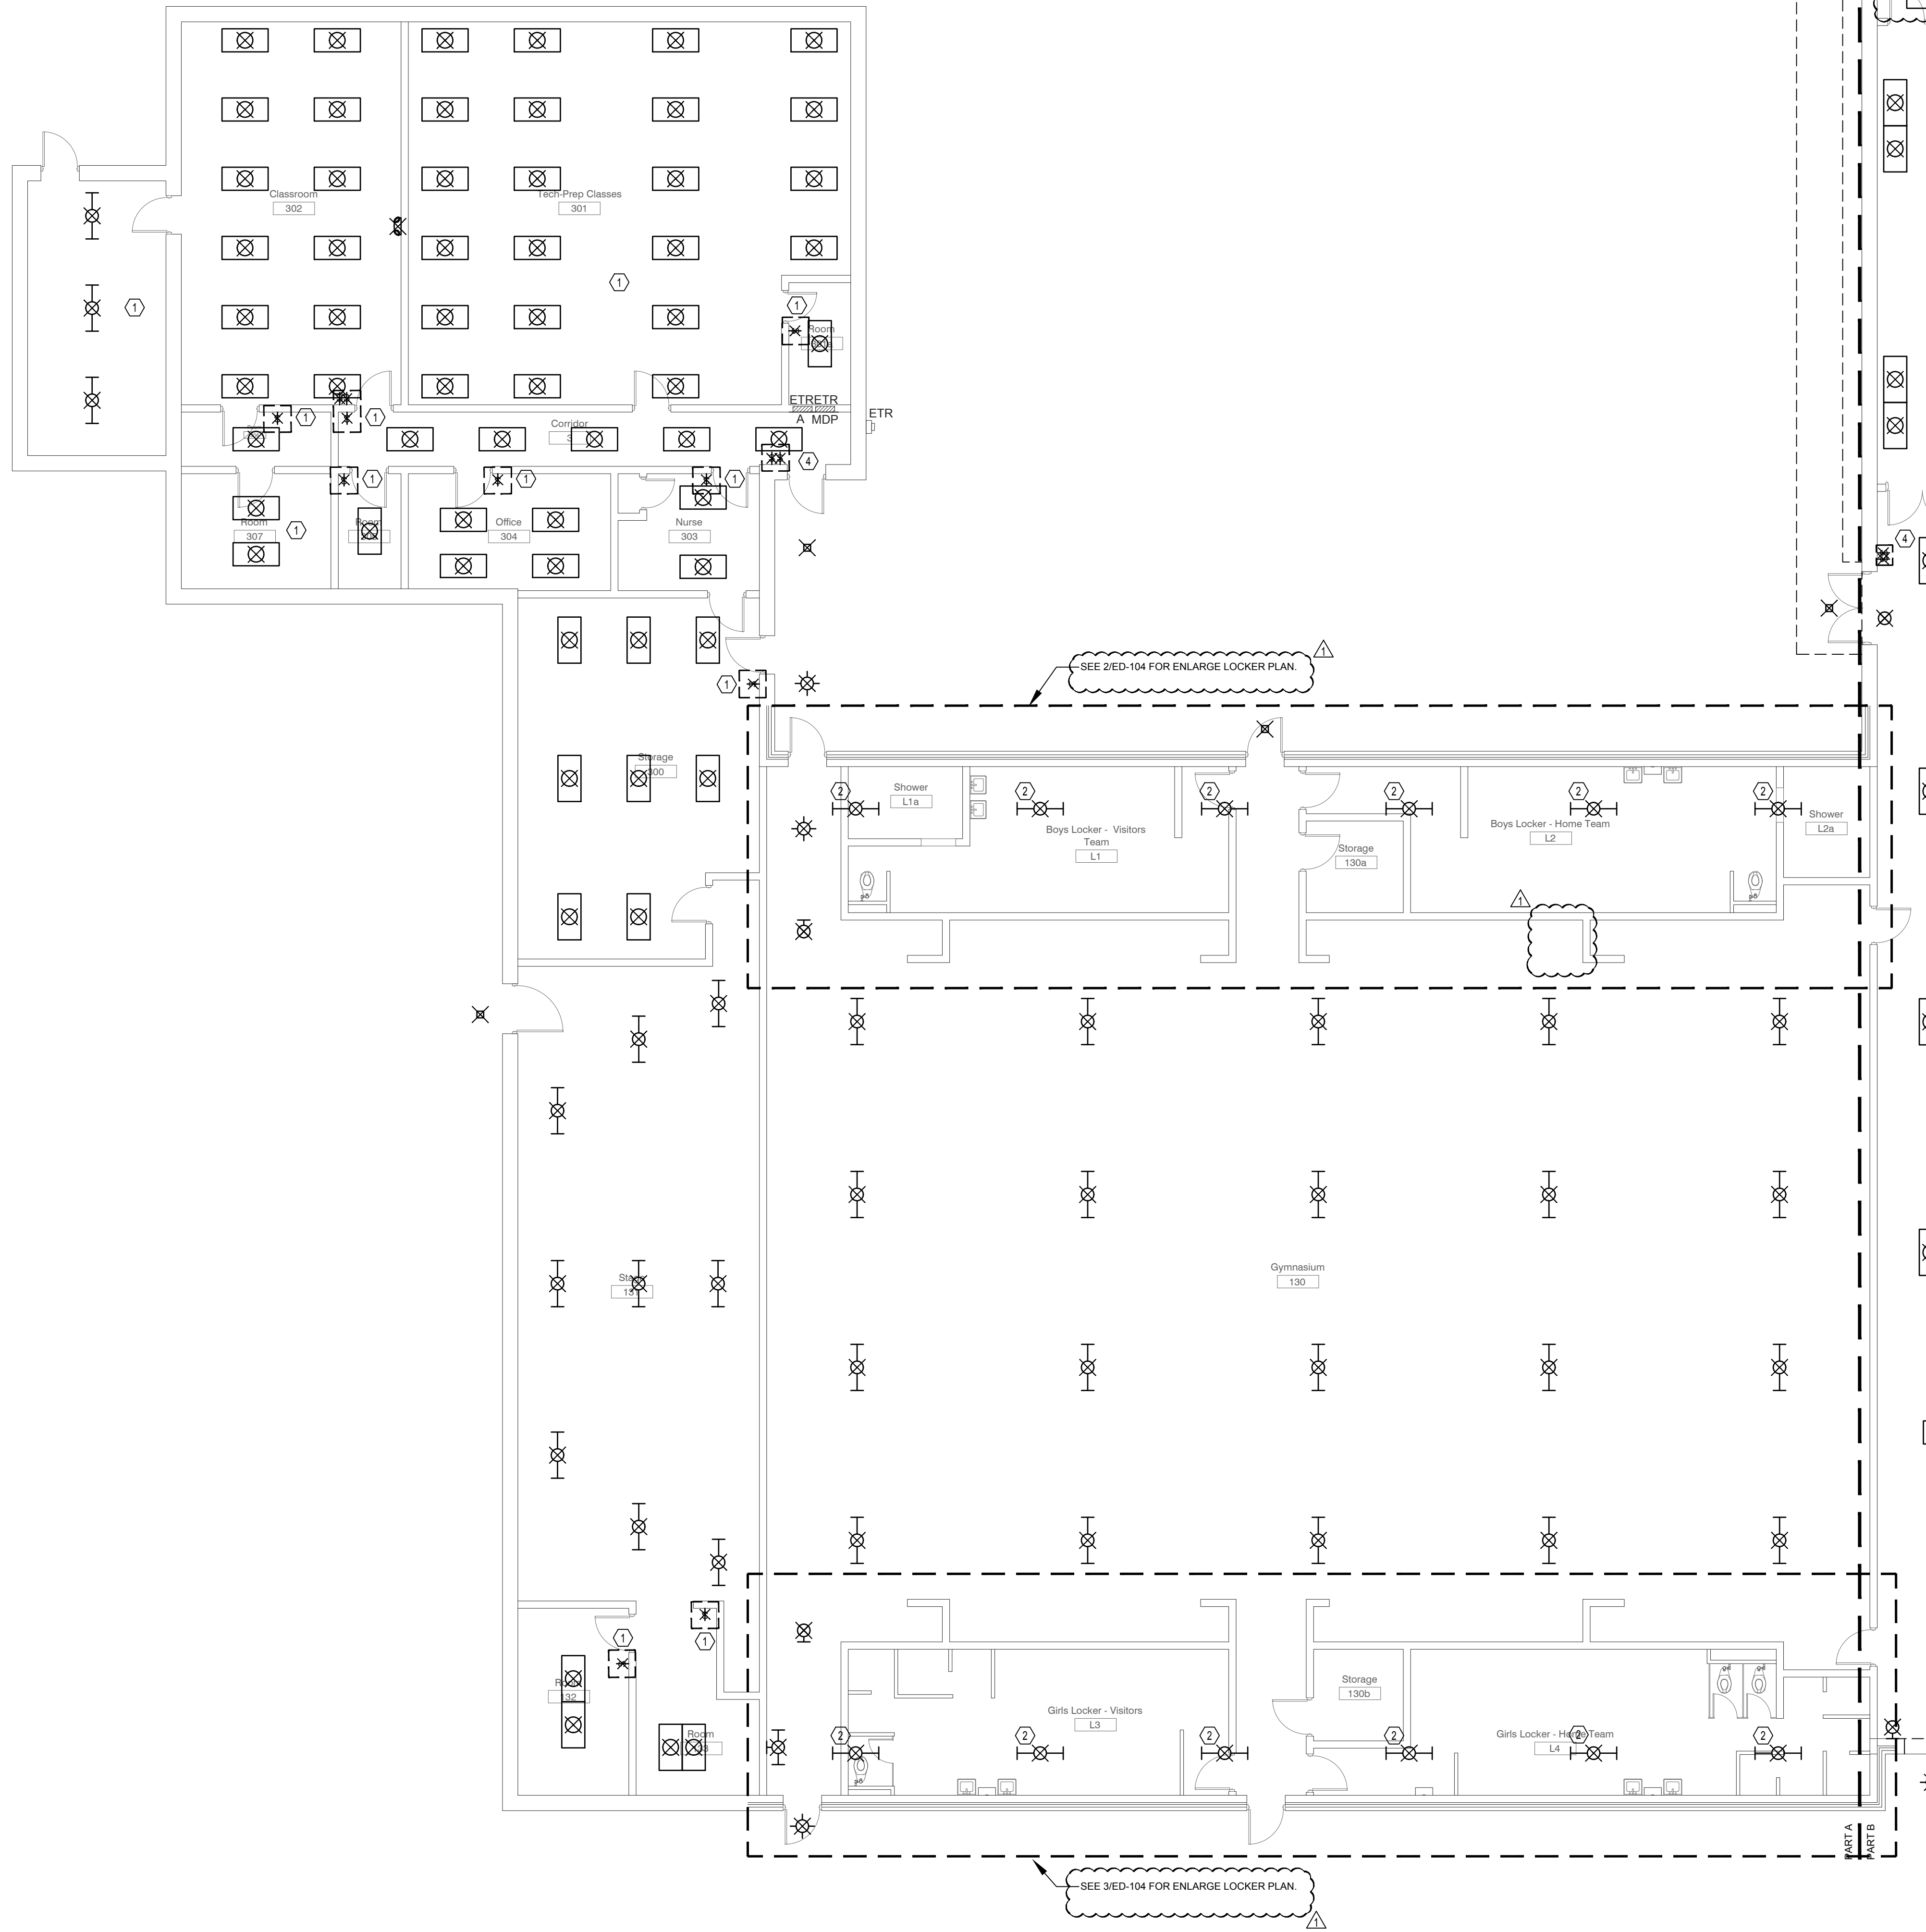


① ED-104 PARTIAL DEMOLITION PLAN - WEST BOLIVAR MIDDLE SCHOOL - 1ST FLOOR - PART A
Scale: 1/8" = 1'-0"

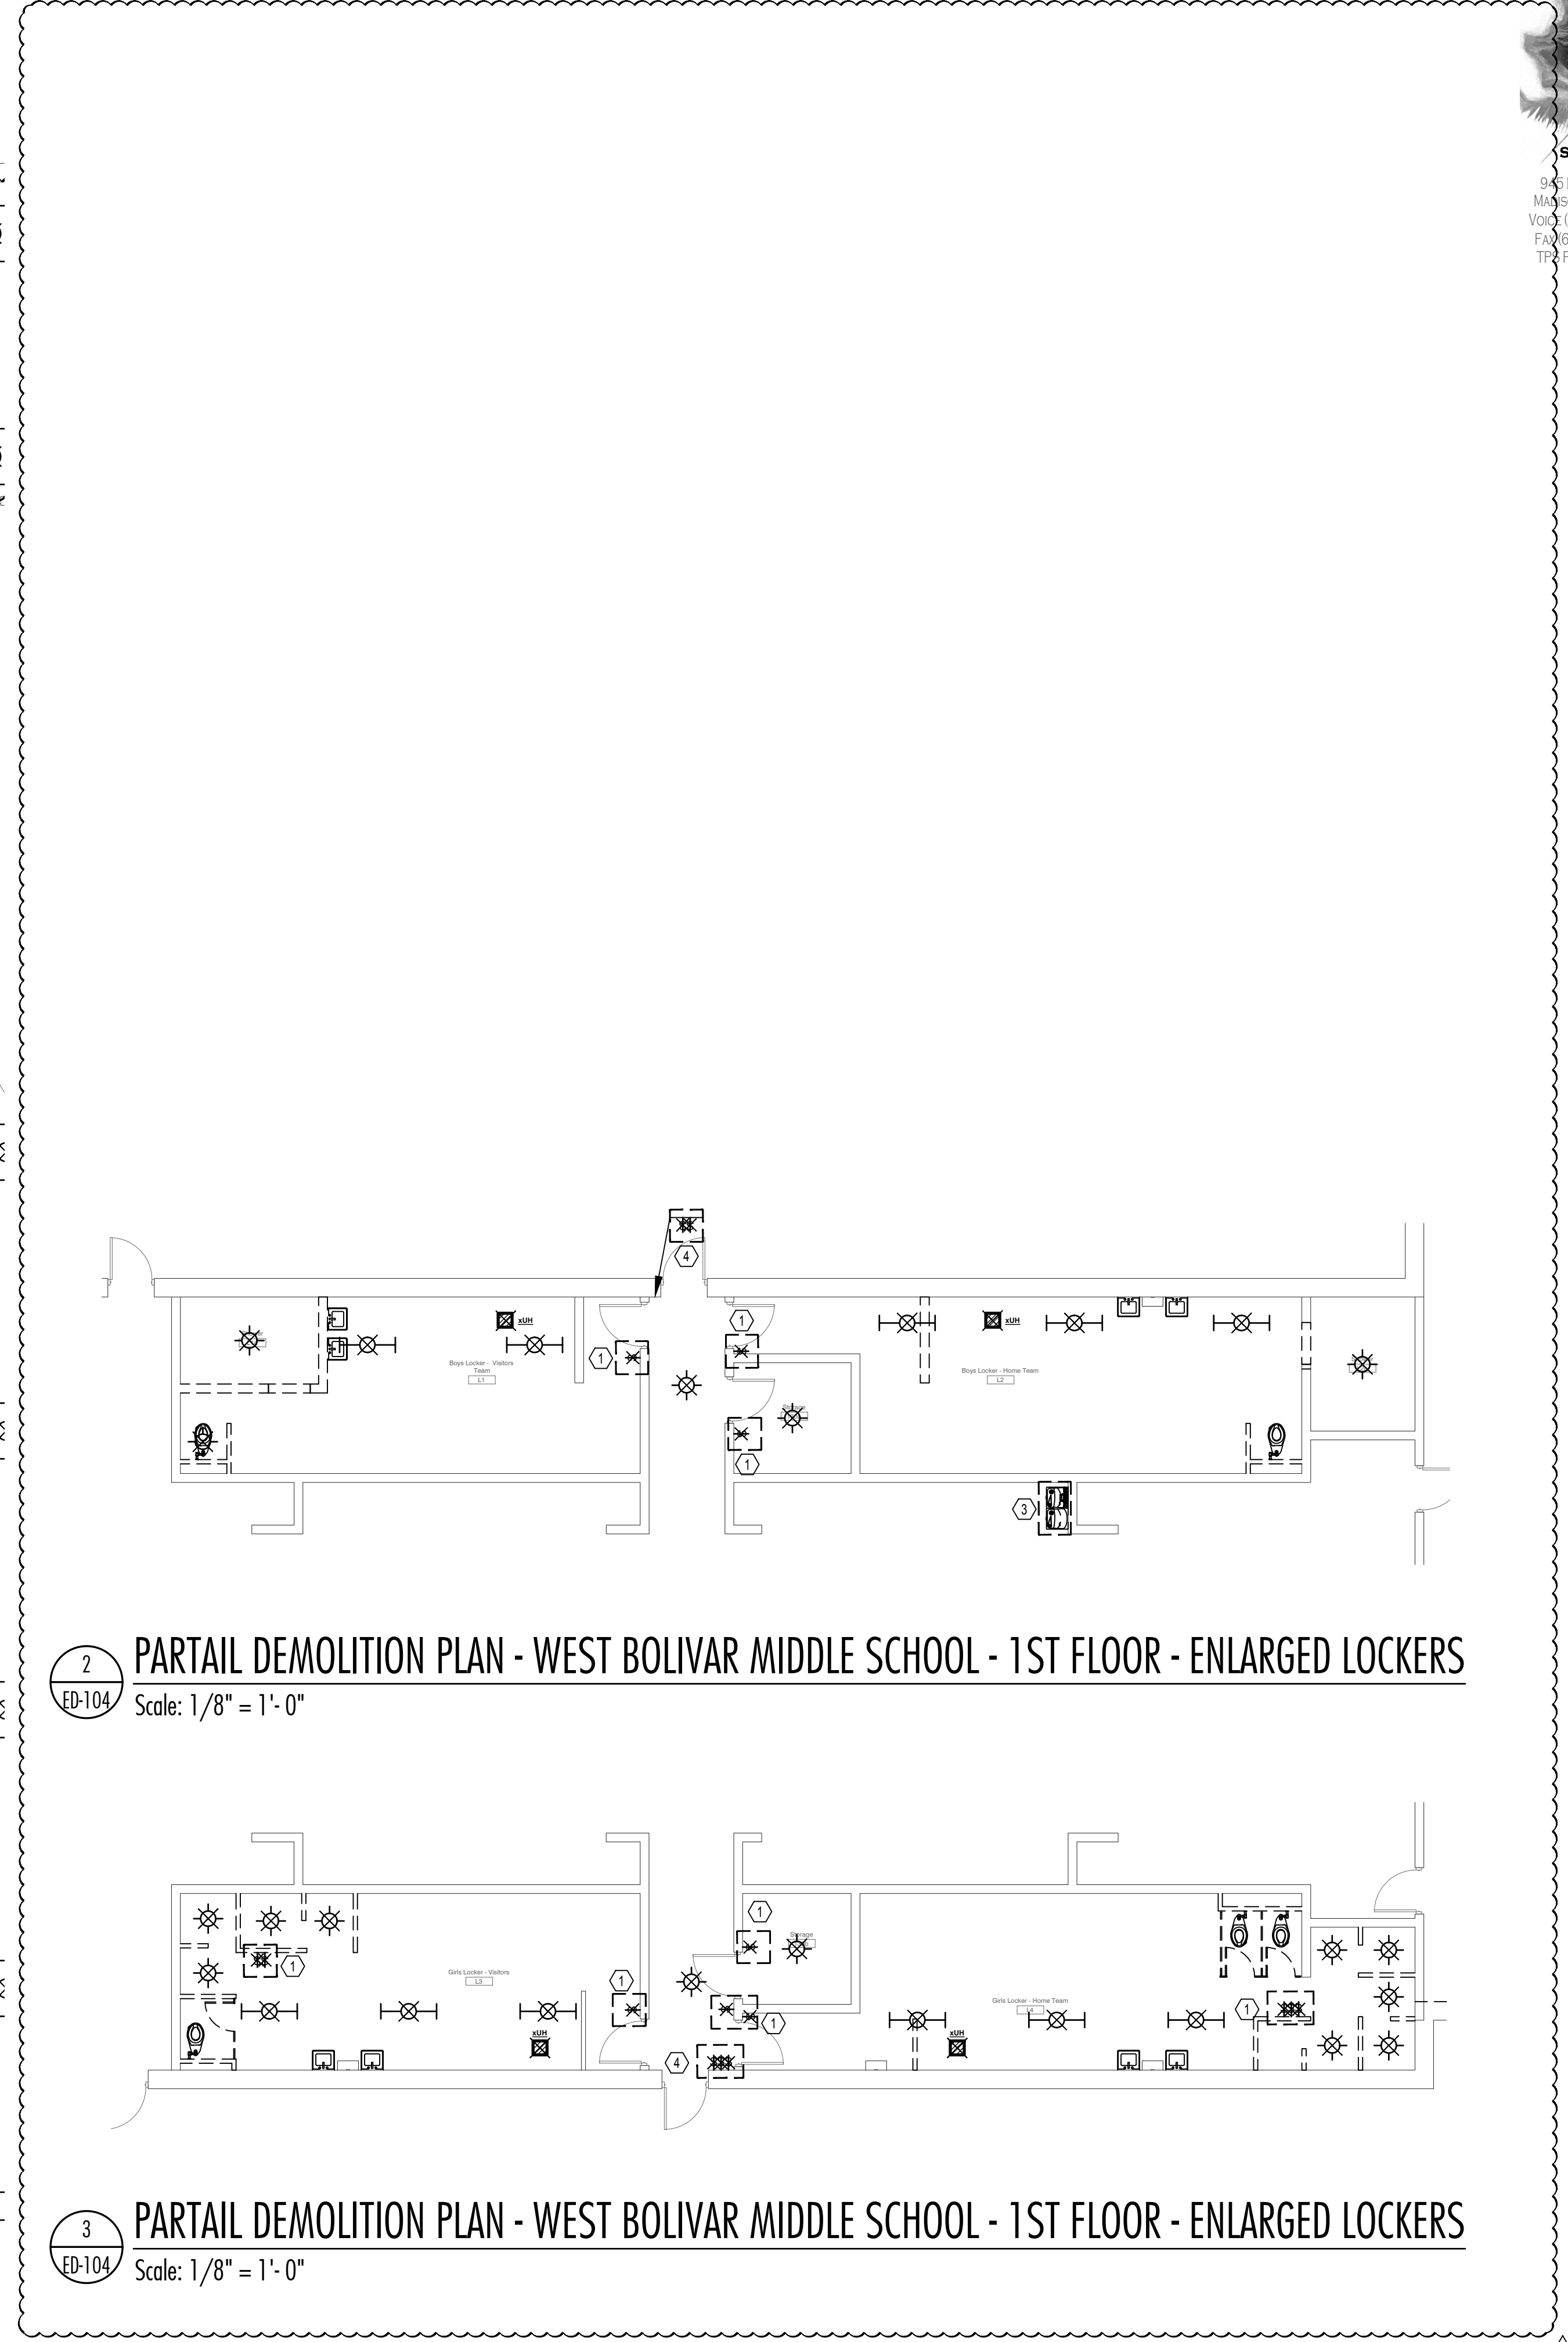


② ED-104 PARTIAL DEMOLITION PLAN - WEST BOLIVAR MIDDLE SCHOOL - 1ST FLOOR - ENLARGED LOCKERS
Scale: 1/8" = 1'-0"

③ ED-104 PARTIAL DEMOLITION PLAN - WEST BOLIVAR MIDDLE SCHOOL - 1ST FLOOR - ENLARGED LOCKERS
Scale: 1/8" = 1'-0"

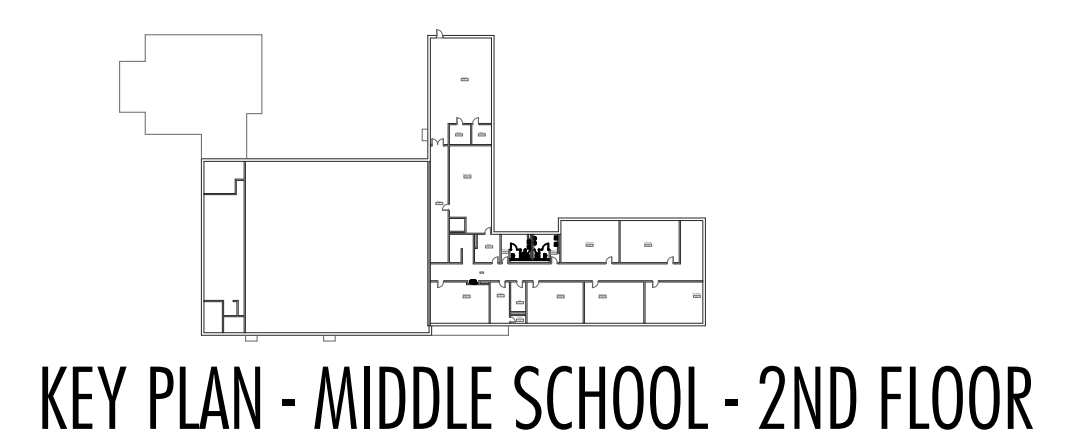

KEY PLAN - MIDDLE SCHOOL - 2ND FLOOR

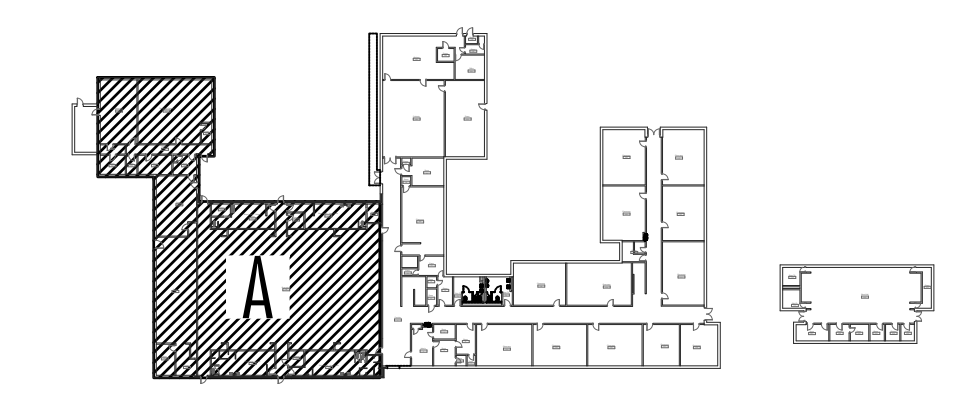


KEY PLAN - MIDDLE SCHOOL - 1ST FLOOR

THE POWER SOURCE LLC
TR# PROJ # 20062

AN ASSOCIATION
MISSISSIPPI

DALE BAILEY
JACKSON • BILOXI

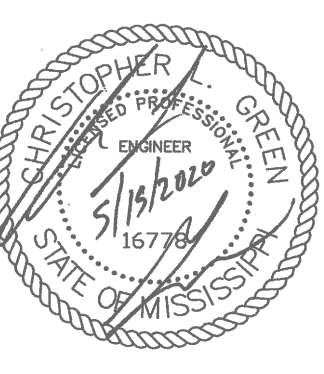


West Bolivar Consolidated School District Renovation Project

100% Construction Documents

Project No	20018
Date	2020-05-15
Drawn	FAB
Checked	CLG
Revisions	Rev Date
ADD#2	2020-06-12

West Bolivar Middle School
ED-104
PARTIAL DEMOLITION PLAN - PART A

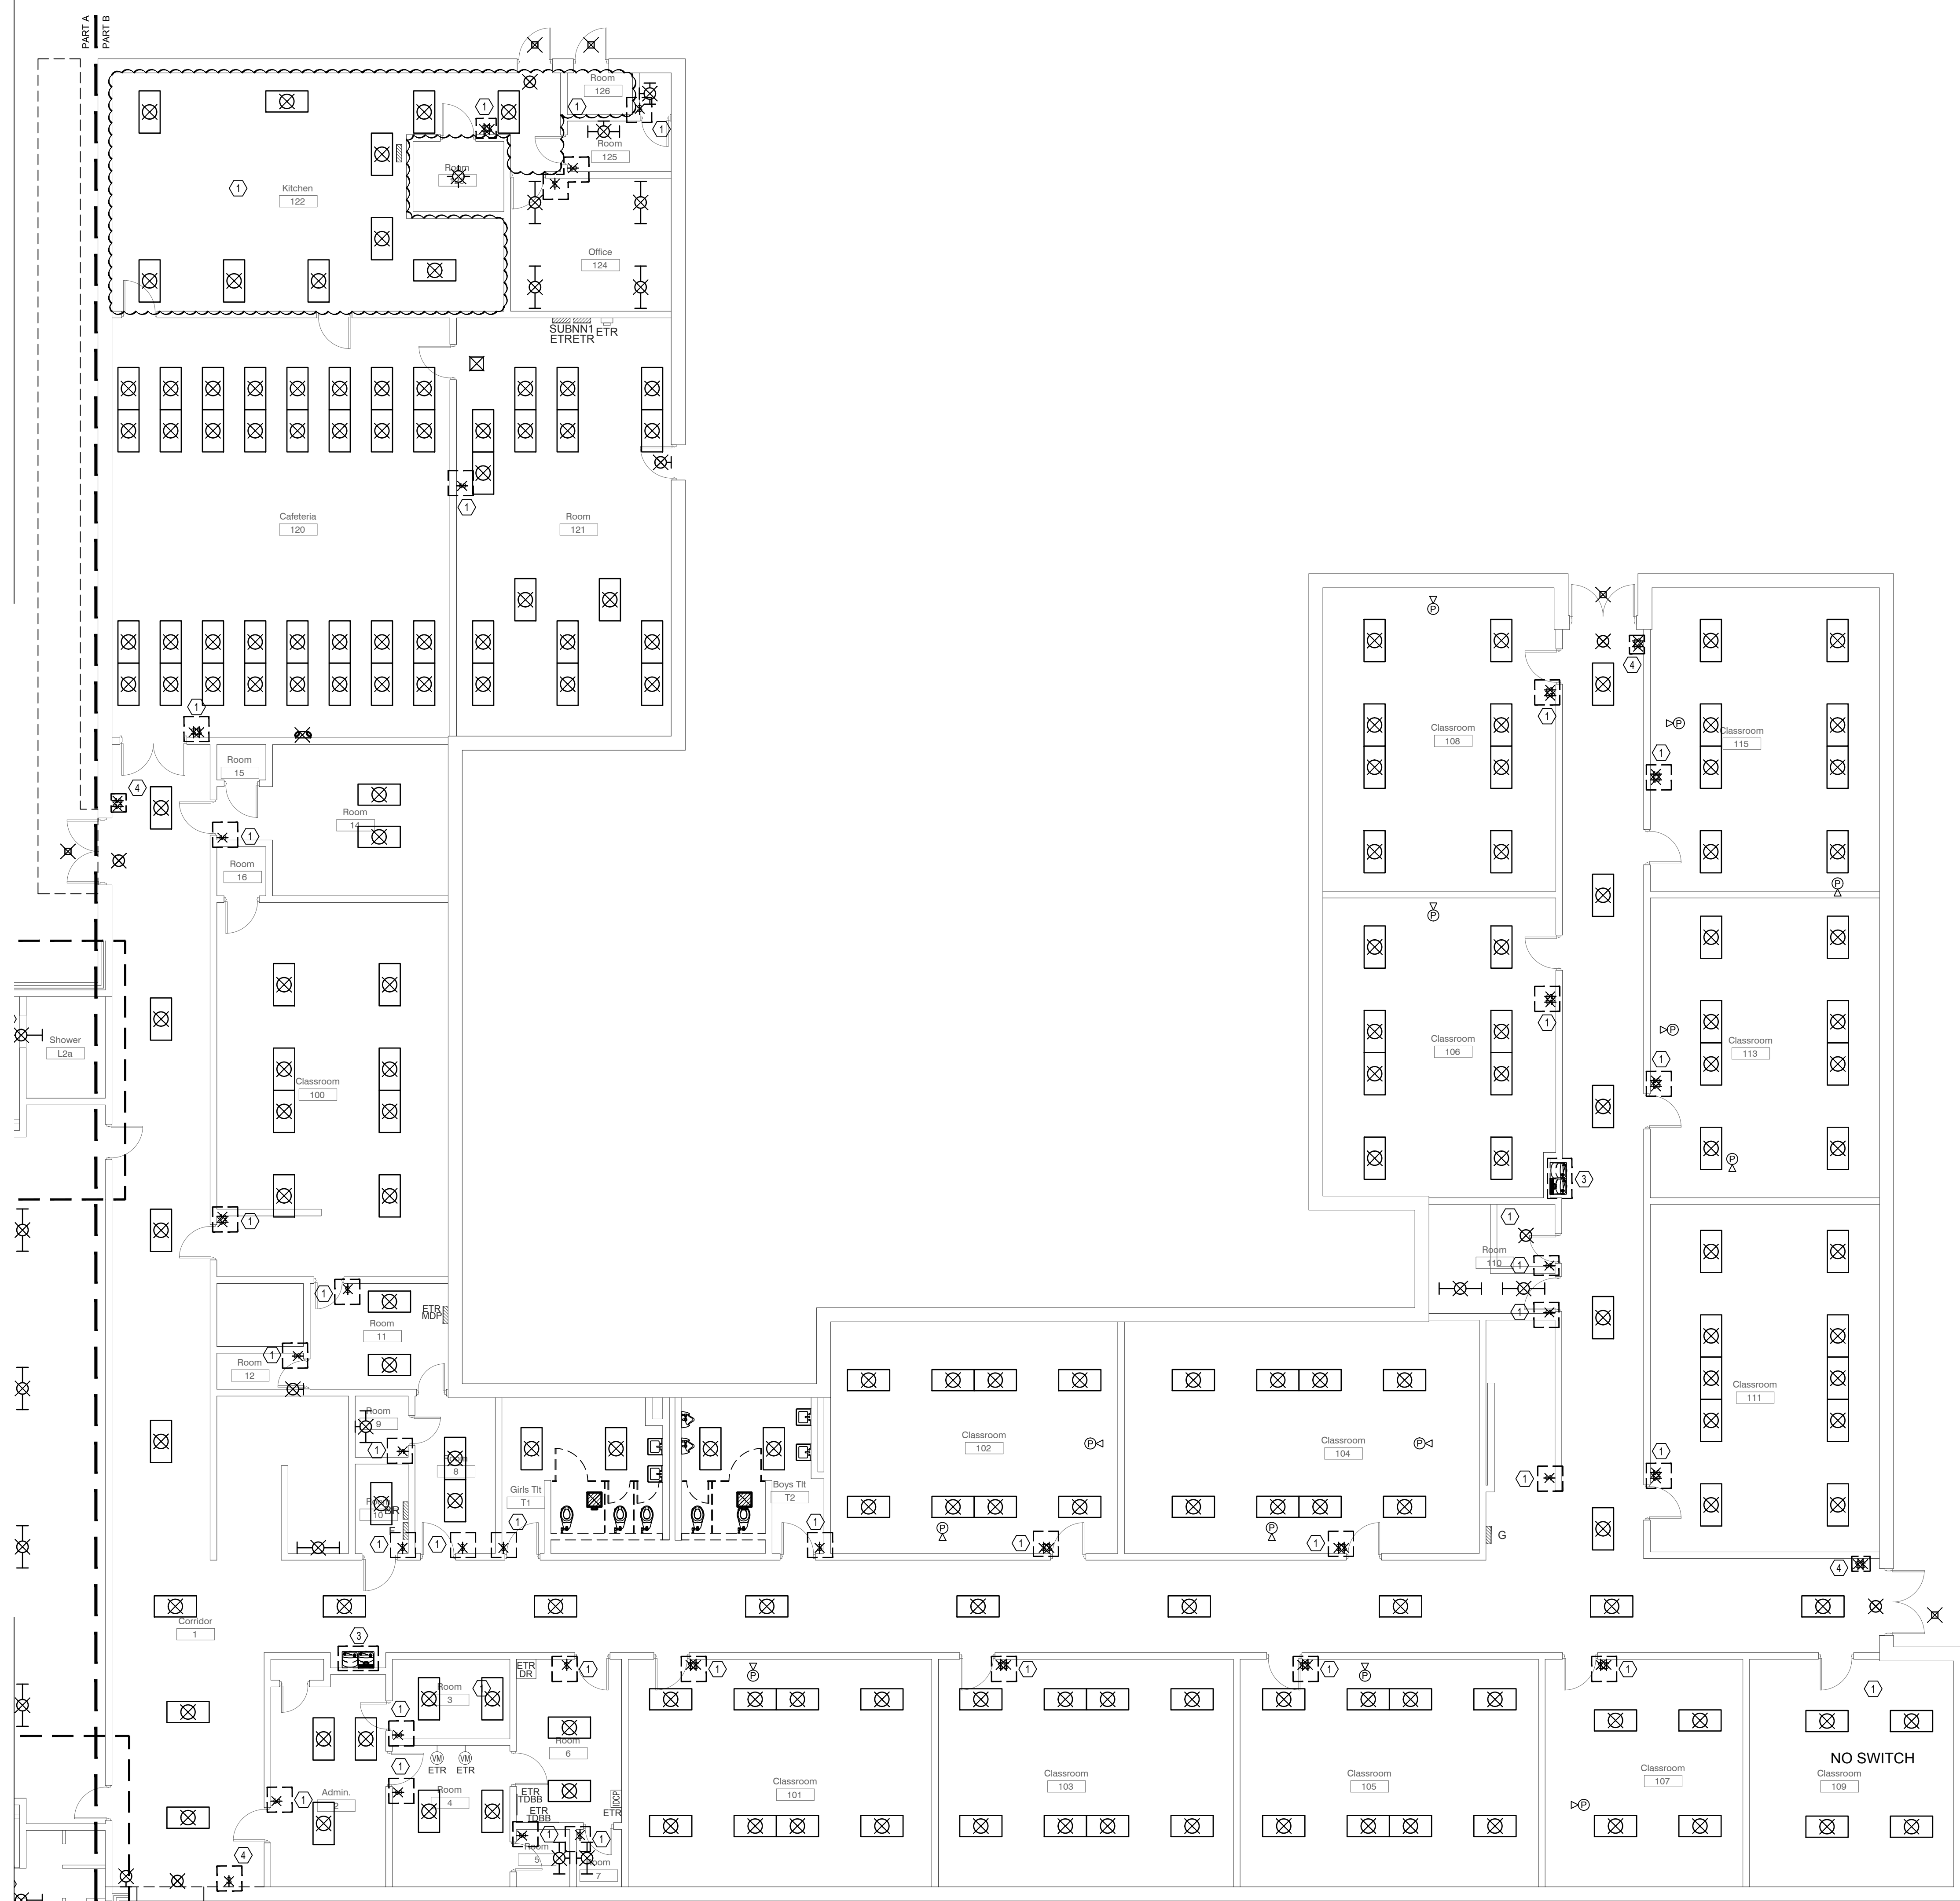


MASTER DEMOLITION KEYED NOTES

Mark	Description
①	FIELD VERIFY LOCATION AND NUMBER OF EXISTING SWITCHES CONTROLLING LIGHTING FIXTURES AND CEILING FANS. EXISTING LIGHTING FIXTURE SWITCHES SHALL BE DEMOLISHED AND REPLACED WITH A NEW SWITCHING DEVICE THAT SHALL CONTROL ALL LIGHTING FIXTURES IN THE AREA. EXISTING FAN SWITCH SHALL BE DEMOLISHED. IT IS THE INTENT TO RE-USE ONE OF THE EXISTING SWITCH BOXES IF NO CEILING FAN IS PRESENT. UN-USED BOX/BOXES SHALL BE COVERED WITH A BLANK PLATE. SEE LIGHTING PLANS FOR NEW SWITCHING DEVICES.
②	FIXTURE MOUNTED ABOVE BLEACHERS.
③	ALTERNATE #2 (WEST BOLIVAR HIGH & MCEVANS) ALTERNATE #3 (WEST BOLIVAR ELEMENTARY) DRINKING FOUNTAIN SHALL BE DEMOLISHED AND REPLACED WITH A NEW DRINKING FOUNTAIN. REPLACE EXISTING RECEPTACLE WITH A NEW GFI RECEPTACLE AND CONNECT BACK TO THE ORIGINAL CIRCUITRY. FIELD VERIFY ALL LOCATIONS OF EXISTING DRINKING FOUNTAINS. THOSE THAT ARE NOT SHOWN ON THE PLAN SHALL BE REPLACED IN THE SAME MANNER.
④	SEE GENERAL NOTE #3 ON LIGHTING PLANS FOR SWITCHING INFORMATION.

NOTE:
IF A KEYED NOTE IS NOT SHOWN ON A DRAWING, THEN THE KEYED NOTE SHALL BE IGNORED FOR THAT PARTICULAR DRAWING. THIS SHALL DIFFER FROM DRAWING TO DRAWING.



GENERAL NOTES

Mark	Description
1.	DEMOLISH ALL EXISTING TV'S AND ASSOCIATED CABLING/CONDUIT IN EACH CLASSROOM.

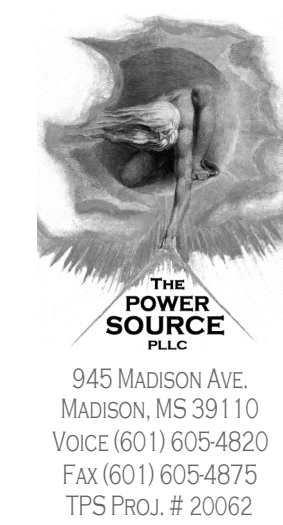


945 MADISON AVE.
MADISON, MS 39110
TPS PROJ. # 20062

AN ASSOCIATION
DALE BAILEY
JACKSON • BILOXI

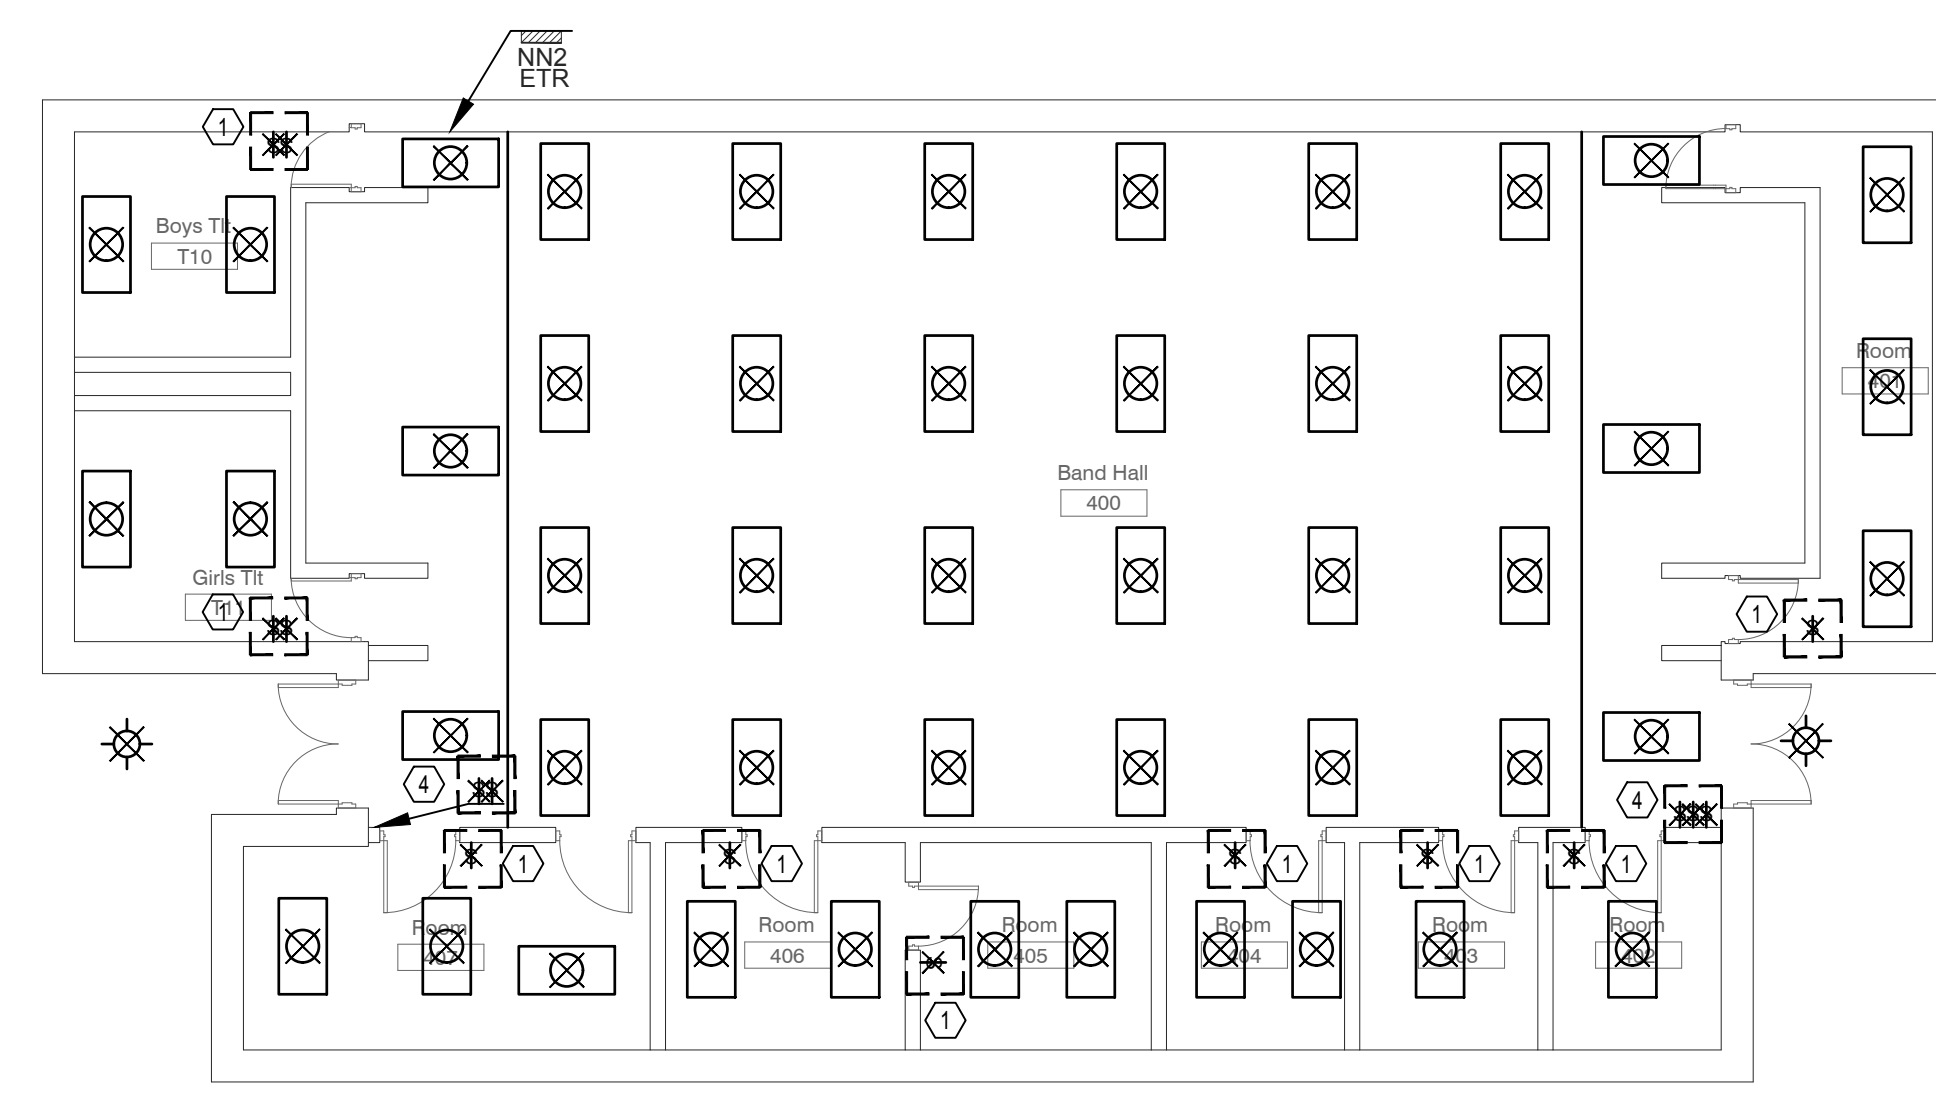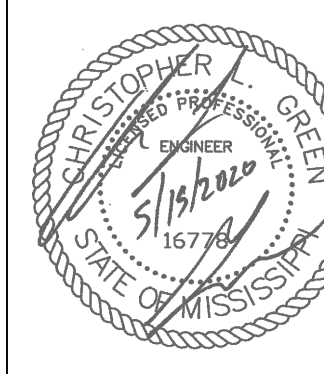

KEY PLAN - MIDDLE SCHOOL - 2ND FLOOR

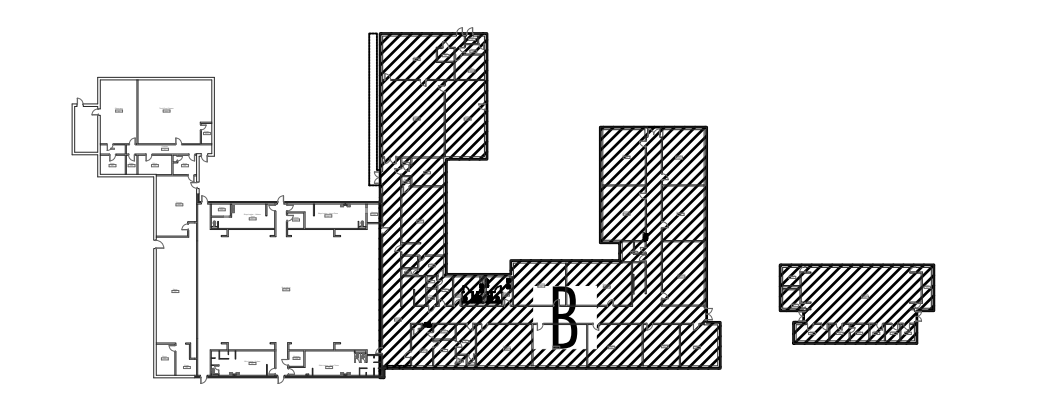

KEY PLAN - MIDDLE SCHOOL - 1ST FLOOR

1 PARTIAL DEMOLITION PLAN - WEST BOLIVAR MIDDLE SCHOOL - 1ST FLOOR - PART B
ED-105 Scale: 1/8" = 1'-0"

West Bolivar Consolidated School District Renovation Project

100% Construction Documents

Project No	20018
Date	2020-05-15
Drawn	FAB
Checked	CLG
Revisions	Rev Date
▲ ADD#2	2020-06-12


West Bolivar Middle School
ED-105
PARTIAL DEMOLITION PLAN - PART B

MASTER DEMOLITION KEYED NOTES

Mark	Description
①	FIELD VERIFY LOCATION AND NUMBER OF EXISTING SWITCHES CONTROLLING LIGHTING FIXTURES AND CEILING FANS. EXISTING LIGHTING FIXTURE SWITCHES SHALL BE DEMOLISHED AND REPLACED WITH A NEW SWITCHING DEVICE THAT SHALL CONTROL ALL LIGHTING FIXTURES IN THE AREA. EXISTING FAN SWITCH SHALL BE DEMOLISHED. IT IS THE INTENT TO RE-USE ONE OF THE EXISTING SWITCH BOXES IF NO CEILING FAN IS PRESENT. UN-USED BOX/BOXES SHALL BE COVERED WITH A BLANK PLATE. SEE LIGHTING PLANS FOR NEW SWITCHING DEVICES.
②	FIXTURE MOUNTED ABOVE BLEACHERS.
③	ALTERNATE #2: (WEST BOLIVAR HIGH & MCEVANS) ALTERNATE #5: (WEST BOLIVAR ELEMENTARY) DRINKING FOUNTAIN SHALL BE DEMOLISHED AND REPLACED WITH A NEW DRINKING FOUNTAIN. REPLACE EXISTING RECEPTACLE WITH A NEW GFI RECEPTACLE AND CONNECT BACK TO THE ORIGINAL CIRCUITRY. FIELD VERIFY ALL LOCATIONS OF EXISTING DRINKING FOUNTAINS, THOSE THAT ARE NOT SHOWN ON THE PLAN SHALL BE REPLACED IN THE SAME MANNER.
④	SEE GENERAL NOTE #3 ON LIGHTING PLANS FOR SWITCHING INFORMATION.
NOTE:	IF A KEYED NOTE IS NOT SHOWN ON A DRAWING, THEN THE KEYED NOTE SHALL BE IGNORED FOR THAT PARTICULAR DRAWING. THIS SHALL DIFFER FROM DRAWING TO DRAWING.

GENERAL NOTES

Mark	Description
1.	DEMOLISH ALL EXISTING TV'S AND ASSOCIATED CABLING/CONDUIT IN EACH CLASSROOM.

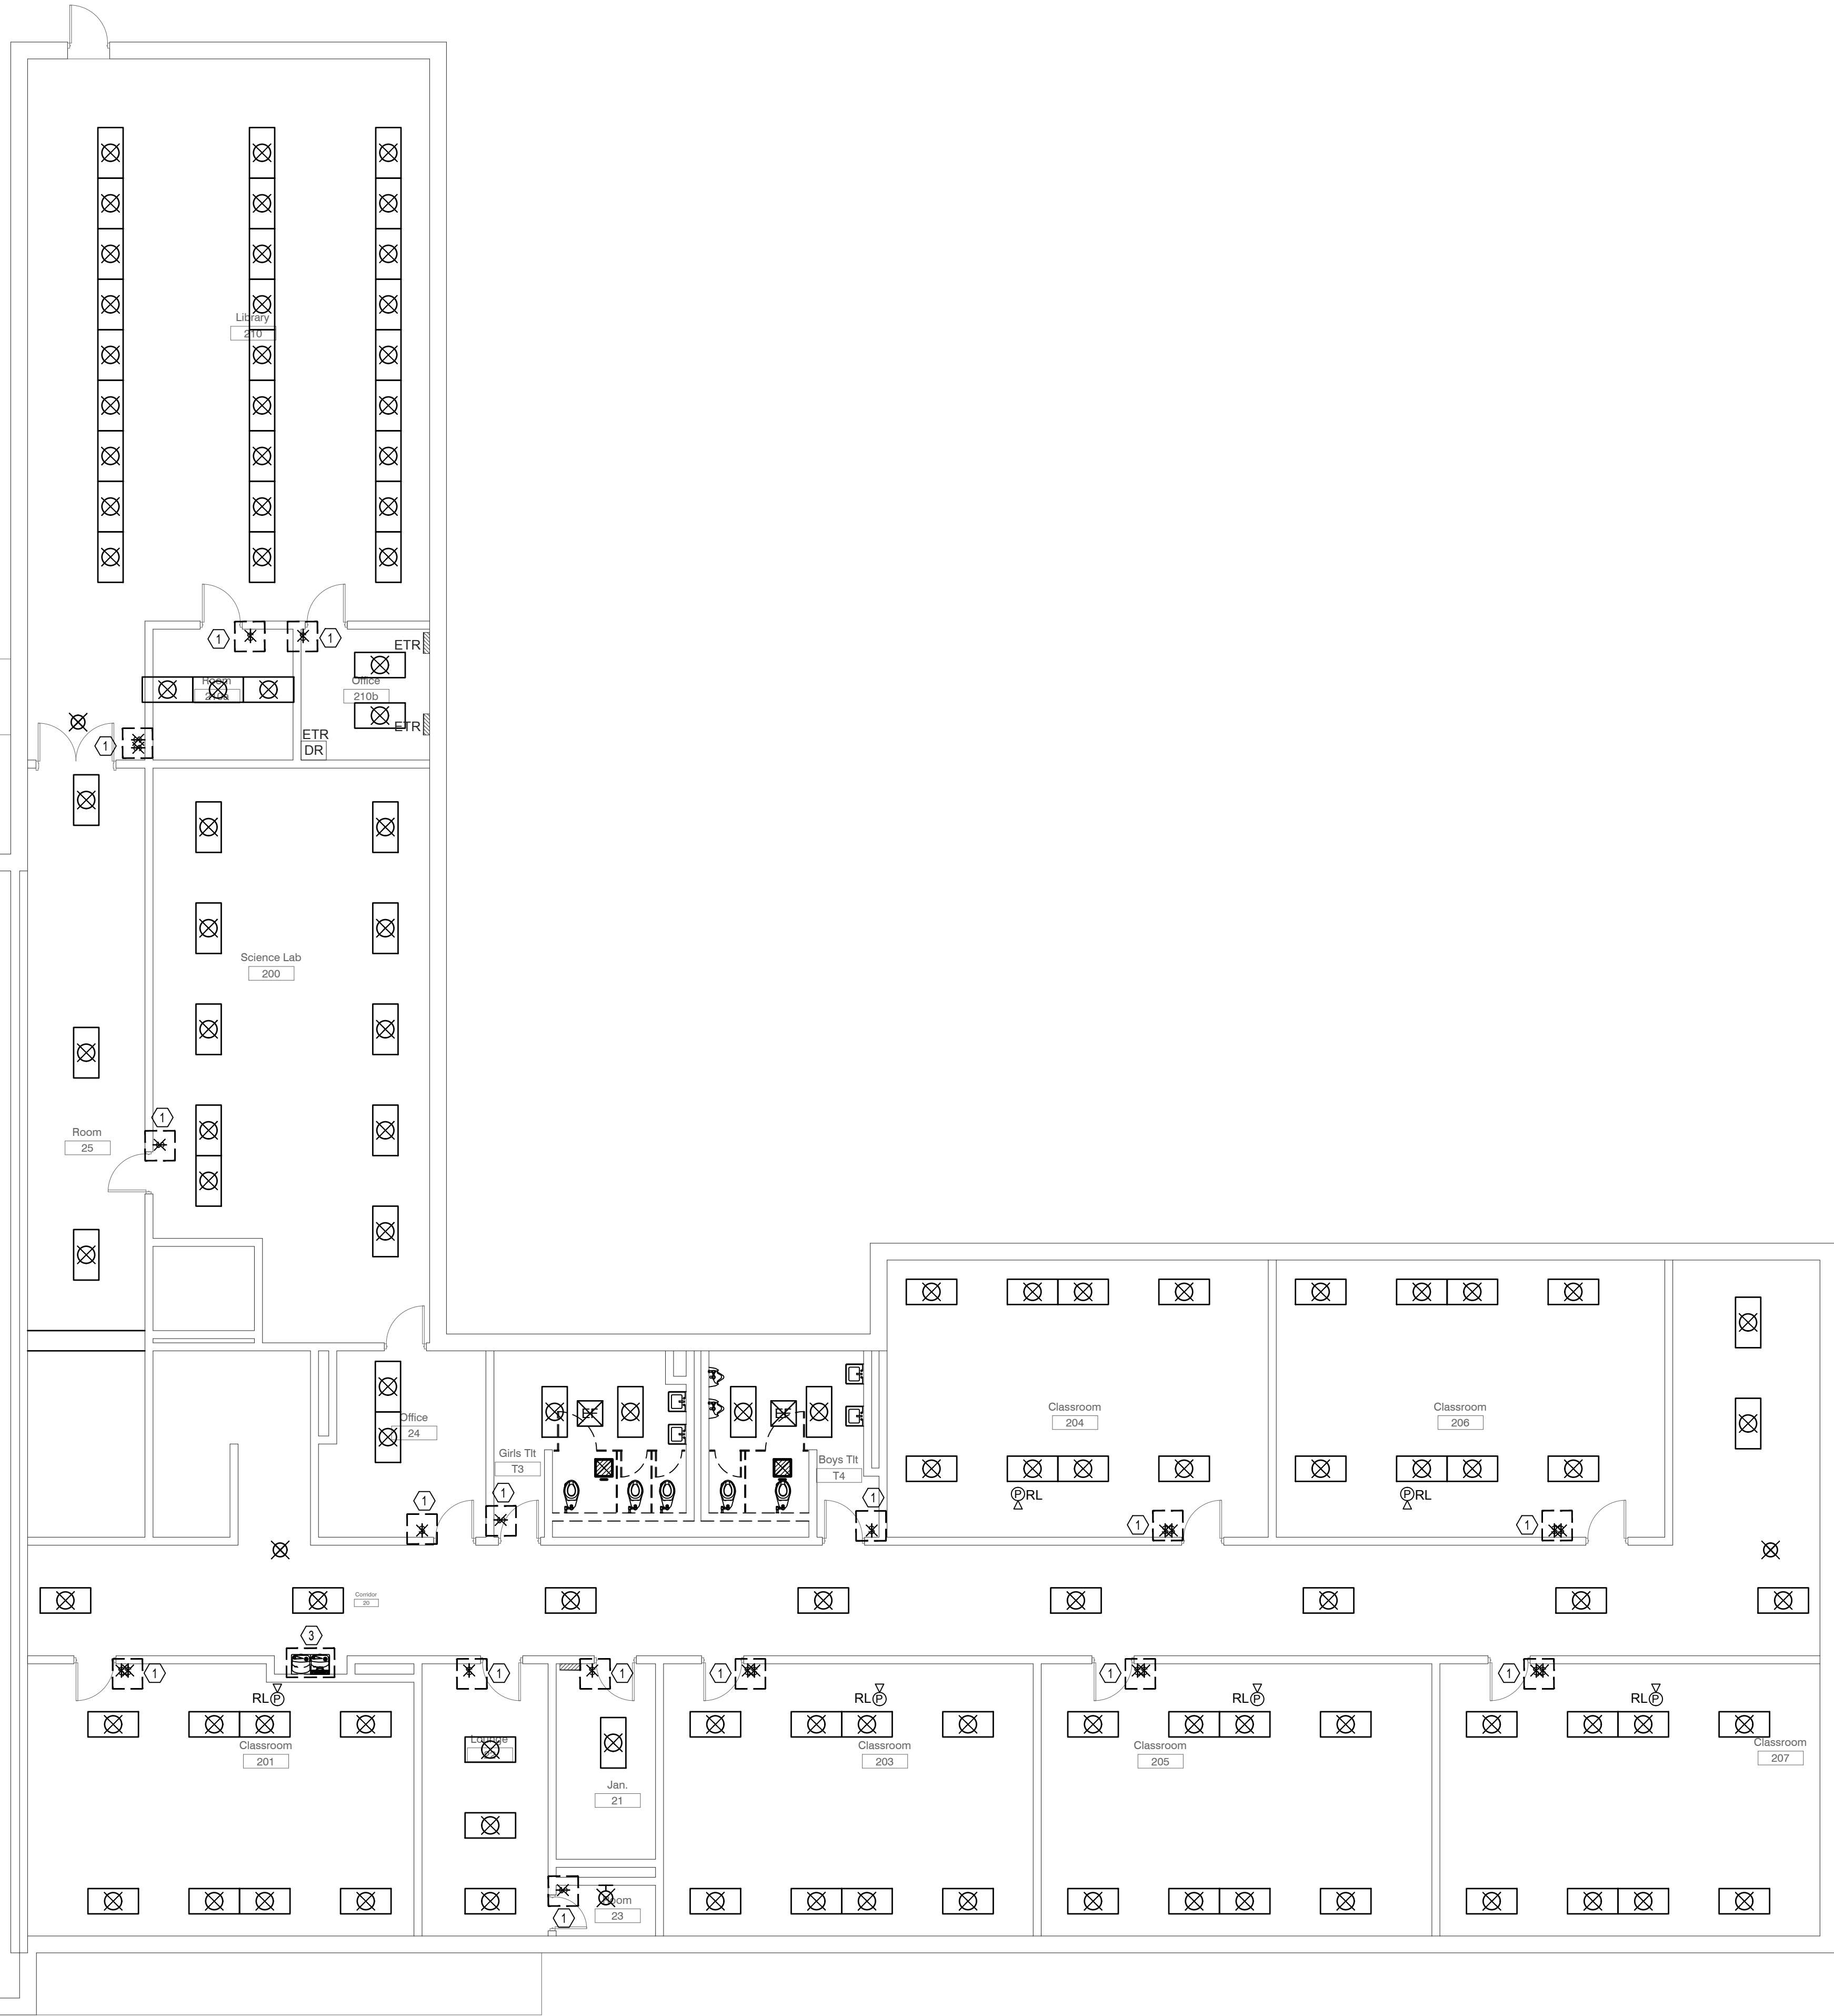

945 MADISON AVE.
MADISON, MS 39110
VOICE (601) 605-4820
FAX (601) 605-4875
TPS PROJ. # 20062

AN ASSOCIATION
DALE BAILEY
JACKSON • BILOXI





West Bolivar Consolidated School District Renovation Project


100% Construction Documents

Project No	20018
Date	2020-05-15
Drawn	FAB
Checked	CLG
Revisions	Rev Date
▲ ADD#2	2020-06-12

West Bolivar Middle School
ED-106
PARTIAL DEMOLITION PLAN - PART C

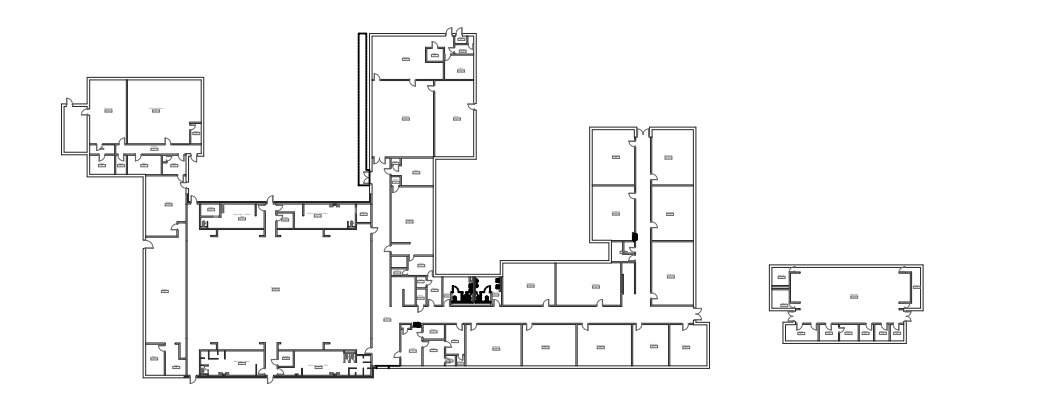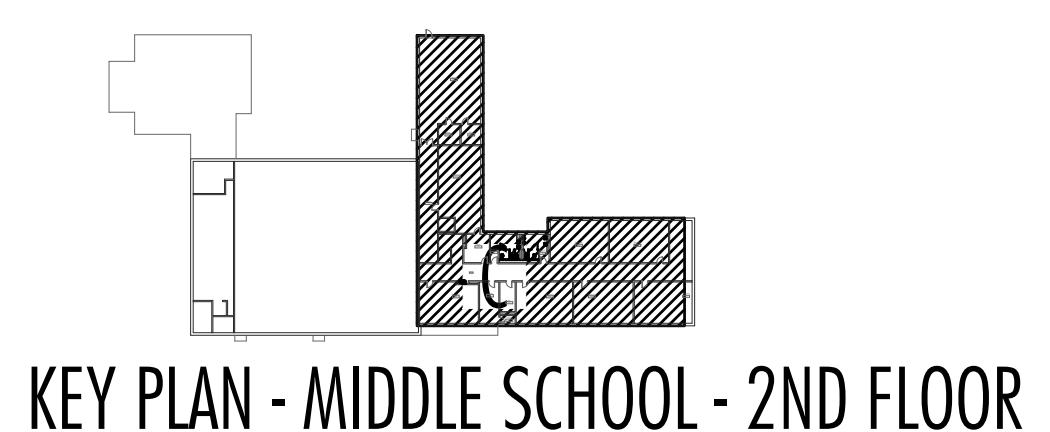


PARTIAL DEMOLITION PLAN - WEST BOLIVAR MIDDLE SCHOOL - 2ND FLOOR - PART C
Scale: 1/8" = 1'-0"

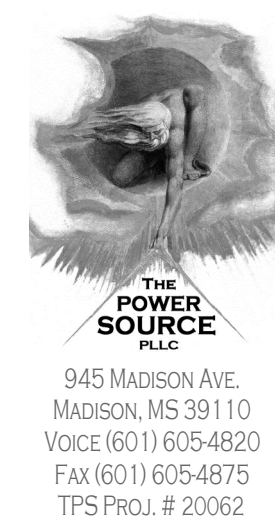

945 MADISON AVE.
MADISON, MS 39110
VOICE (601) 605-4820
FAX (601) 605-4875
TPS PROJ. # 20062

AN ASSOCIATION
M I S S I S S I P P I

DALE BAILEY
JACKSON • BILOXI

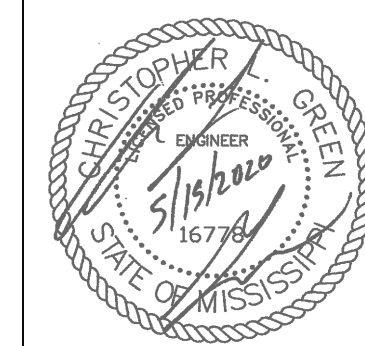

West Bolivar Consolidated School
District Renovation Project

100%
Construction
Documents

Project No	20018
Date	2020-05-15
Drawn	FAB
Checked	CLG
Revisions	Rev Date
△ ADD#2	2020-06-12

McEvans Elementary School

ED-107
OVERALL DEMOLITION
PLAN


MASTER DEMOLITION KEYED NOTES

Mark	Description
①	FIELD VERIFY LOCATION AND NUMBER OF EXISTING SWITCH/SWITCHES CONTROLLING LIGHTING FIXTURES AND CEILING FANS. EXISTING LIGHTING FIXTURE SWITCHES SHALL BE DEMOLISHED AND REPLACED WITH A NEW SWITCHING DEVICE THAT SHALL CONTROL ALL LIGHTING FIXTURES IN THE AREA. EXISTING FAN SWITCH SHALL BE DEMOLISHED. IT IS THE INTENT TO RE-USE ONE OF THE EXISTING SWITCH BOXES IF NO CEILING FAN IS PRESENT. UN-USED BOX/BOXES SHALL BE COVERED WITH A BLANK PLATE. SEE LIGHTING PLANS FOR NEW SWITCHING DEVICES.
②	FIXTURE MOUNTED ABOVE BLEACHERS.
③	ALTERNATE #2 (WEST BOLIVAR HIGH & MCEVANS) ALTERNATE #5 (WEST BOLIVAR ELEMENTARY) DRINKING FOUNTAIN SHALL BE DEMOLISHED AND REPLACED WITH A NEW DRINKING FOUNTAIN. REPLACE EXISTING RECEPTACLE WITH A NEW GFI RECEPTACLE AND CONNECT BACK TO THE ORIGINAL CIRCUITRY. FIELD VERIFY ALL LOCATIONS OF EXISTING DRINKING FOUNTAINS. THOSE THAT ARE NOT SHOWN ON THE PLAN SHALL BE REPLACED IN THE SAME MANNER.
④	SEE GENERAL NOTE #3 ON LIGHTING PLANS FOR SWITCHING INFORMATION.

NOTE:
IF A KEYED NOTE IS NOT SHOWN ON A DRAWING, THEN THE KEYED NOTE SHALL BE IGNORED FOR THAT PARTICULAR DRAWING. THIS SHALL DIFFER FROM DRAWING TO DRAWING.

GENERAL NOTES

Mark	Description
1	DEMOLISH ALL EXISTING TV'S AND ASSOCIATED CABLING/CONDUIT IN EACH CLASSROOM.

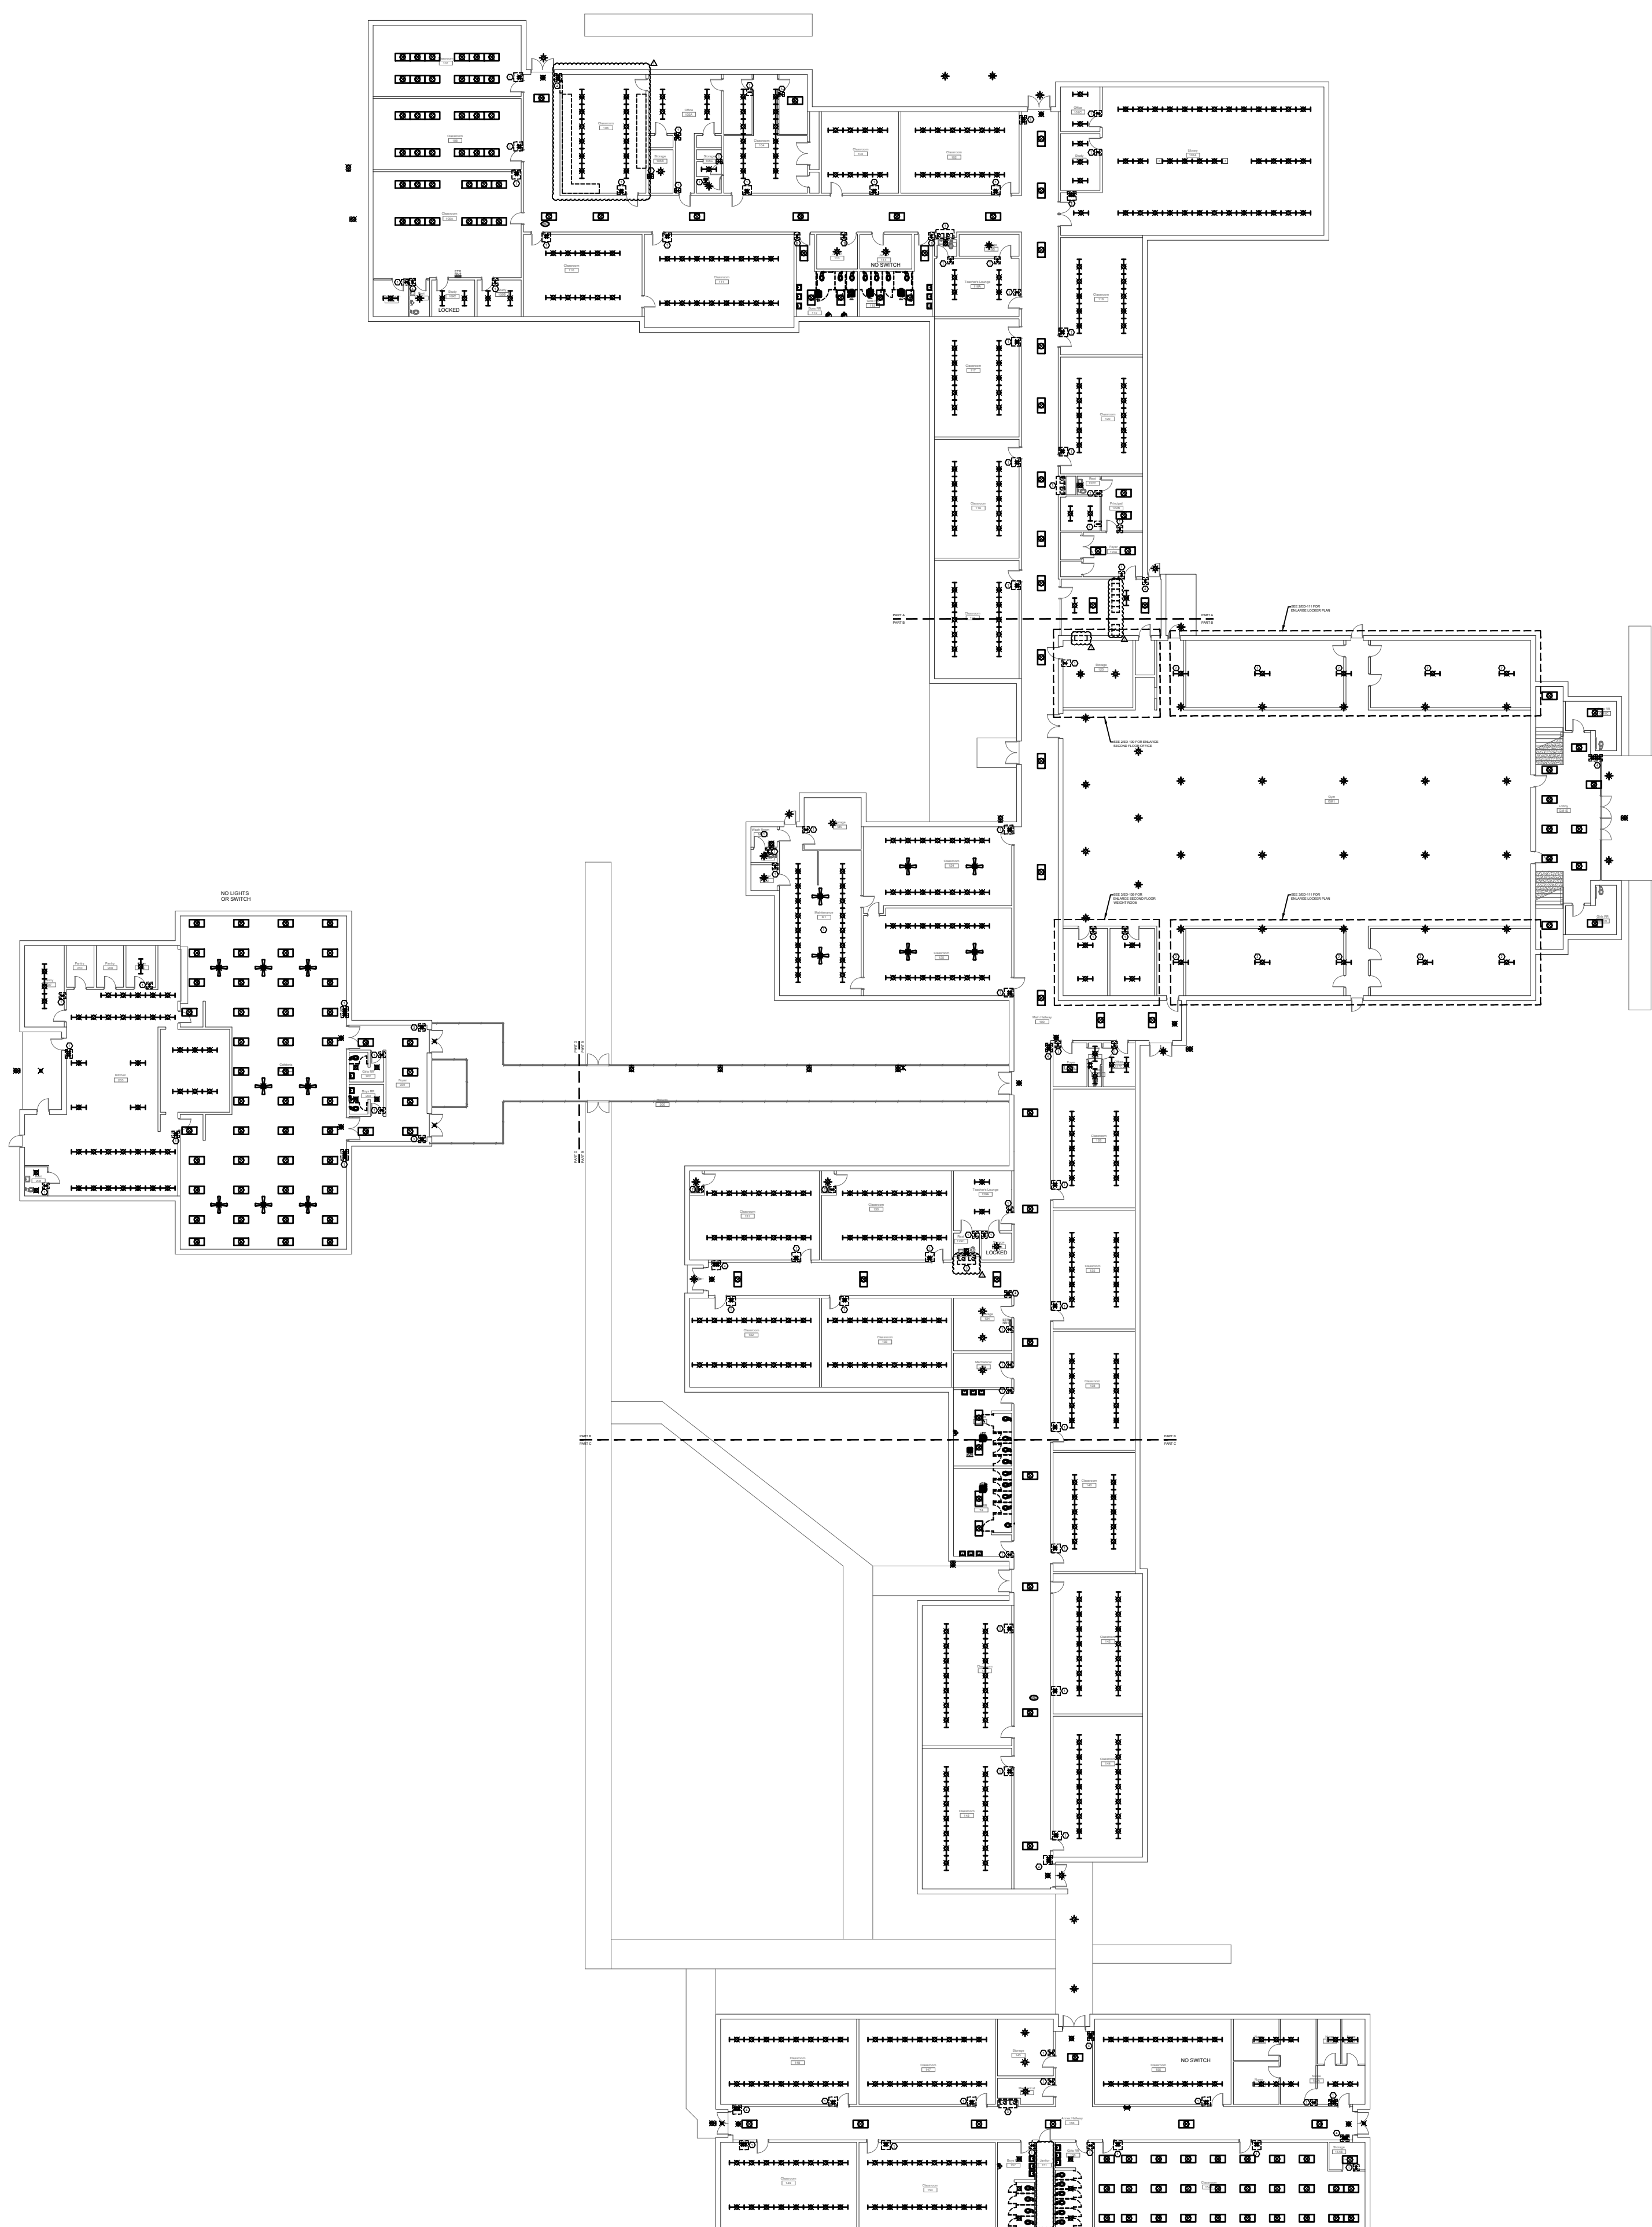


① OVERALL DEMOLITION PLAN - MCEVANS ELEMENTARY SCHOOL
ED-107 Scale: 1" = 30'-0"

GENERAL NOTES	
Mark	Description
1.	DEMOLISH ALL EXISTING TV'S AND ASSOCIATED CABLING/CONDUIT IN EACH CLASSROOM.


MASTER DEMOLITION KEYED NOTES	
Mark	Description
①	FIELD VERIFY LOCATION AND NUMBER OF EXISTING SWITCHES CONTROLLING LIGHTING FIXTURES AND CEILING FANS. EXISTING LIGHTING FIXTURE SWITCHES SHALL BE DEMOLISHED AND REPLACED WITH A NEW SWITCHING DEVICE THAT SHALL CONTROL ALL LIGHTING FIXTURES IN THE AREA. EXISTING FAN SWITCH SHALL BE DEMOLISHED. IT IS THE INTENT TO RE-USE ONE OF THE EXISTING SWITCH BOXES IF NO CEILING FAN IS PRESENT. UN-USED BOXES SHALL BE COVERED WITH A BLANK PLATE. SEE LIGHTING PLANS FOR NEW SWITCHING DEVICES.
②	FIXTURE MOUNTED ABOVE BLEACHERS.
③	ALTERNATE #2 (WEST BOLIVAR HIGH & MCEVANS) ALTERNATE #3 (WEST BOLIVAR ELEMENTARY) DRINKING FOUNTAIN SHALL BE DEMOLISHED AND REPLACED WITH A NEW DRINKING FOUNTAIN. REPLACE EXISTING RECEPTACLE WITH A NEW GFI RECEPTACLE AND CONNECT BACK TO THE ORIGINAL CIRCUITRY. FIELD VERIFY ALL LOCATIONS OF EXISTING DRINKING FOUNTAINS, THOSE THAT ARE NOT SHOWN ON THE PLAN SHALL BE REPLACED IN THE SAME MANNER.
④	SEE GENERAL NOTE #3 ON LIGHTING PLANS FOR SWITCHING INFORMATION.

NOTE:
IF A KEYED NOTE IS NOT SHOWN ON A DRAWING, THEN THE KEYED NOTE SHALL BE IGNORED FOR THAT PARTICULAR DRAWING. THIS SHALL DIFFER FROM DRAWING TO DRAWING.

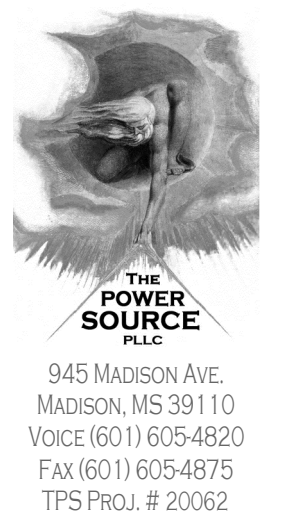

945 MADISON AVE.
MADISON, MS 39110

AN ASSOCIATION
DALE BAILEY
JACKSON • BILOXI

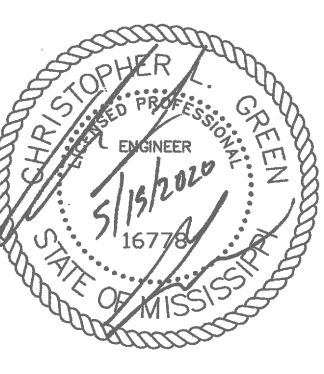


West Bolivar Consolidated School
District Renovation Project

100%
Construction
Documents

Project No	20018
Date	2020-05-15
Drawn	FAB
Checked	CLG
Revisions	Rev Date
▲ ADD#2	2020-06-12


McEvans Elementary School
ED-108
PARTIAL DEMOLITION
PLAN - PART A

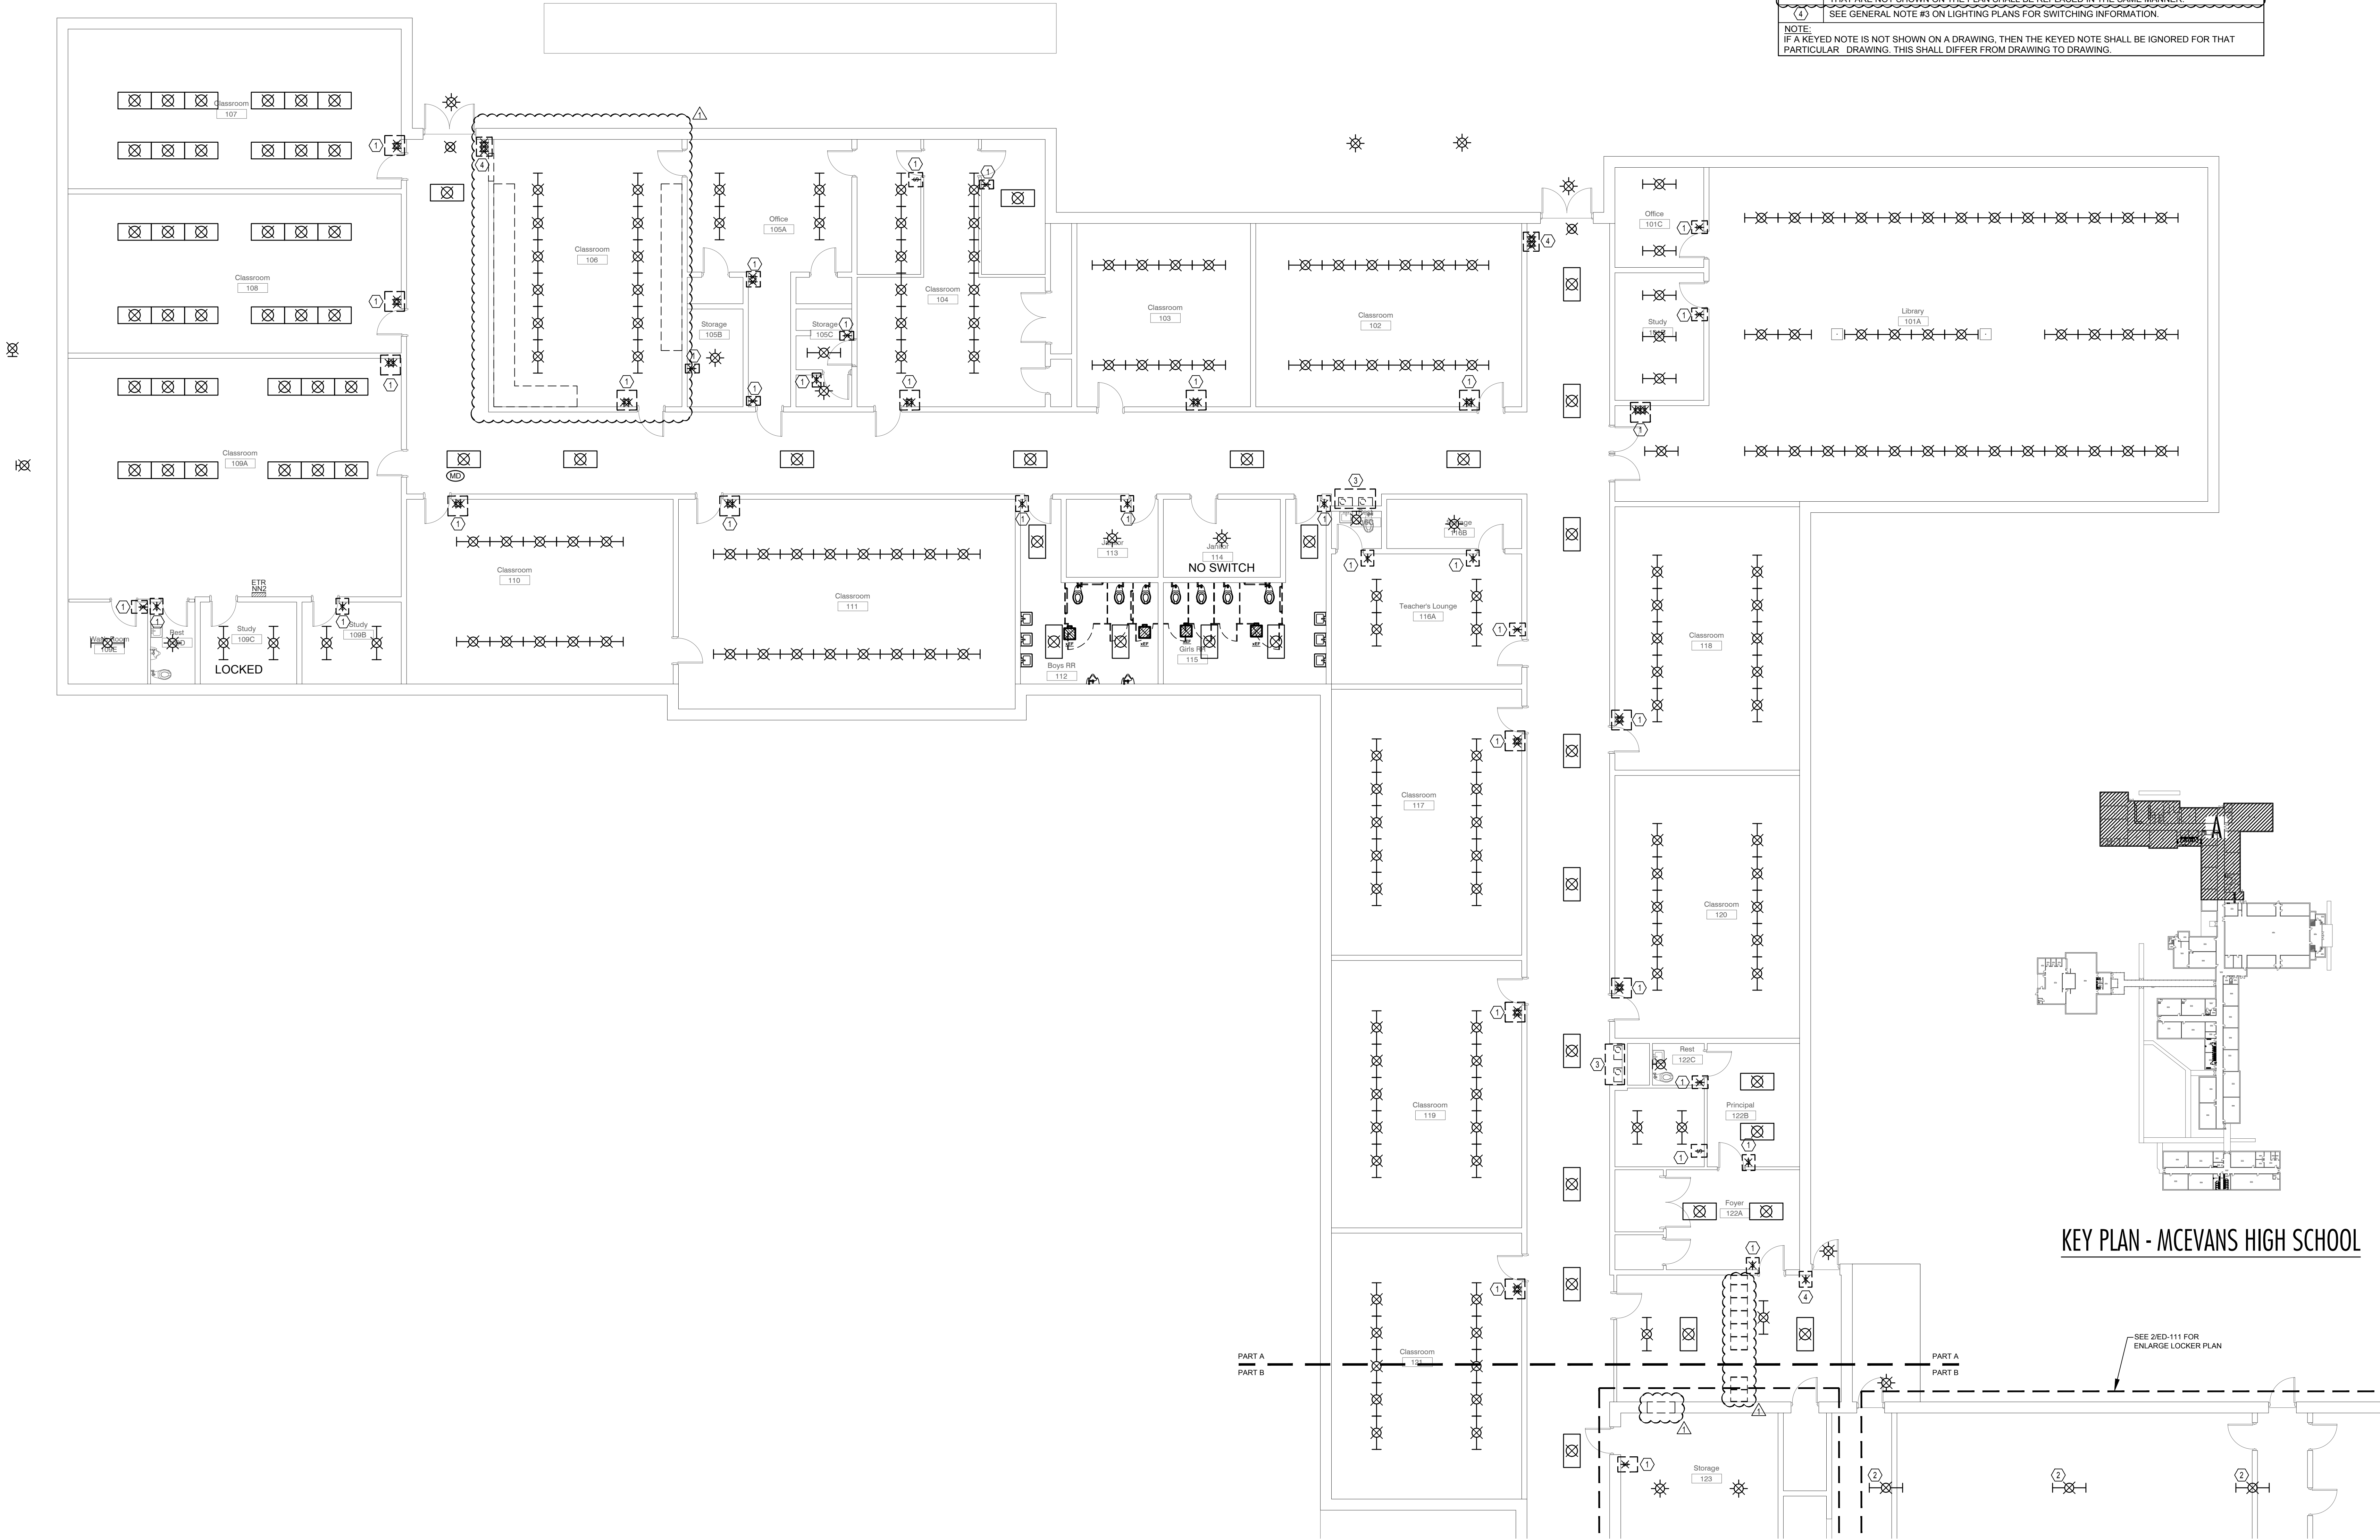

1 PARTIAL DEMOLITION PLAN - MCEVANS ELEMENTARY SCHOOL - PART A
ED-108 Scale: 1/8" = 1'-0"

MASTER DEMOLITION KEYED NOTES	
Mark	Description
①	FIELD VERIFY LOCATION AND NUMBER OF EXISTING SWITCHES/CONTROLLING LIGHTING FIXTURES AND CEILING FANS. EXISTING LIGHTING FIXTURE SWITCHES SHALL BE DEMOLISHED AND REPLACED WITH A NEW SWITCHING DEVICE THAT SHALL CONTROL ALL LIGHTING FIXTURES IN THE AREA. EXISTING FAN SWITCH SHALL BE DEMOLISHED. IT IS THE INTENT TO RE-USE ONE OF THE EXISTING SWITCH BOXES IF NO CEILING FAN IS PRESENT. UN-USED BOXES SHALL BE COVERED WITH A BLANK PLATE. SEE LIGHTING PLANS FOR NEW SWITCHING DEVICES.
②	FIXTURE MOUNTED ABOVE BLEACHERS.
③	ALTERNATE #2 (WEST BOLIVAR HIGH & MCEVANS) ALTERNATE #3 (WEST BOLIVAR ELEMENTARY) DRINKING FOUNTAIN SHALL BE DEMOLISHED AND REPLACED WITH A NEW DRINKING FOUNTAIN. REPLACE EXISTING RECEPTACLE WITH A NEW GFI RECEPTACLE AND CONNECT BACK TO THE ORIGINAL CIRCUITRY. FIELD VERIFY ALL LOCATIONS OF EXISTING DRINKING FOUNTAINS. THOSE THAT ARE NOT SHOWN ON THE PLAN SHALL BE REPLACED IN THE SAME MANNER.
④	SEE GENERAL NOTE #3 ON LIGHTING PLANS FOR SWITCHING INFORMATION.
NOTE:	IF A KEYED NOTE IS NOT SHOWN ON A DRAWING, THEN THE KEYED NOTE SHALL BE IGNORED FOR THAT PARTICULAR DRAWING. THIS SHALL DIFFER FROM DRAWING TO DRAWING.


GENERAL NOTES	
Mark	Description
1.	DEMOLISH ALL EXISTING TV'S AND ASSOCIATED CABLING/CONDUIT IN EACH CLASSROOM.

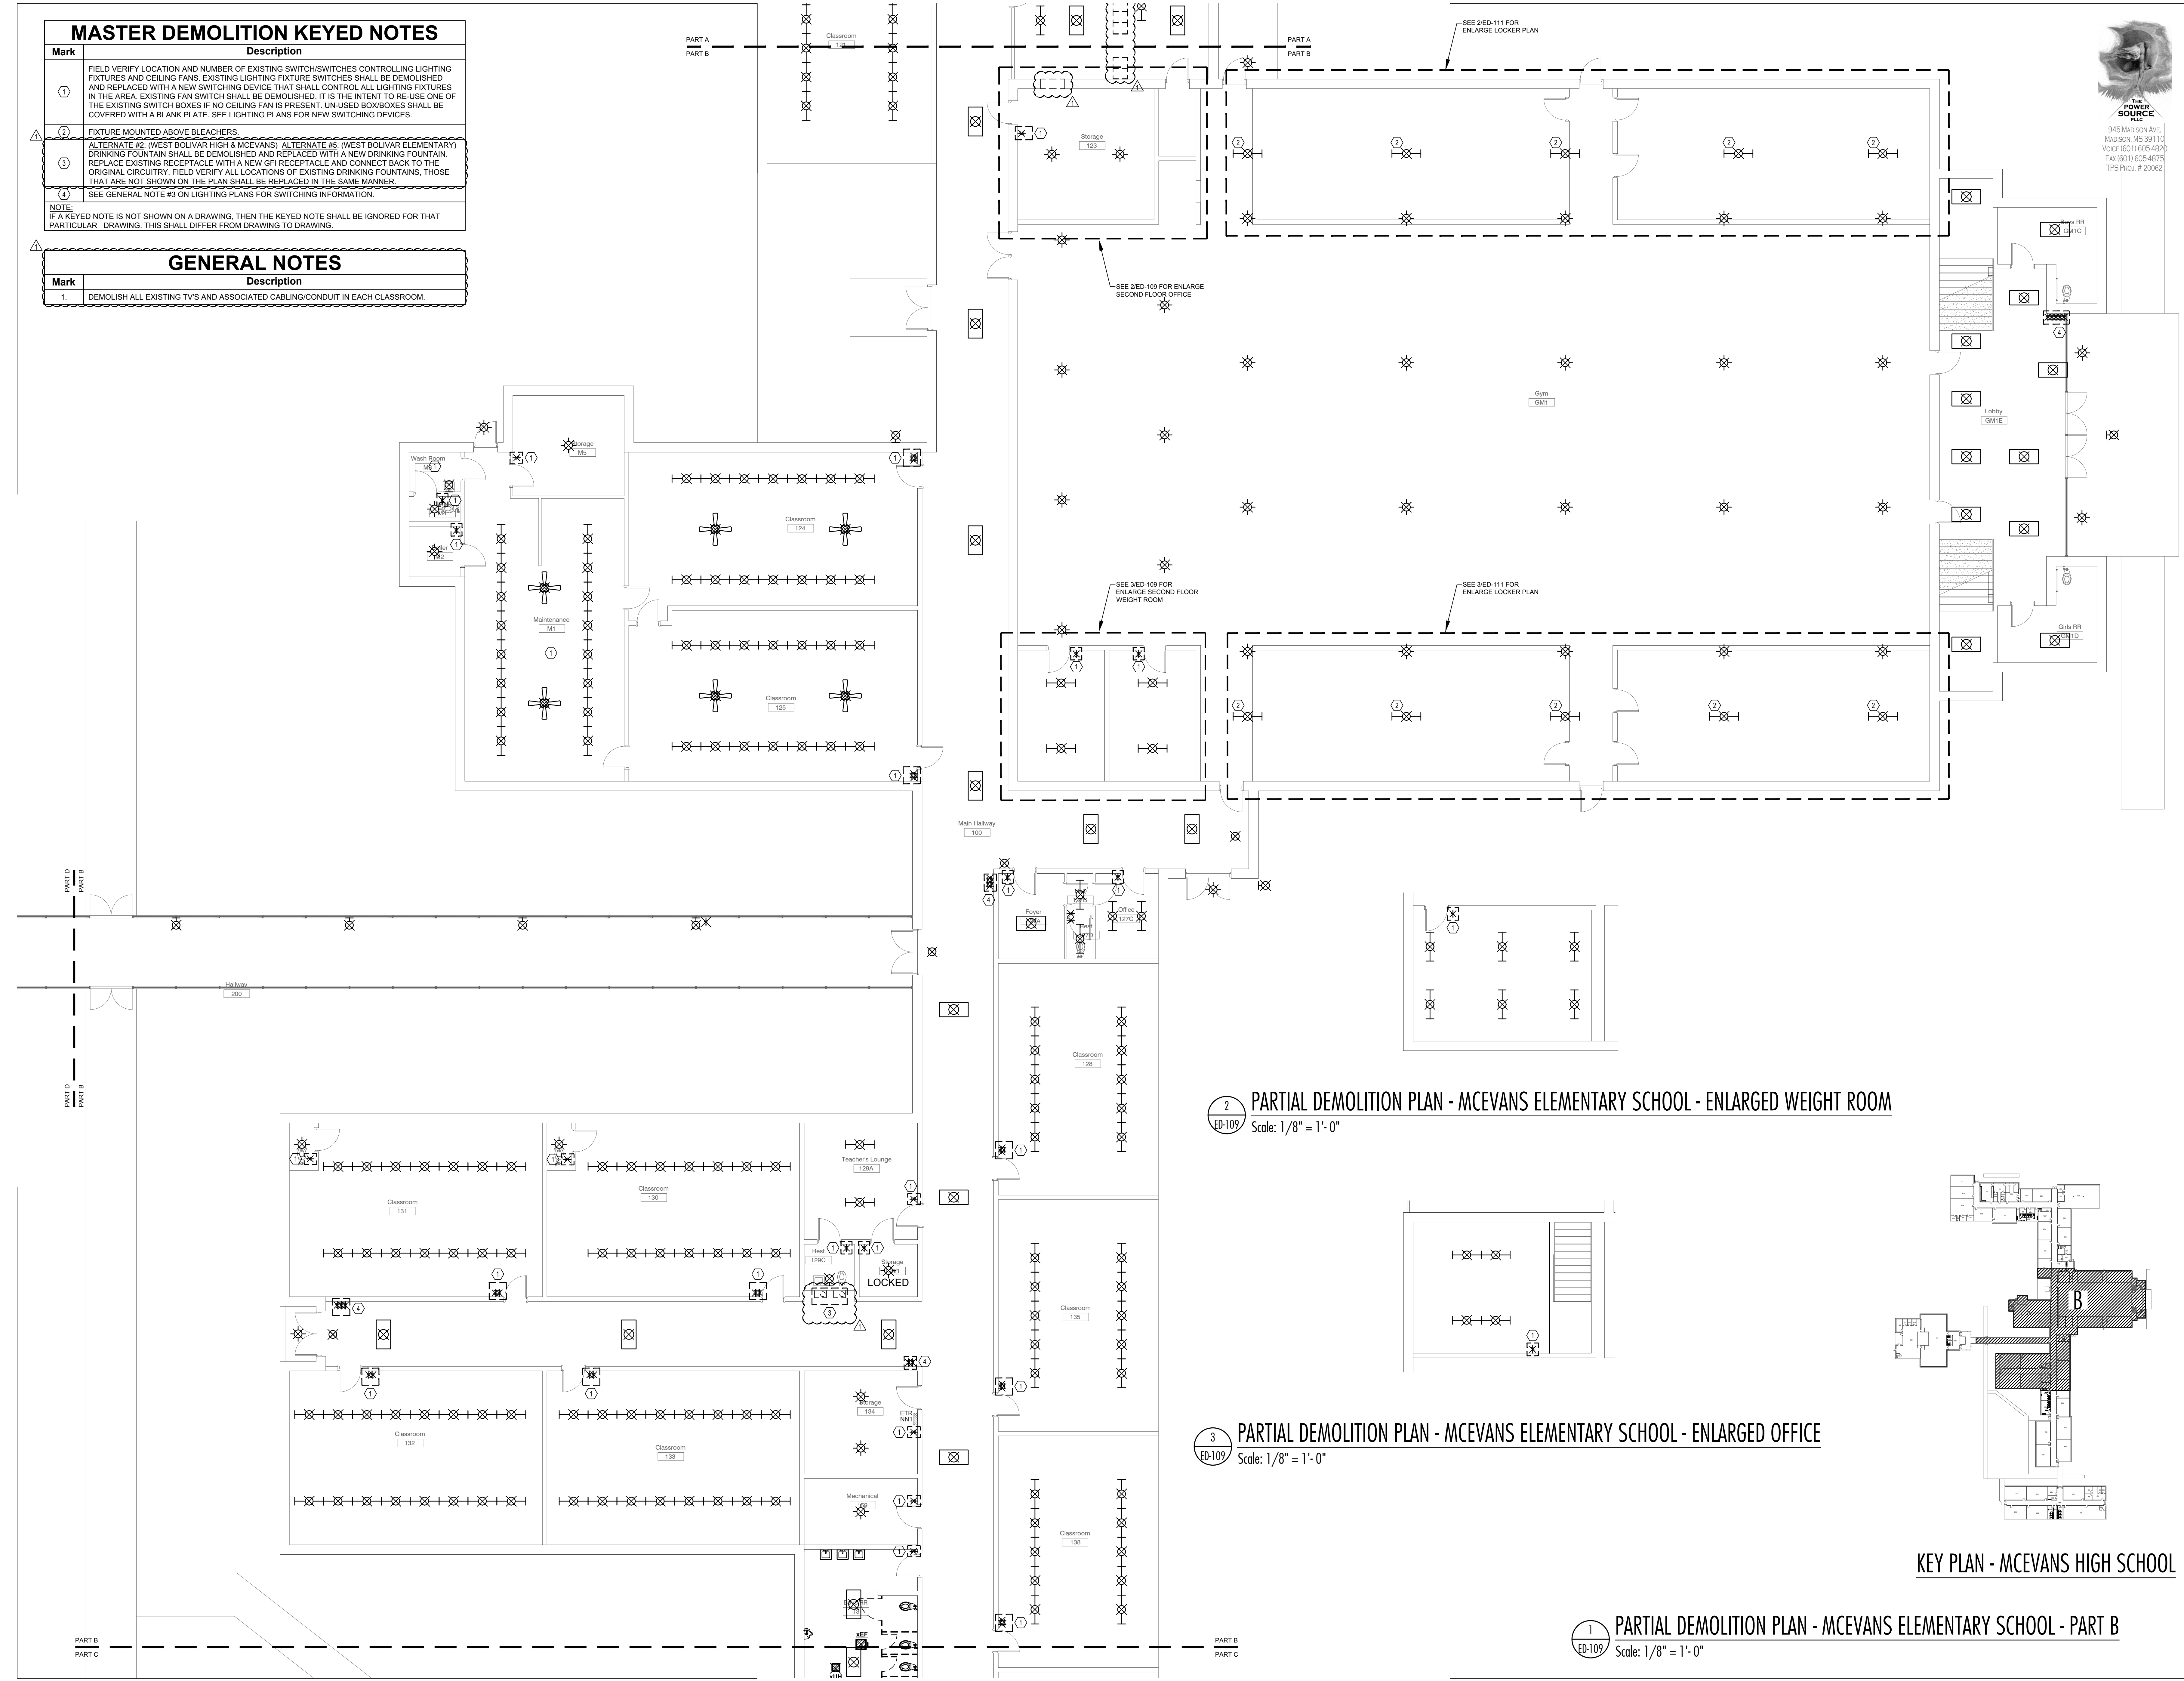


② PARTIAL DEMOLITION PLAN - MCEVANS ELEMENTARY SCHOOL - ENLARGED WEIGHT ROOM
Scale: 1/8" = 1'-0"

③ PARTIAL DEMOLITION PLAN - MCEVANS ELEMENTARY SCHOOL - ENLARGED OFFICE
Scale: 1/8" = 1'-0"

① PARTIAL DEMOLITION PLAN - MCEVANS ELEMENTARY SCHOOL - PART B
Scale: 1/8" = 1'-0"

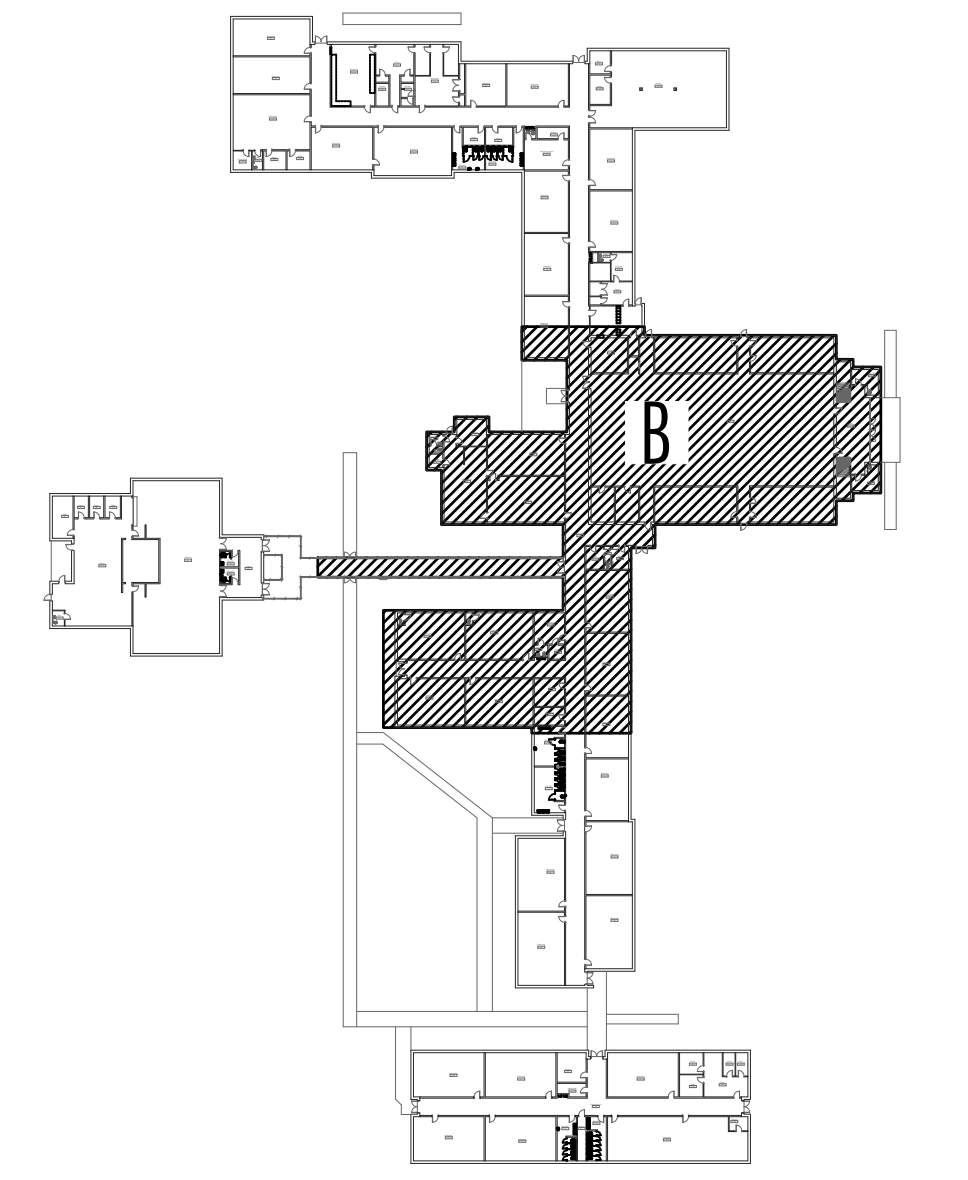


KEY PLAN - MCEVANS HIGH SCHOOL

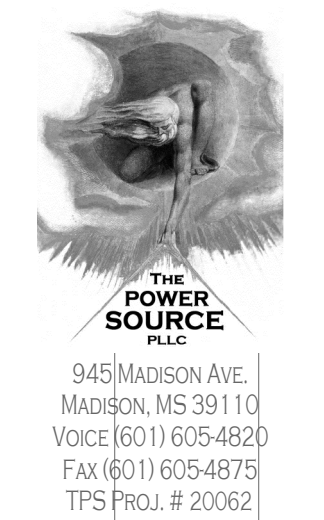

AN ASSOCIATION
Mississippi

DALE BAILEY
JACKSON • BILOXI

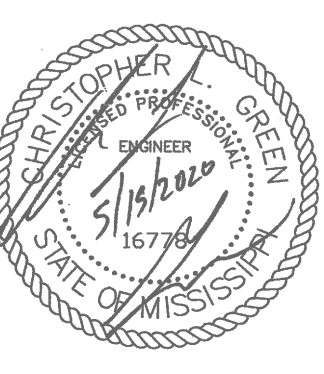

West Bolivar Consolidated School
District Renovation Project

100%
Construction
Documents

Project No	20018
Date	2020-05-15
Drawn	FAB
Checked	CLG
Revisions	Rev Date
ADD#2	2020-06-12

McEvans Elementary School
ED-109
PARTIAL DEMOLITION
PLAN - PART B

PART B
PART C



PART B
PART C

MASTER DEMOLITION KEYED NOTES

Mark	Description
①	FIELD VERIFY LOCATION AND NUMBER OF EXISTING SWITCHES CONTROLLING LIGHTING FIXTURES AND CEILING FANS. EXISTING LIGHTING FIXTURE SWITCHES SHALL BE DEMOLISHED AND REPLACED WITH A NEW SWITCHING DEVICE THAT SHALL CONTROL ALL LIGHTING FIXTURES IN THE AREA. EXISTING FAN SWITCH SHALL BE DEMOLISHED. IT IS THE INTENT TO RE-USE ONE OF THE EXISTING SWITCH BOXES IF NO CEILING FAN IS PRESENT. UN-USED BOX/BOXES SHALL BE COVERED WITH A BLANK PLATE. SEE LIGHTING PLANS FOR NEW SWITCHING DEVICES.
②	FIXTURE MOUNTED ABOVE BLEACHERS.
④	SEE GENERAL NOTE #3 ON LIGHTING PLANS FOR SWITCHING INFORMATION.
NOTE:	IF A KEYED NOTE IS NOT SHOWN ON A DRAWING, THEN THE KEYED NOTE SHALL BE IGNORED FOR THAT PARTICULAR DRAWING. THIS SHALL DIFFER FROM DRAWING TO DRAWING.


GENERAL NOTES

Mark	Description
1.	DEMOLISH ALL EXISTING TV'S AND ASSOCIATED CABLING/CONDUIT IN EACH CLASSROOM.

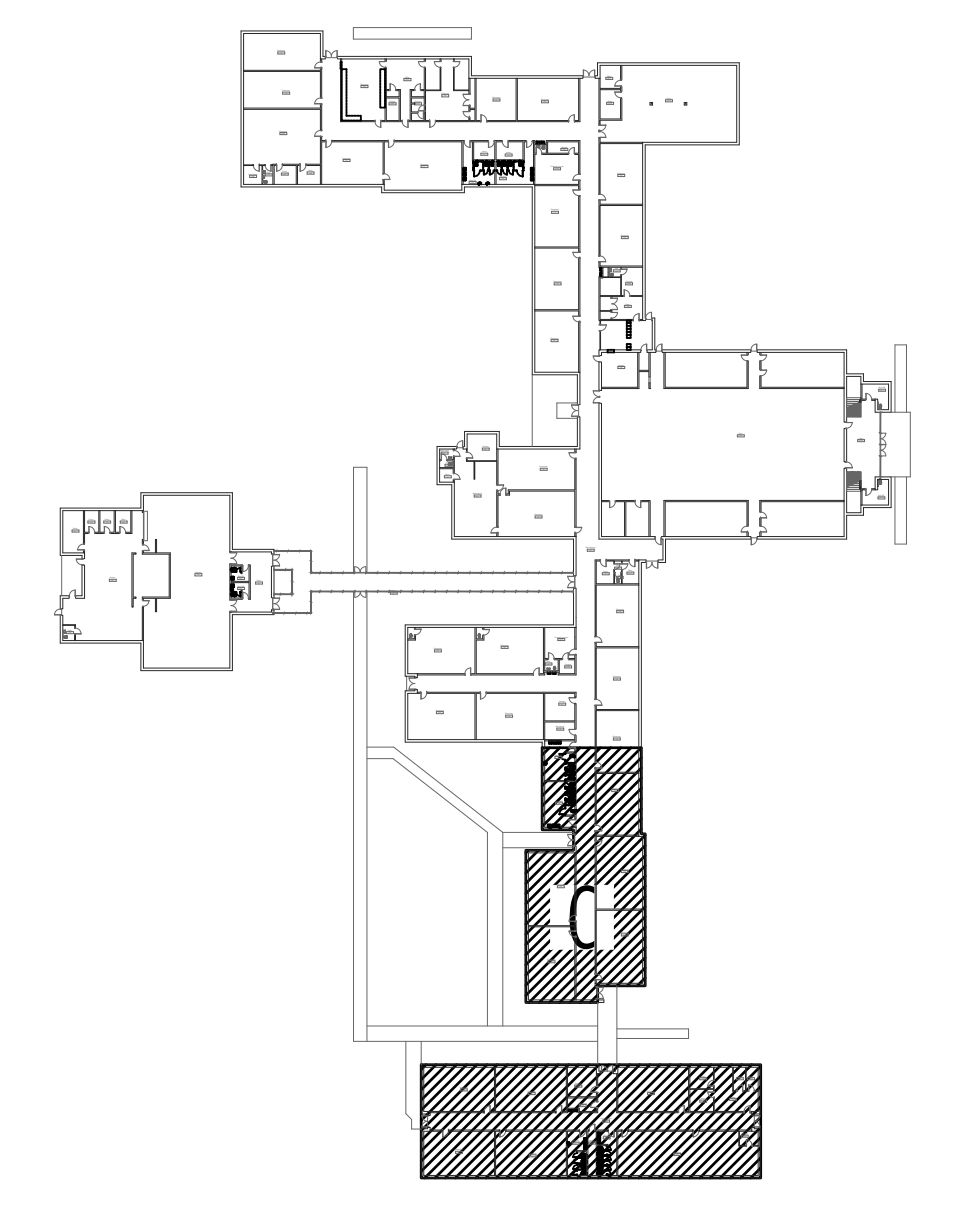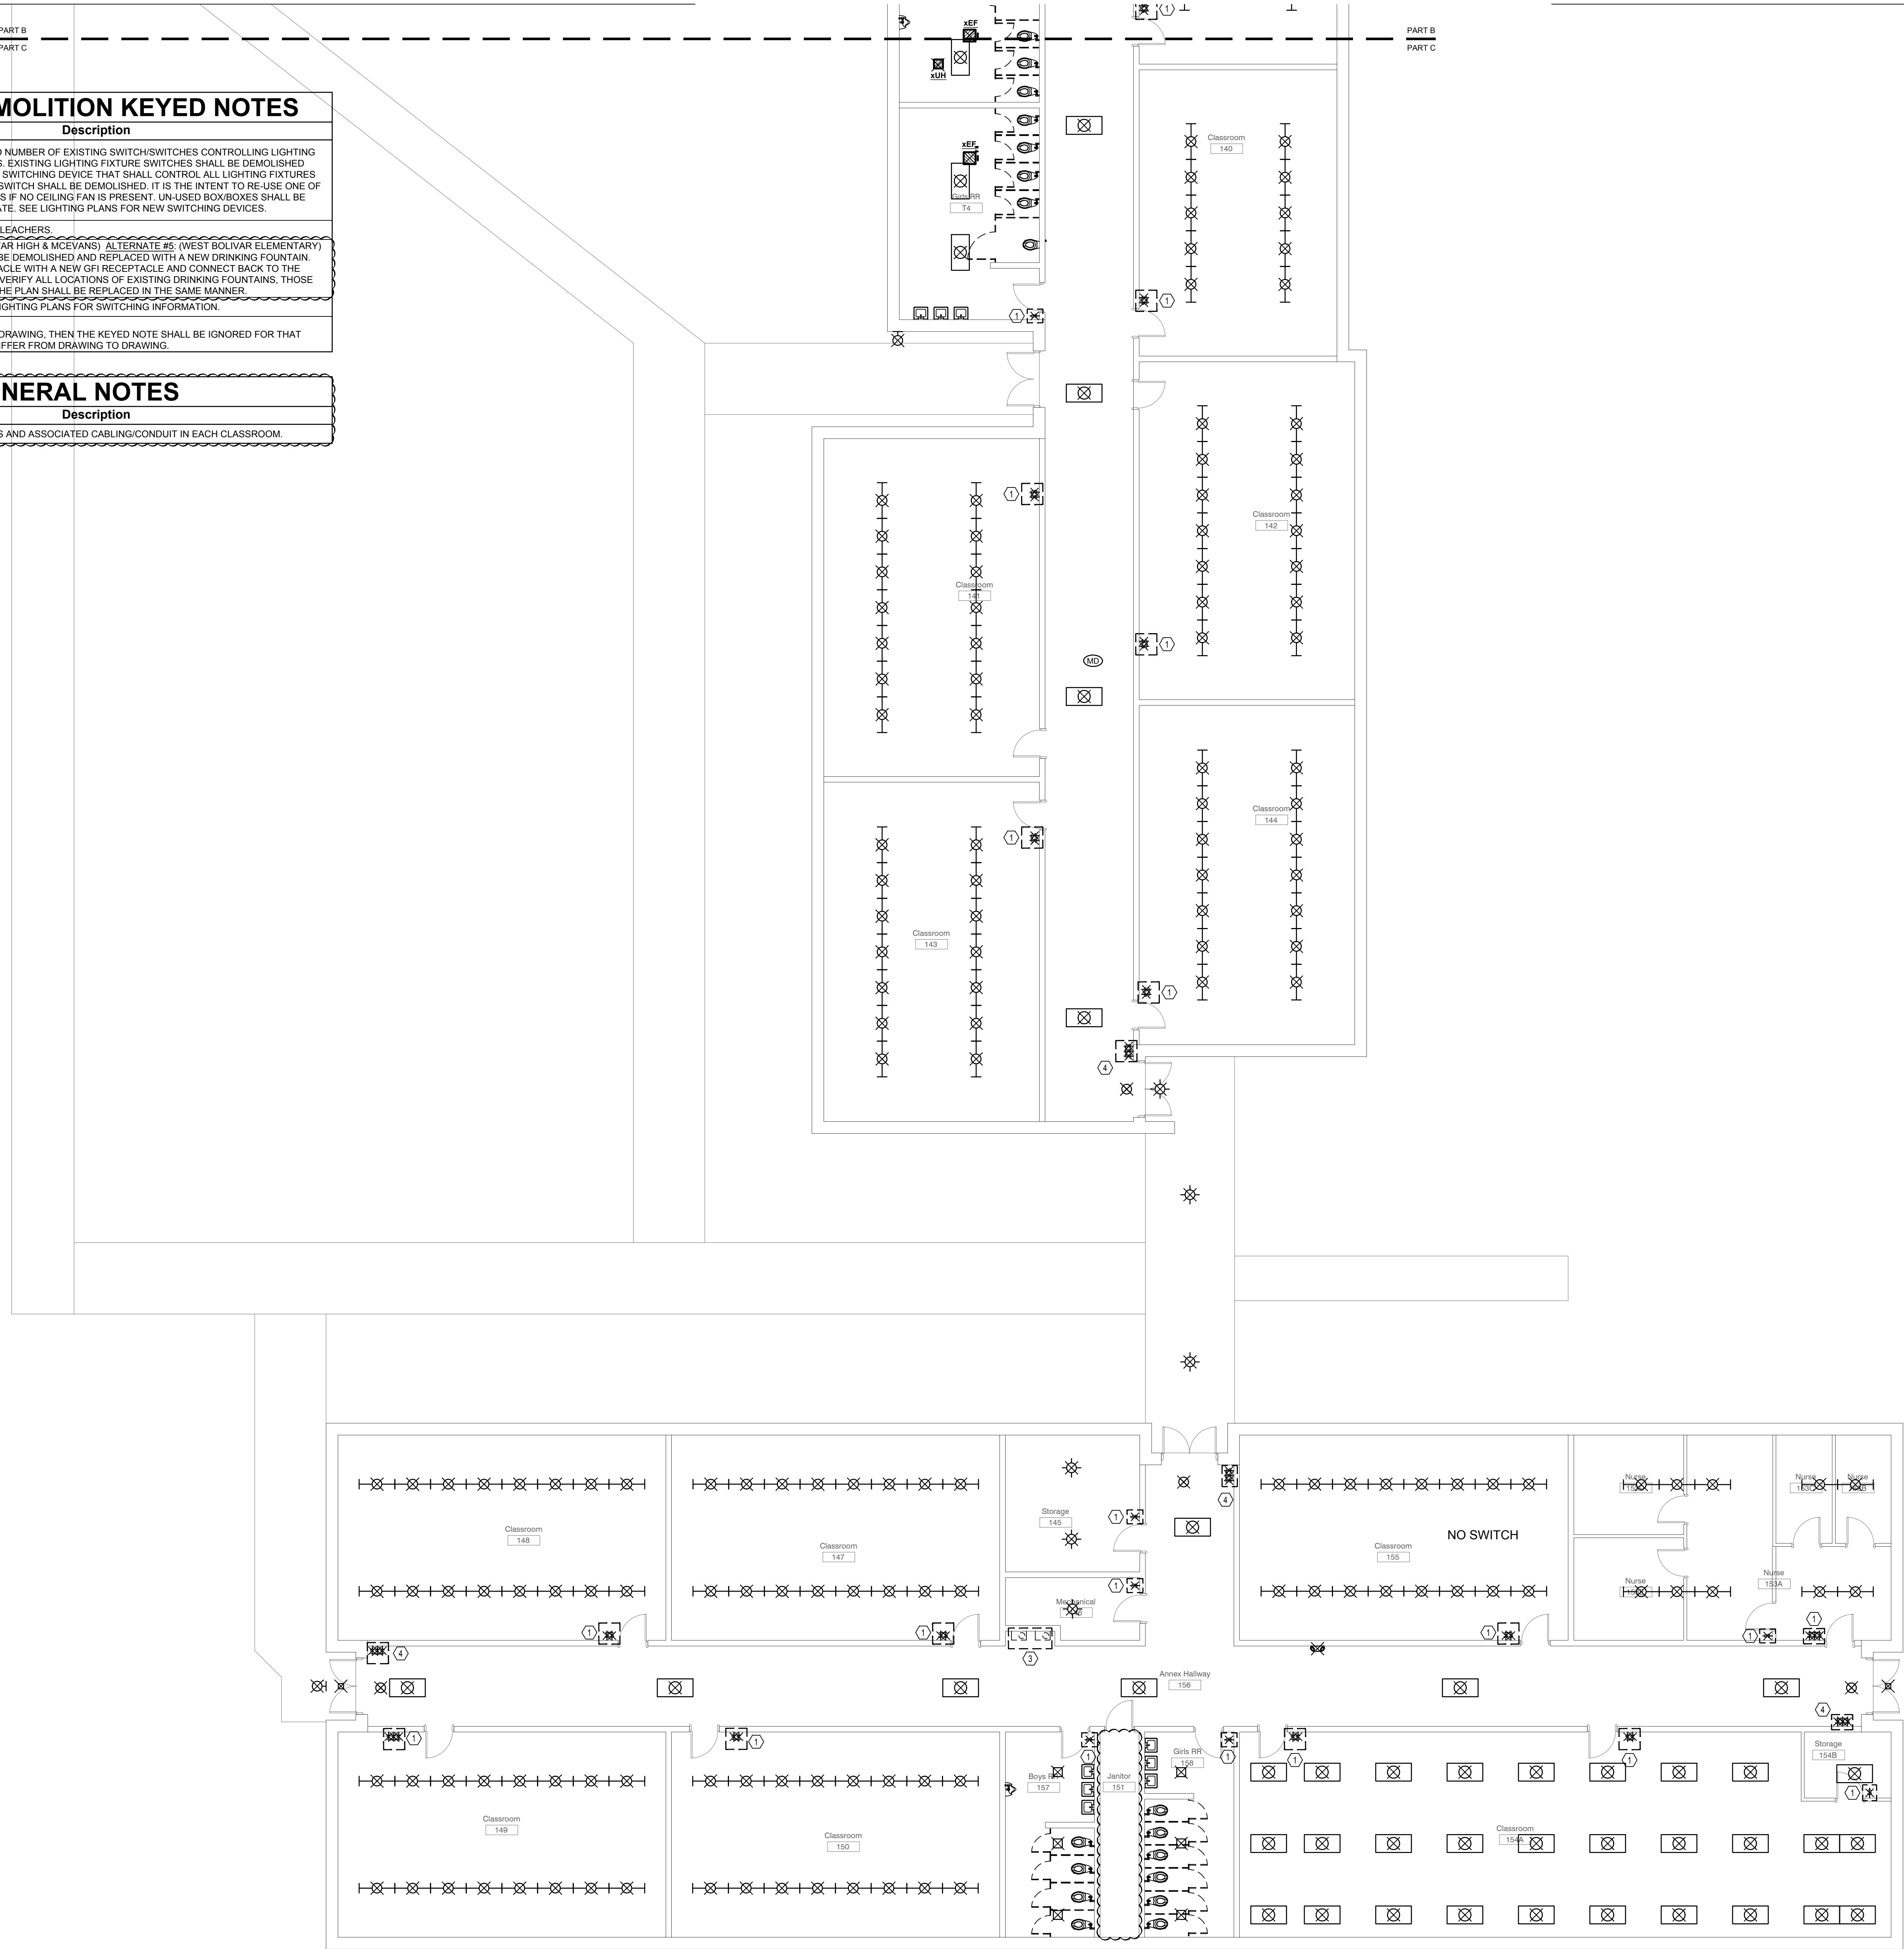


KEY PLAN - MCEVANS HIGH SCHOOL

PARTIAL DEMOLITION PLAN
MCEVANS ELEMENTARY SCHOOL - PART C
 Scale: 1/8" = 1'-0"

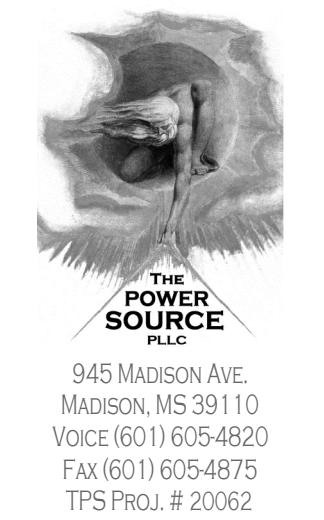

AN ASSOCIATION
DALE BAILEY
 JACKSON • BILOXI
 MISSISSIPPI

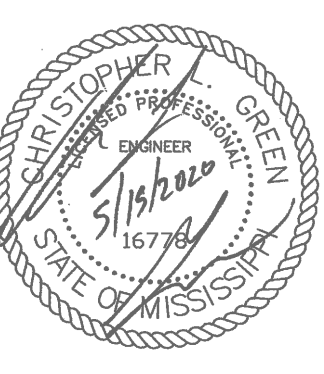

West Bolivar Consolidated School District Renovation Project

100%
 Construction Documents


Project No	20018
Date	2020-05-15
Drawn	FAB
Checked	CLG
Revisions	Rev Date
ADD#2	2020-06-12

McEvans Elementary School
ED-110
 PARTIAL DEMOLITION PLAN - PART C


MASTER DEMOLITION KEYED NOTES	
Mark	Description
①	FIELD VERIFY LOCATION AND NUMBER OF EXISTING SWITCHES/CONTROLLING LIGHTING FIXTURES AND CEILING FANS. EXISTING LIGHTING FIXTURE SWITCHES SHALL BE DEMOLISHED AND REPLACED WITH A NEW SWITCHING DEVICE THAT SHALL CONTROL ALL LIGHTING FIXTURES IN THE AREA. EXISTING FAN SWITCH SHALL BE DEMOLISHED. IT IS THE INTENT TO RE-USE ONE OF THE EXISTING SWITCH BOXES IF NO CEILING FAN IS PRESENT. UNUSED BOX/BOXES SHALL BE COVERED WITH A BLANK PLATE. SEE LIGHTING PLANS FOR NEW SWITCHING DEVICES.
②	FIXTURE MOUNTED ABOVE BLEACHERS.
③	ALTERNATE #2: (WEST BOLIVAR HIGH & MCEVANS) ALTERNATE #3: (WEST BOLIVAR ELEMENTARY) DRINKING FOUNTAIN SHALL BE DEMOLISHED AND REPLACED WITH A NEW DRINKING FOUNTAIN. REPLACE EXISTING RECEPTACLE WITH A NEW OFI RECEPTACLE AND CONNECT BACK TO THE ORIGINAL CIRCUITRY. FIELD VERIFY ALL LOCATIONS OF EXISTING DRINKING FOUNTAINS. THOSE THAT ARE NOT SHOWN ON THE PLAN SHALL BE REPLACED IN THE SAME MANNER.
④	SEE GENERAL NOTE #3 ON LIGHTING PLANS FOR SWITCHING INFORMATION.

NOTE:
IF A KEYED NOTE IS NOT SHOWN ON A DRAWING, THEN THE KEYED NOTE SHALL BE IGNORED FOR THAT PARTICULAR DRAWING. THIS SHALL DIFFER FROM DRAWING TO DRAWING.


GENERAL NOTES	
Mark	Description
1.	DEMOLISH ALL EXISTING TV'S AND ASSOCIATED CABLING/CONDUIT IN EACH CLASSROOM.

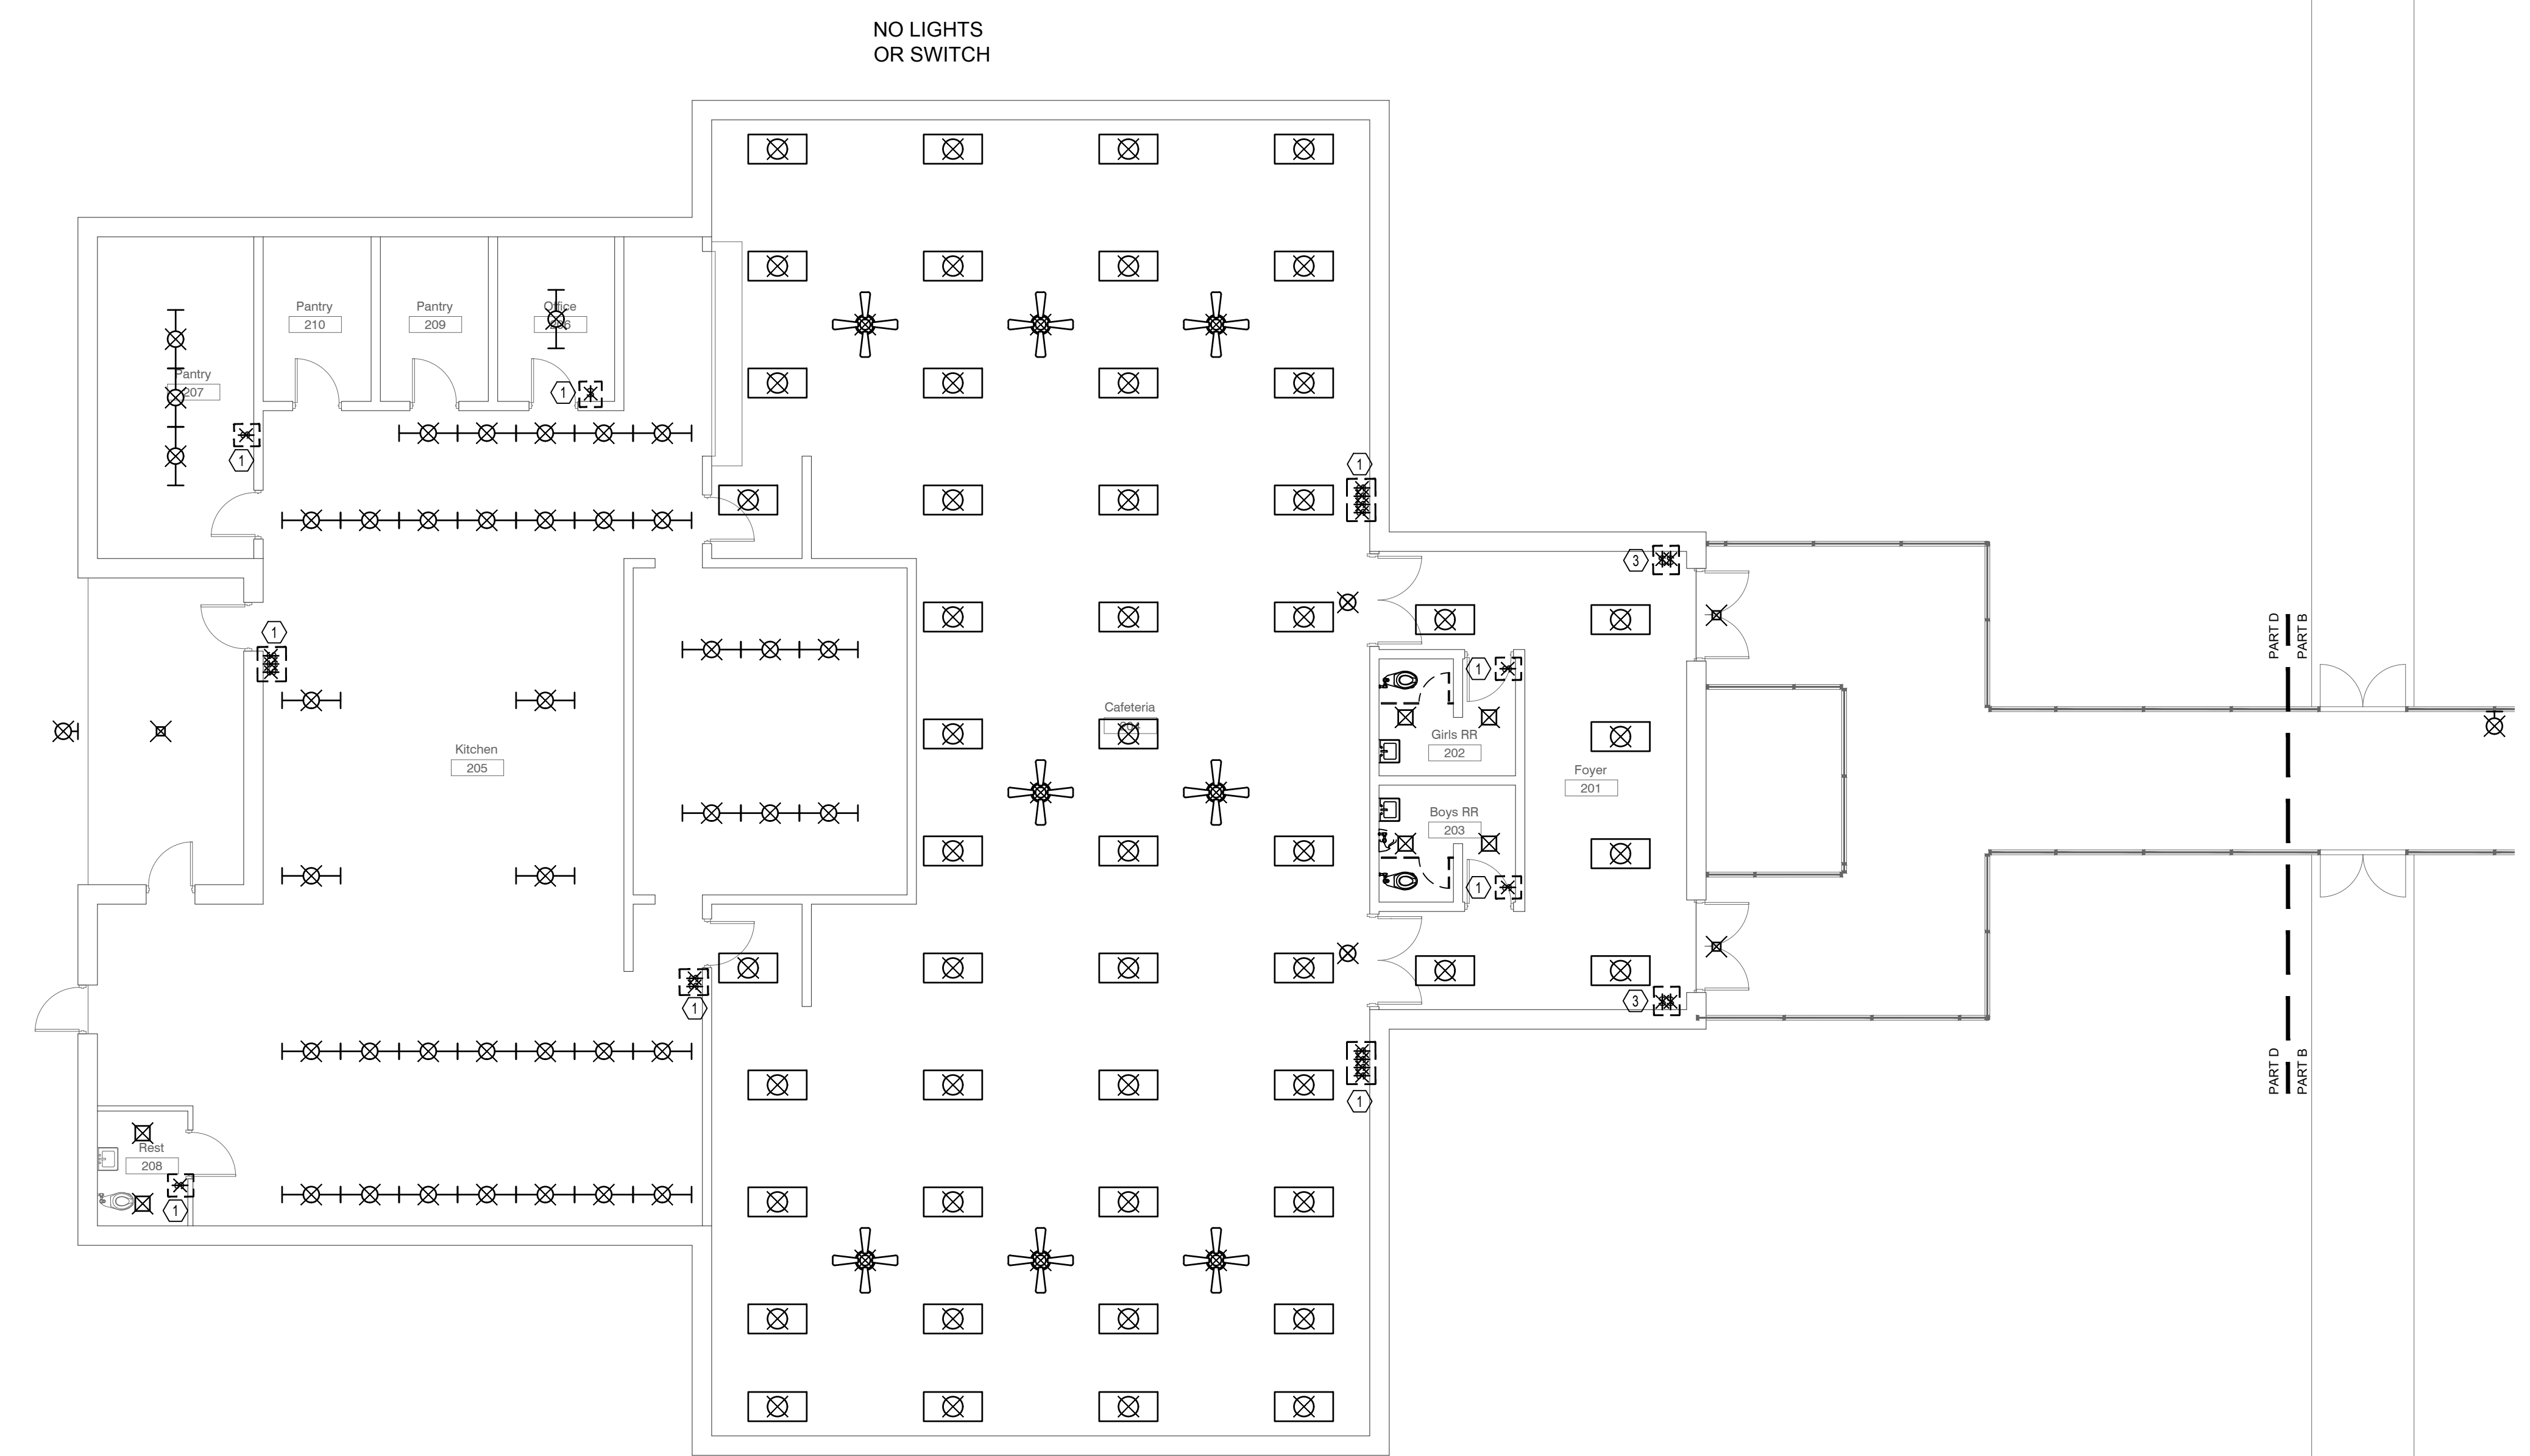


① PARTIAL DEMOLITION PLAN - MCEVANS ELEMENTARY SCHOOL - PART D
ED-111 Scale: 1/8" = 1'-0"

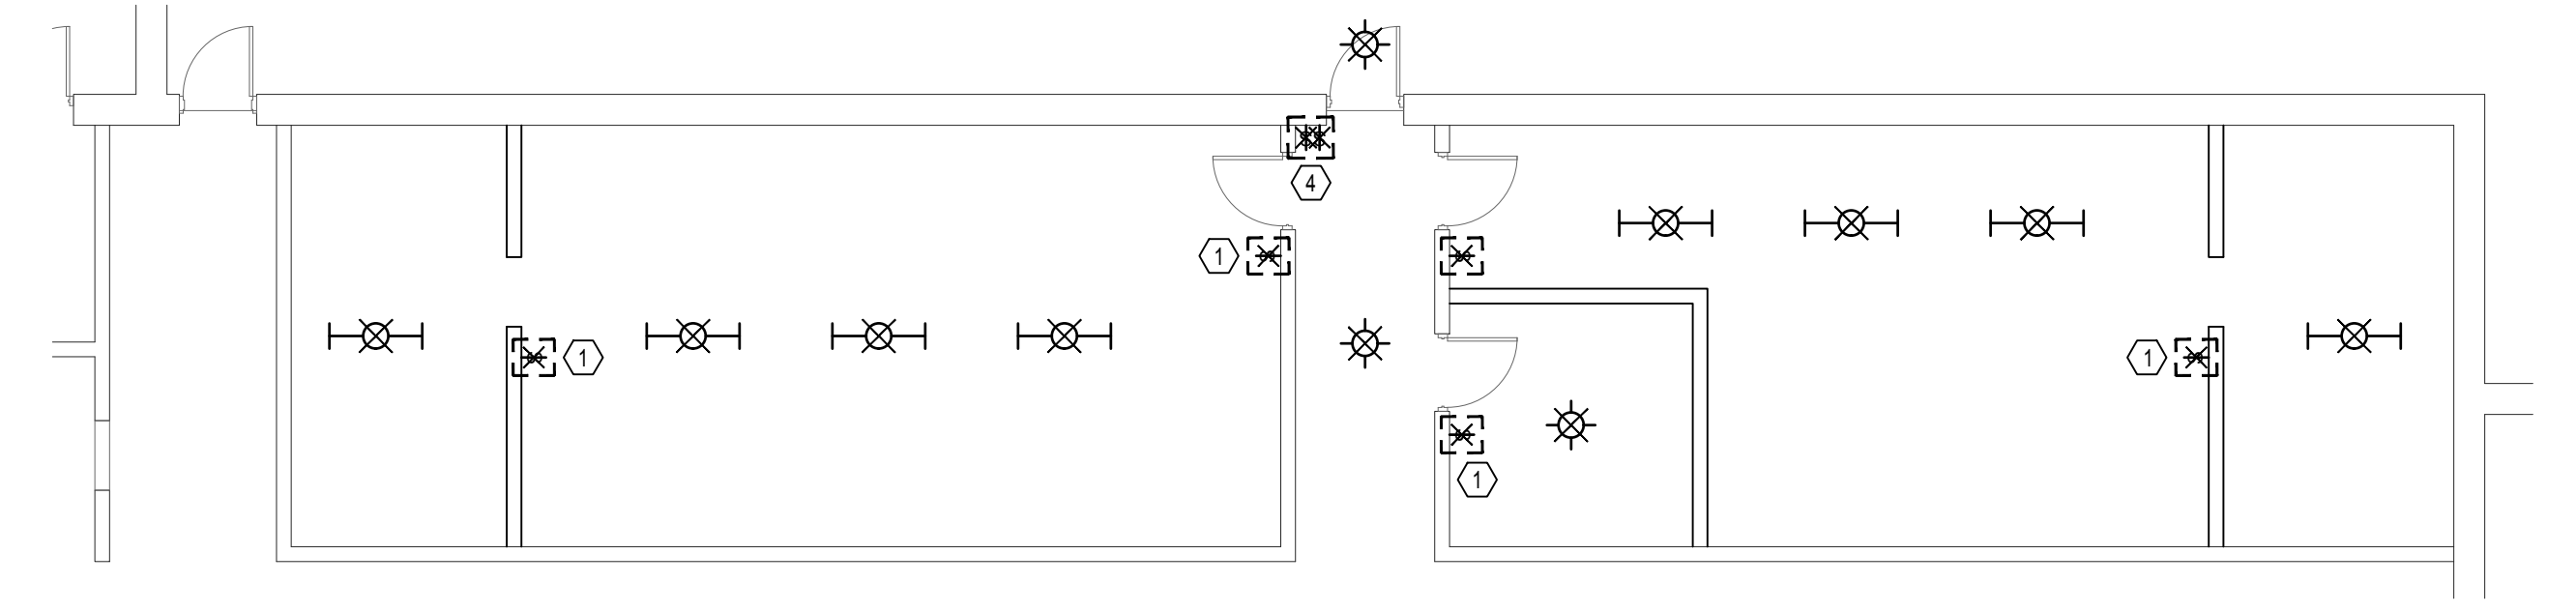


② PARTIAL DEMOLITION PLAN - MCEVANS ELEMENTARY SCHOOL - ENLARGED LOCKER ROOMS
ED-111 Scale: 1/8" = 1'-0"

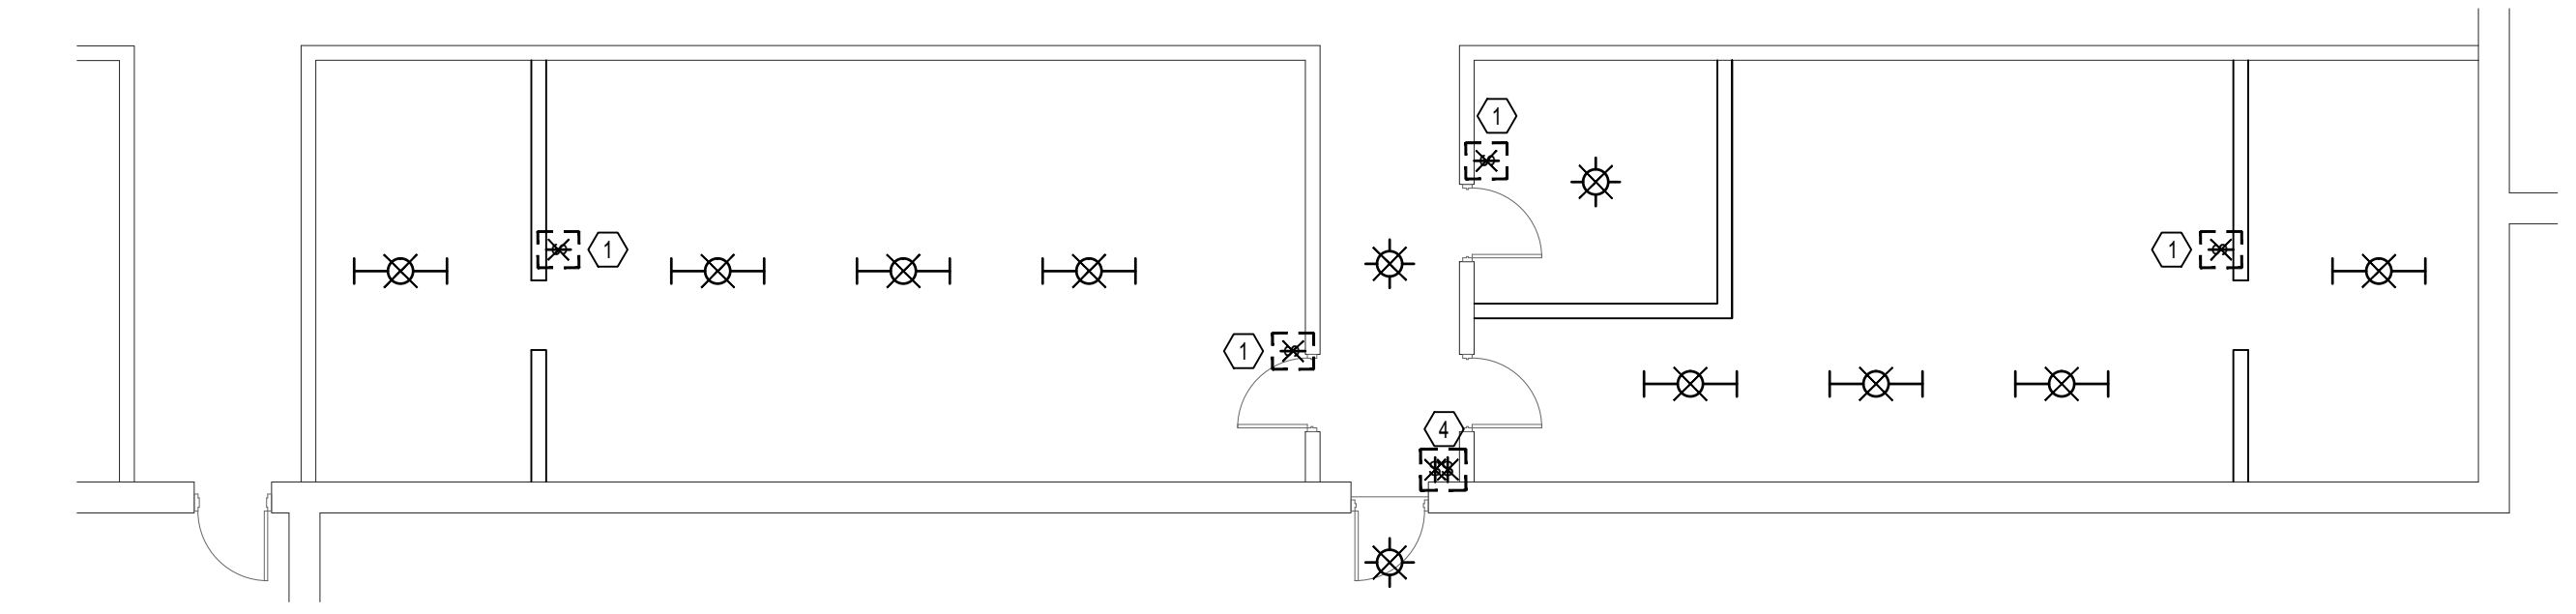

③ PARTIAL DEMOLITION PLAN - MCEVANS ELEMENTARY SCHOOL - ENLARGED LOCKER ROOMS
ED-111 Scale: 1/8" = 1'-0"

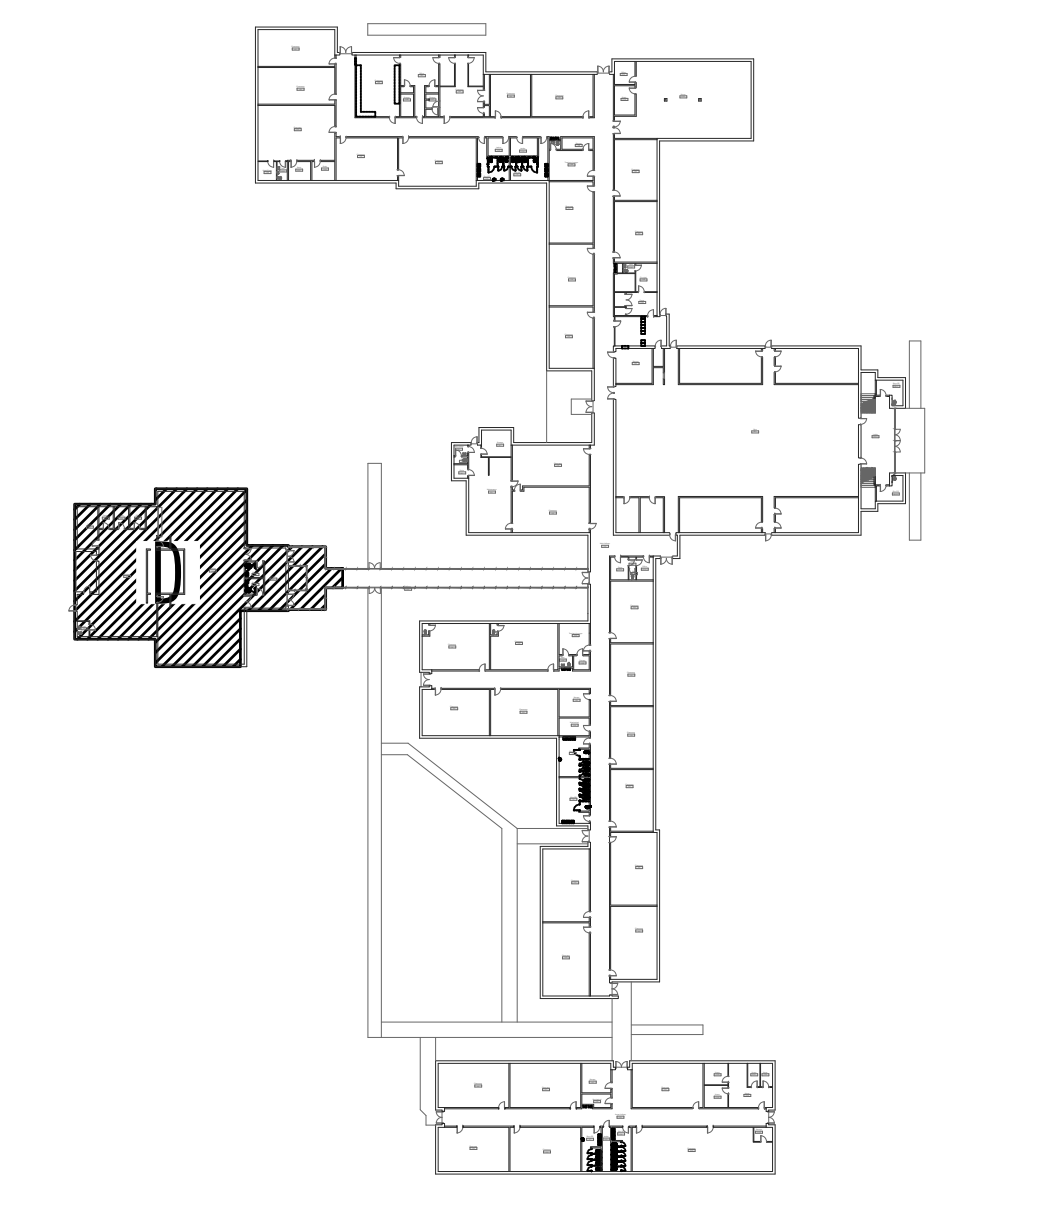


KEY PLAN - MCEVANS HIGH SCHOOL

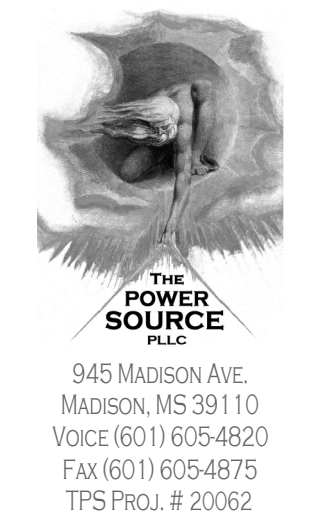

945 MADISON AVE.
MADISON, MS 39110
VOICE (601) 605-4820
FAX (601) 605-4875
TPS PROJ. # 20062

AN ASSOCIATION
DALE BAILEY
JACKSON • BILOXI

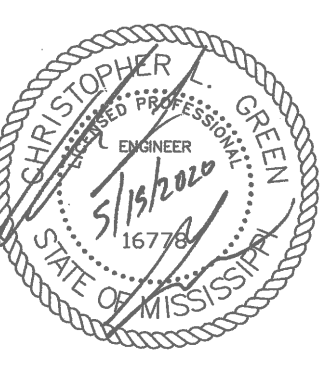

West Bolivar Consolidated School
District Renovation Project

100%
Construction
Documents

Project No	20018
Date	2020-05-15
Drawn	FAB
Checked	CLG
Revisions	Rev Date
ADD#2	2020-06-12

McEvans Elementary School
ED-111
PARTIAL DEMOLITION
PLAN - PART D


GENERAL NOTES

Mark	Description
1.	CONNECT NEW LIGHT FIXTURES TO EXISTING LIGHT FIXTURE CIRCUITRY IN EACH ROOM UNLESS NOTED OTHERWISE ON DRAWINGS. PROVIDE UNSWITCHED POWER TO ALL EMERGENCY BATTERY PACKS.
2.	CONTRACTOR SHALL PROVIDE DIMMING CABLES FOR ALL LIGHT FIXTURES IN ROOMS THAT REQUIRE DIMMING.
3.	ALL CORRIDOR LIGHT FIXTURES SHALL BE CONTROLLED WITH OCCUPANCY SENSORS (AUTOMATIC ON / OFF). CONTRACTOR SHALL DEMOLISH EXISTING SINGLE POLE SWITCH SERVING EACH CORRIDOR. EXISTING SINGLE POLE SWITCH SERVING EXTERIOR LIGHTS SHALL BE EXISTING TO REMAIN. PROVIDE A STAINLESS STEEL TWO GANG COVER PLATE WITH A BLANK FOR THE DEMOLISHED SWITCH.
4.	REPLACE ALL EXISTING EXIT SIGNS WITH NEW FIXTURE "X". SEE LIGHTING FIXTURE SCHEDULE ON SHEET E-100.


MASTER KEYED NOTES - LIGHTING

Mark	Description
①	CONNECT TO EXISTING CIRCUITRY IN THIS AREA.
②	FIXTURES MOUNTED ABOVE BLEACHERS.
③	CONNECT TO EXISTING EXTERIOR LIGHTING CIRCUIT AND SWITCHING.
④	EXISTING COMPUTER LAB. PROVIDE TWO 20A BREAKERS IN PANEL NN1. RE-CIRCUIT EXISTING SURFACE MOUNTED RECEPTACLES WITH THESE TWO NEW 20A CIRCUITS.
⑤	EXISTING PROJECTOR IS SWITCHED WITH THE LIGHTS. PROVIDE UNSWITCHED POWER TO THE PROJECTOR.
⑥	PROVIDE A 20A BREAKER IN PANEL NN1.
⑦	PROVIDE A 20A BREAKER IN PANEL NN2.
⑧	PROVIDE A 20A BREAKER IN EXISTING PANEL IN THIS BUILDING.

NOTE:
IF A KEYED NOTE IS NOT SHOWN ON A DRAWING, THEN THE KEYED NOTE SHALL BE IGNORED FOR THAT PARTICULAR DRAWING. THIS SHALL DIFFER FROM DRAWING TO DRAWING.

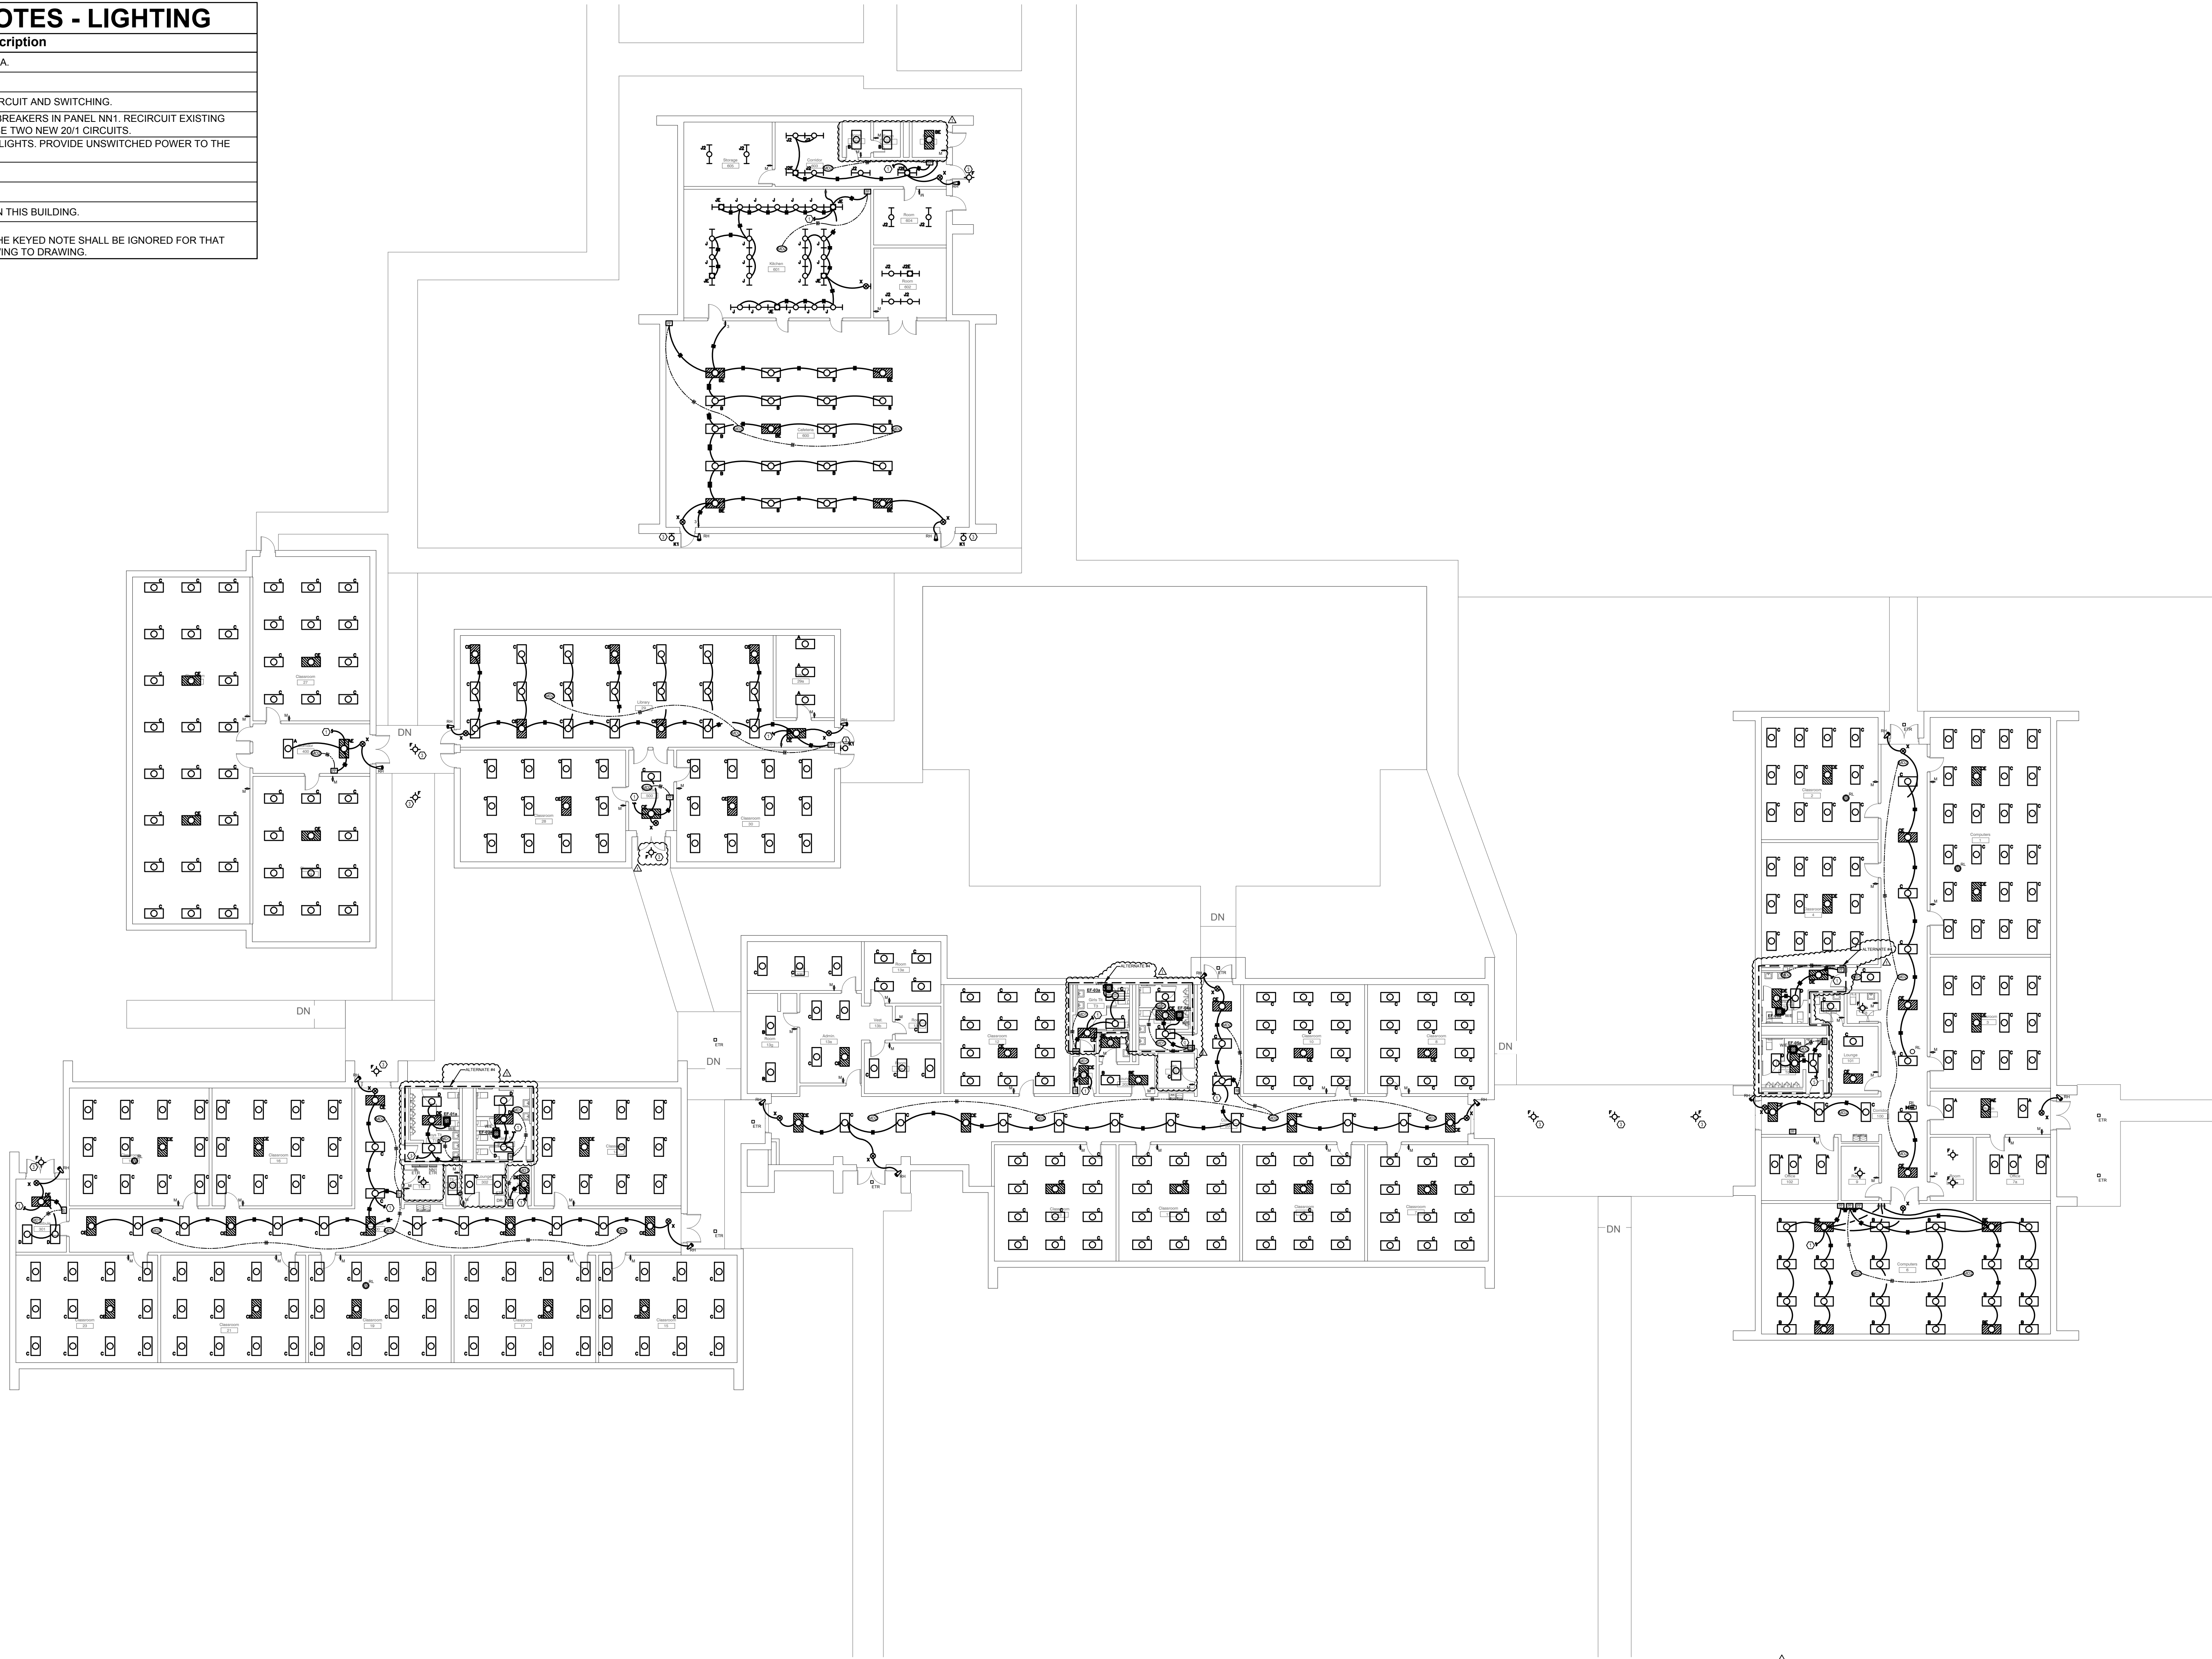


① OVERALL LIGHTING PLAN - WEST BOLIVAR ELEMENTARY SCHOOL - ALTERNATE #5
E-100 Scale: 1/16" = 1'-0"

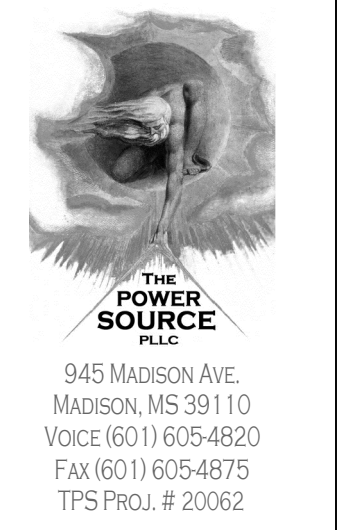

945 MADISON AVE.
MADISON, MS 39110
VOICE (601) 605-4820
FAX (601) 605-4875
TPS PROJ. # 20062

AN ASSOCIATION
DALE BAILEY
JACKSON • BILOXI

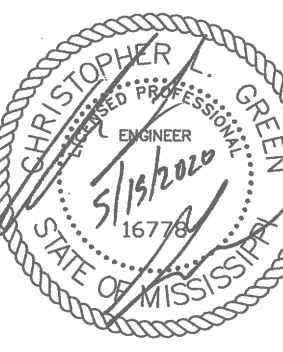

**West Bolivar Consolidated School
District Renovation Project**

100%
Construction
Documents

Project No	20018
Date	2020-05-15
Drawn	FAB
Checked	CLG
Revisions	Rev Date
▲ ADD#2	2020-06-12

West Bolivar Elementary
E-100
OVERALL
LIGHTING PLAN


GENERAL NOTES

Mark	Description
1.	CONNECT NEW LIGHT FIXTURES TO EXISTING LIGHT FIXTURE CIRCUITRY IN EACH ROOM UNLESS NOTED OTHERWISE ON DRAWINGS. PROVIDE UNSWITCHED POWER TO ALL EMERGENCY BATTERY PACKS.
2.	CONTRACTOR SHALL PROVIDE DIMMING CABLES FOR ALL LIGHT FIXTURES IN ROOMS THAT REQUIRE DIMMING.
3.	ALL CORRIDOR LIGHT FIXTURES SHALL BE CONTROLLED WITH OCCUPANCY SENSORS (AUTOMATIC ON / OFF). CONTRACTOR SHALL DEMOLISH EXISTING SINGLE POLE SWITCH SERVING EACH CORRIDOR. EXISTING SINGLE POLE SWITCH SERVING EXTERIOR LIGHTS SHALL BE EXISTING TO REMAIN. PROVIDE A STAINLESS STEEL TWO GANG COVER PLATE WITH A BLANK FOR THE DEMOLISHED SWITCH.
4.	REPLACE ALL EXISTING EXIT SIGNS WITH NEW FIXTURE "X". SEE LIGHTING FIXTURE SCHEDULE ON SHEET E-300.


MASTER KEYED NOTES - LIGHTING

Mark	Description
①	CONNECT TO EXISTING CIRCUITRY IN THIS AREA.
②	FIXTURES MOUNTED ABOVE BLEACHERS.
③	CONNECT TO EXISTING EXTERIOR LIGHTING CIRCUIT AND SWITCHING.
④	EXISTING COMPUTER LAB. PROVIDE TWO 20A BREAKERS IN PANEL NN1. RE-CIRCUIT EXISTING SURFACE MOUNTED RECEPTACLES WITH THESE TWO NEW 20A CIRCUITS.
⑤	EXISTING PROJECTOR IS SWITCHED WITH THE LIGHTS. PROVIDE UNSWITCHED POWER TO THE PROJECTOR.
⑥	PROVIDE A 20A BREAKER IN PANEL NN1.
⑦	PROVIDE A 20A BREAKER IN PANEL NN2.
⑧	PROVIDE A 20A BREAKER IN EXISTING PANEL IN THIS BUILDING.


NOTE:
IF A KEYED NOTE IS NOT SHOWN ON A DRAWING, THEN THE KEYED NOTE SHALL BE IGNORED FOR THAT PARTICULAR DRAWING. THIS SHALL DIFFER FROM DRAWING TO DRAWING.

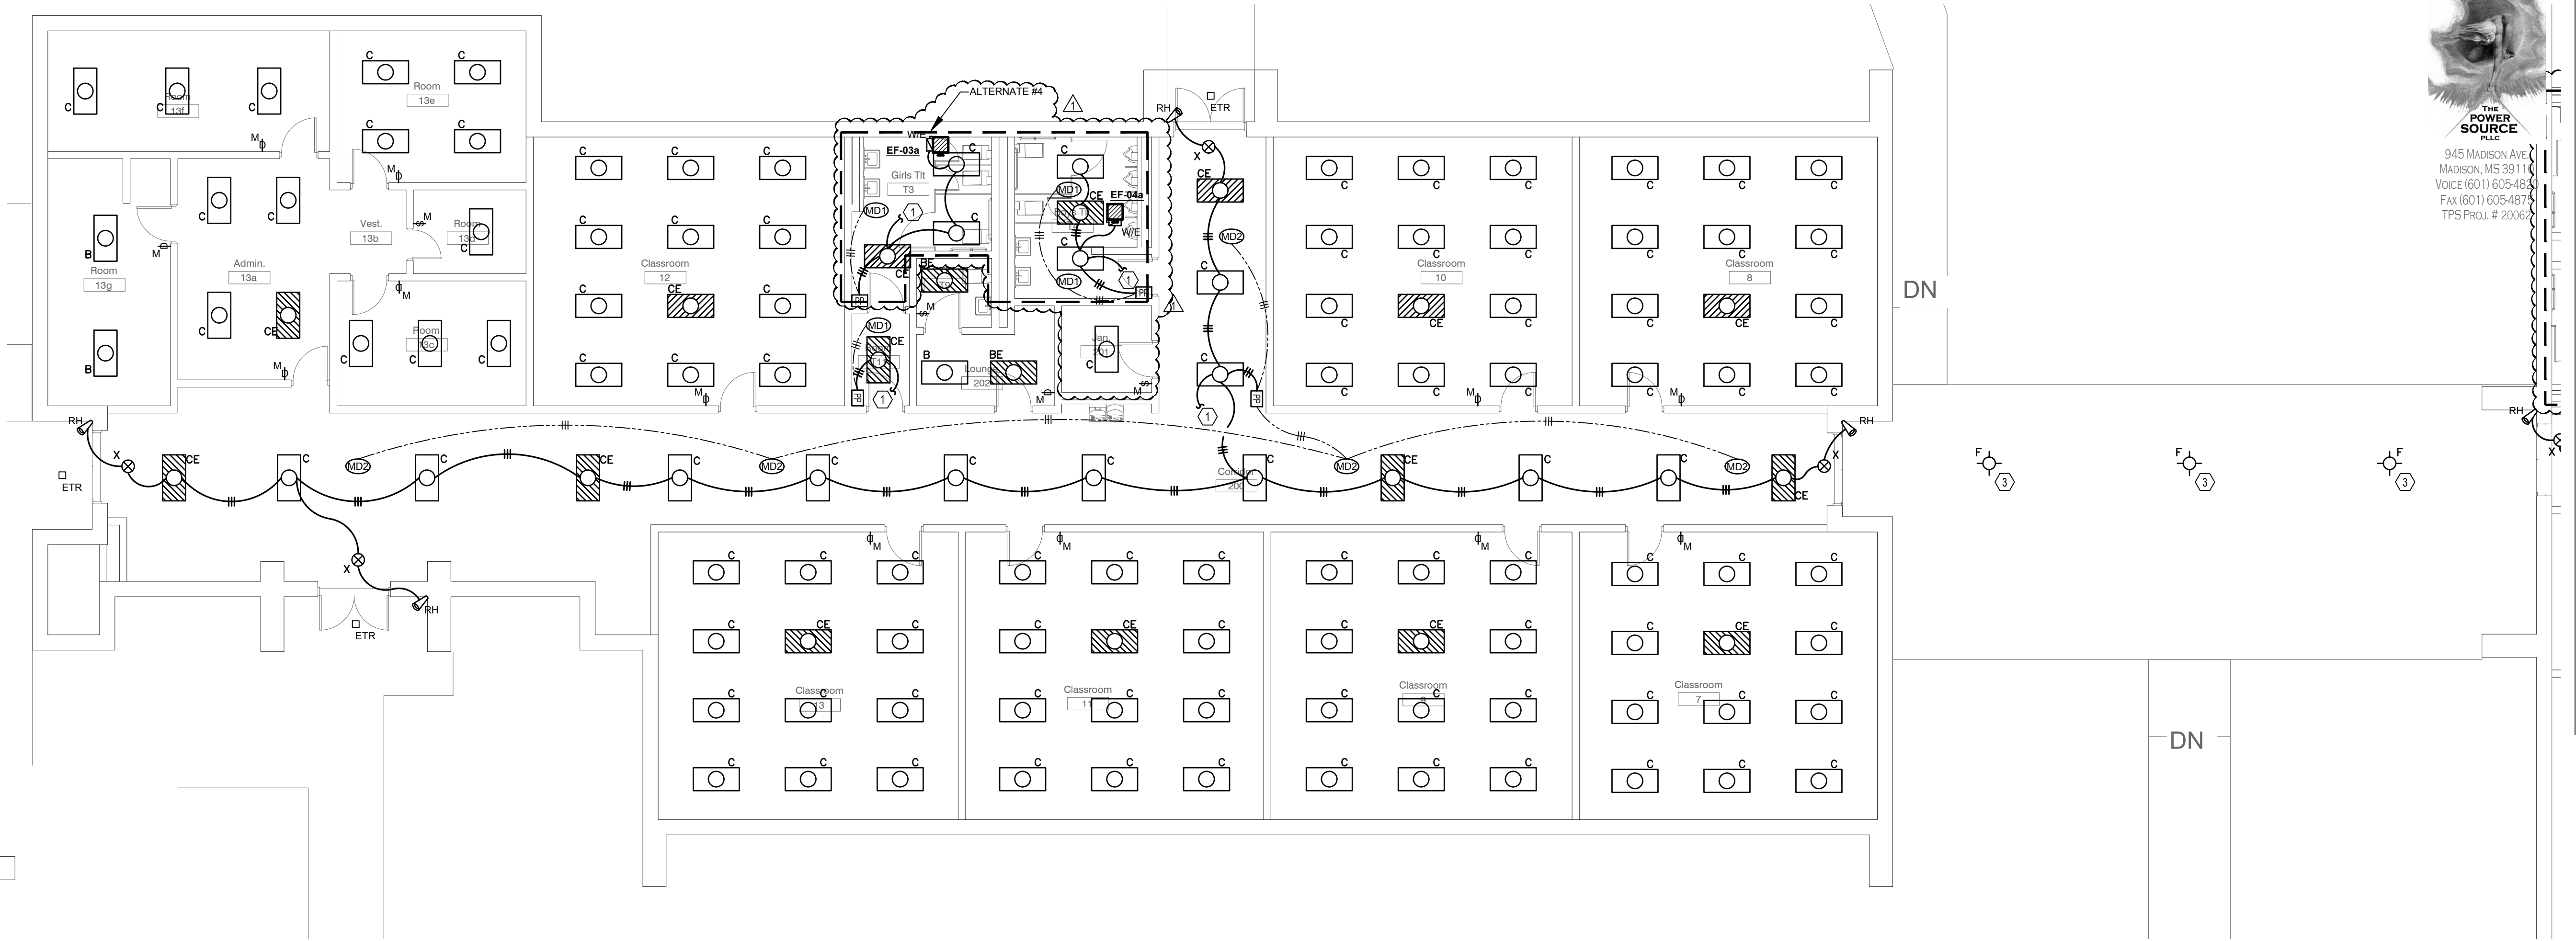


E-101 Scale: 1/8" = 1'-0"

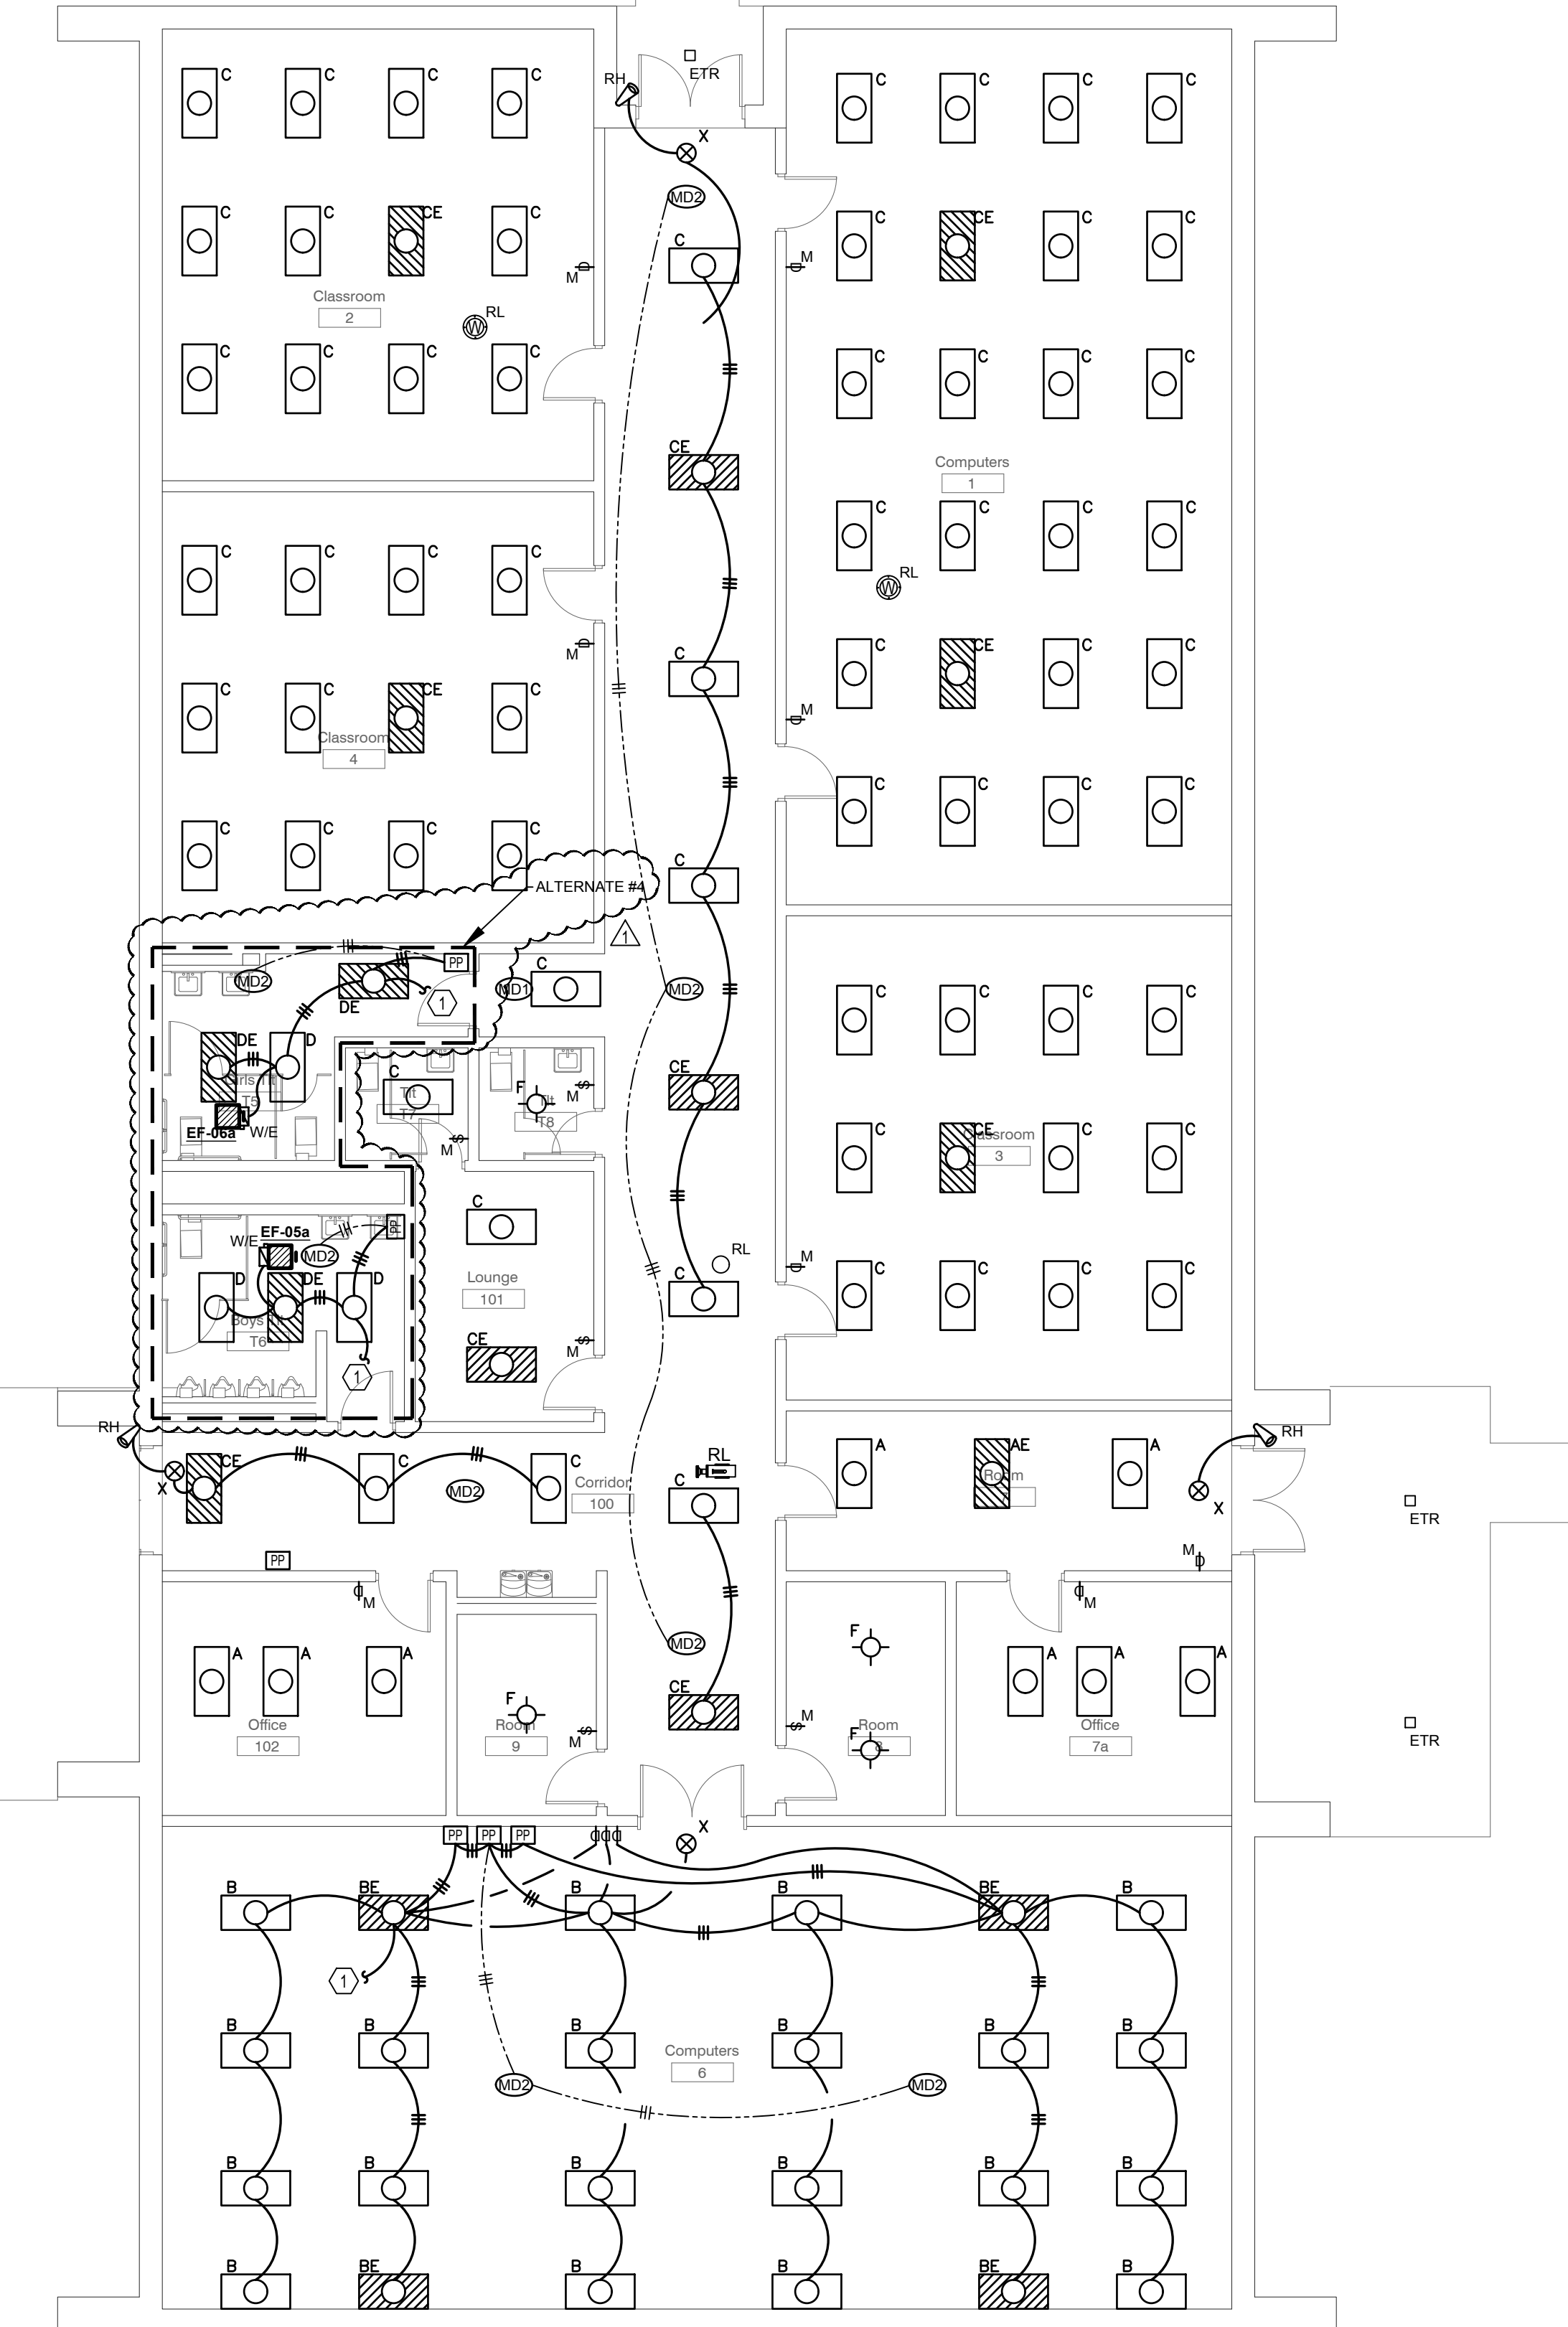


1 PARTIAL LIGHTING PLAN - WEST BOLIVAR ELEMENTARY SCHOOL - PART A - ALTERNATE #5
E-101 Scale: 1/8" = 1'-0"

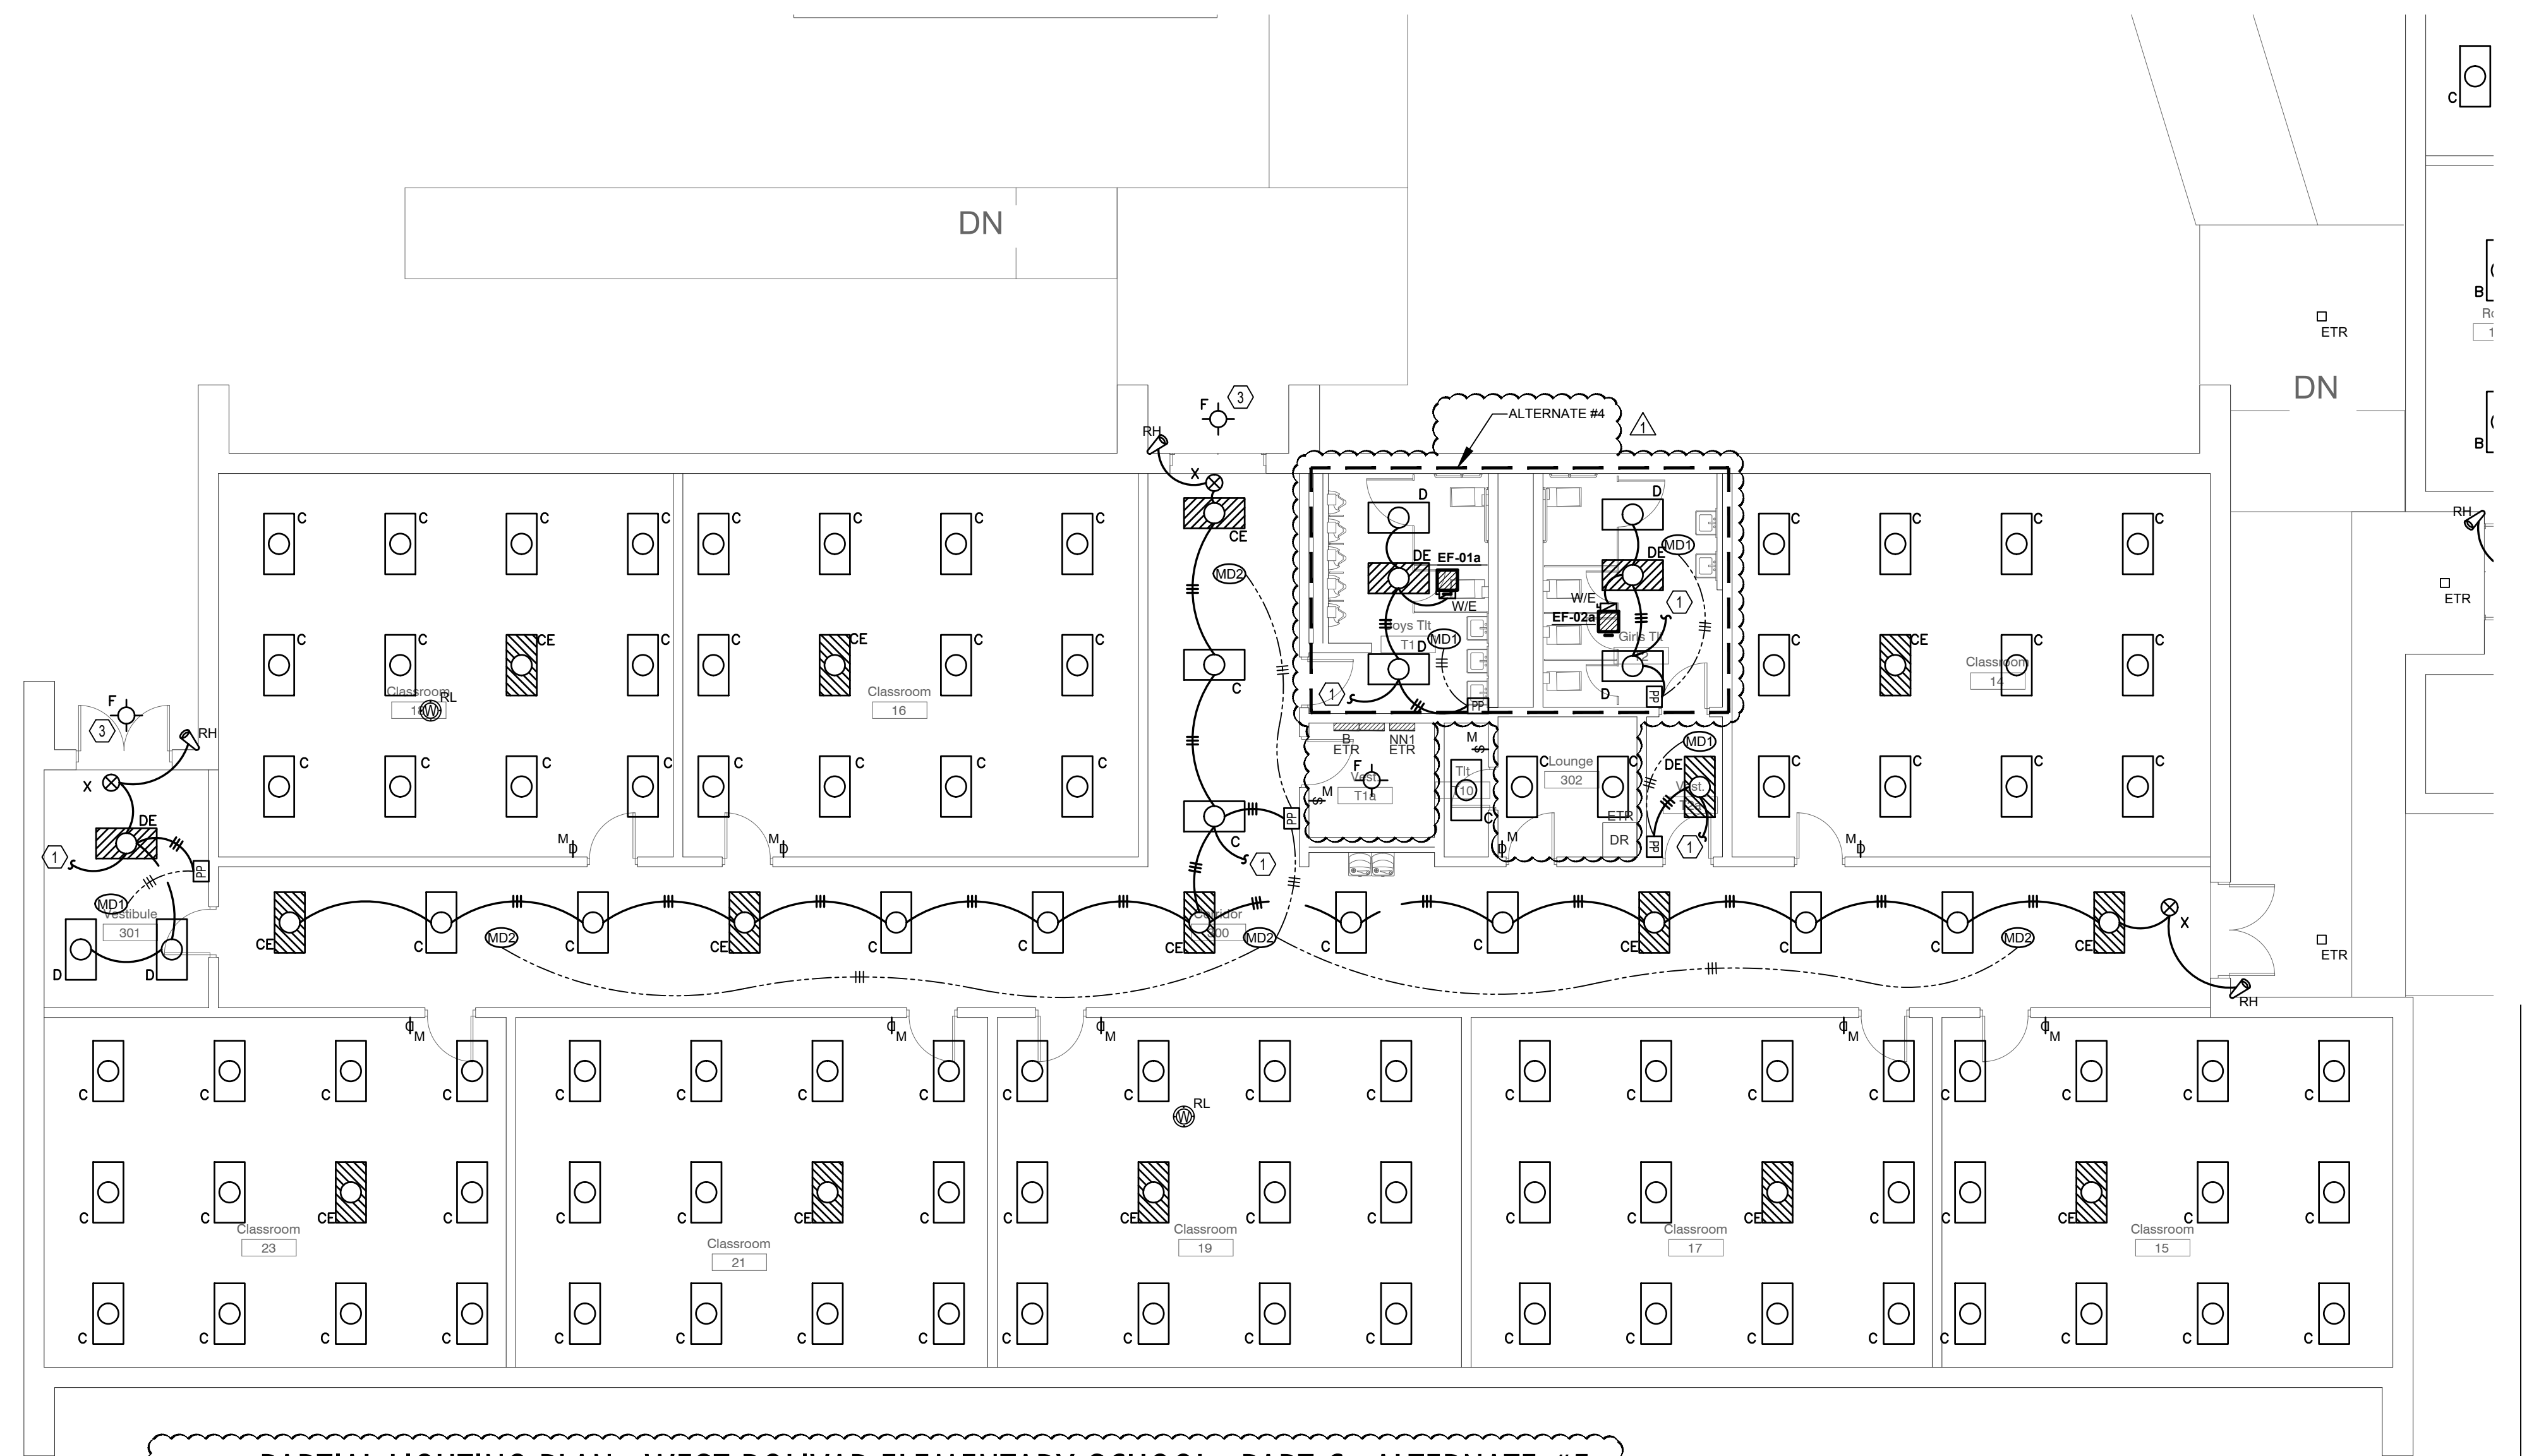

1 PARTIAL LIGHTING PLAN - WEST BOLIVAR ELEMENTARY SCHOOL - PART C - ALTERNATE #5
E-101 Scale: 1/8" = 1'-0"

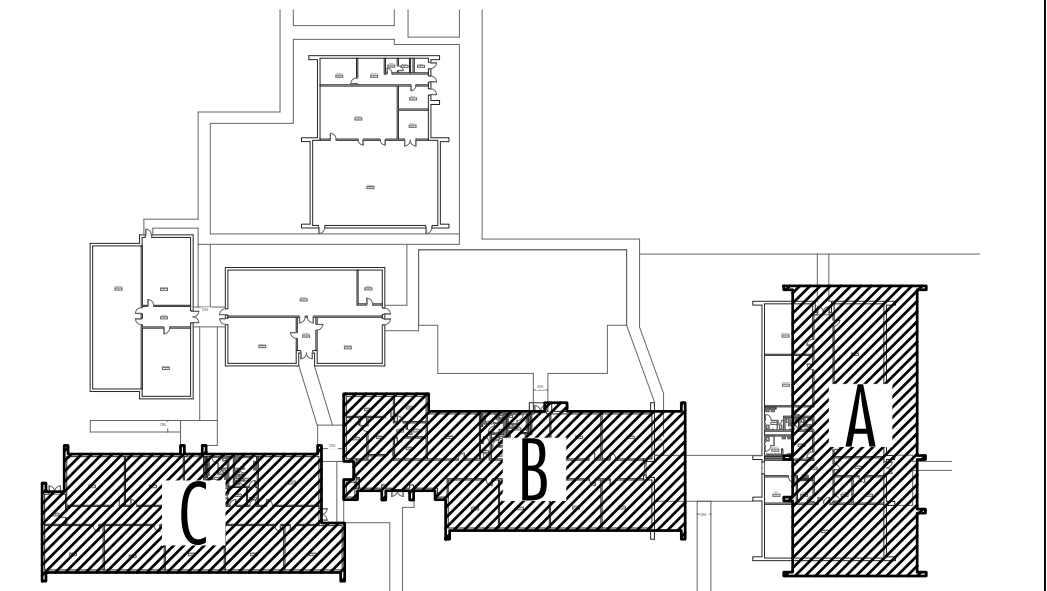


KEY PLAN - PACKAGE A

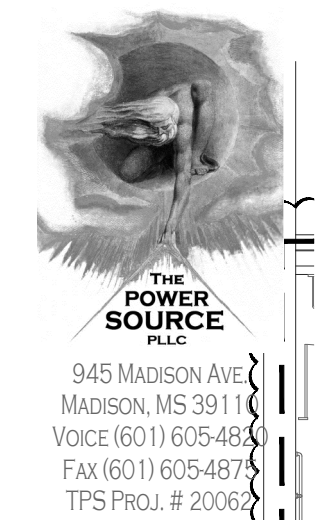

945 MADISON AVE
MADISON, MS 39111

AN ASSOCIATION
OF
M I S S I S S I P P I

DALE BAILEY
JACKSON • BILOXI

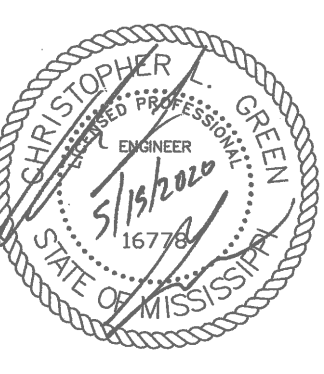

West Bolivar Consolidated School
District Renovation Project

100%
Construction
Documents

Project No	20018
Date	2020-05-15
Drawn	FAB
Checked	CLG
Revisions	Rev Date
ADD#2	2020-06-12

West Bolivar Elementary
E-101
PARTIAL
LIGHTING PLAN


GENERAL NOTES

Mark	Description
1.	CONNECT NEW LIGHT FIXTURES TO EXISTING LIGHT FIXTURE CIRCUITRY IN EACH ROOM UNLESS NOTED OTHERWISE ON DRAWINGS. PROVIDE UNSWITCHED POWER TO ALL EMERGENCY BATTERY PACKS.
2.	CONTRACTOR SHALL PROVIDE DIMMING CABLES FOR ALL LIGHT FIXTURES IN ROOMS THAT REQUIRE DIMMING.
3.	ALL CORRIDOR LIGHT FIXTURES SHALL BE CONTROLLED WITH OCCUPANCY SENSORS (AUTOMATIC ON / OFF). CONTRACTOR SHALL DEMOLISH EXISTING SINGLE POLE SWITCH SERVING EACH CORRIDOR. EXISTING SINGLE POLE SWITCH SERVING EXTERIOR LIGHTS SHALL BE EXISTING TO REMAIN. PROVIDE A STAINLESS STEEL TWO GANG COVER PLATE WITH A BLANK FOR THE DEMOLISHED SWITCH.
4.	REPLACE ALL EXISTING EXIT SIGNS WITH NEW FIXTURE "X". SEE LIGHTING FIXTURE SCHEDULE ON SHEET E-100.


MASTER KEYED NOTES - LIGHTING

Mark	Description
①	CONNECT TO EXISTING CIRCUITRY IN THIS AREA.
②	FIXTURES MOUNTED ABOVE BLEACHERS.
③	CONNECT TO EXISTING EXTERIOR LIGHTING CIRCUIT AND SWITCHING.
④	EXISTING COMPUTER LAB. PROVIDE TWO 20A BREAKERS IN PANEL NN1. RECIRCUIT EXISTING SURFACE MOUNTED RECEPTACLES WITH THESE TWO NEW 20A CIRCUITS.
⑤	EXISTING PROJECTOR IS SWITCHED WITH THE LIGHTS. PROVIDE UNSWITCHED POWER TO THE PROJECTOR.
⑥	PROVIDE A 20A BREAKER IN PANEL NN1.
⑦	PROVIDE A 20A BREAKER IN PANEL NN2.
⑧	PROVIDE A 20A BREAKER IN EXISTING PANEL IN THIS BUILDING.


NOTE:
IF A KEYED NOTE IS NOT SHOWN ON A DRAWING, THEN THE KEYED NOTE SHALL BE IGNORED FOR THAT PARTICULAR DRAWING. THIS SHALL DIFFER FROM DRAWING TO DRAWING.

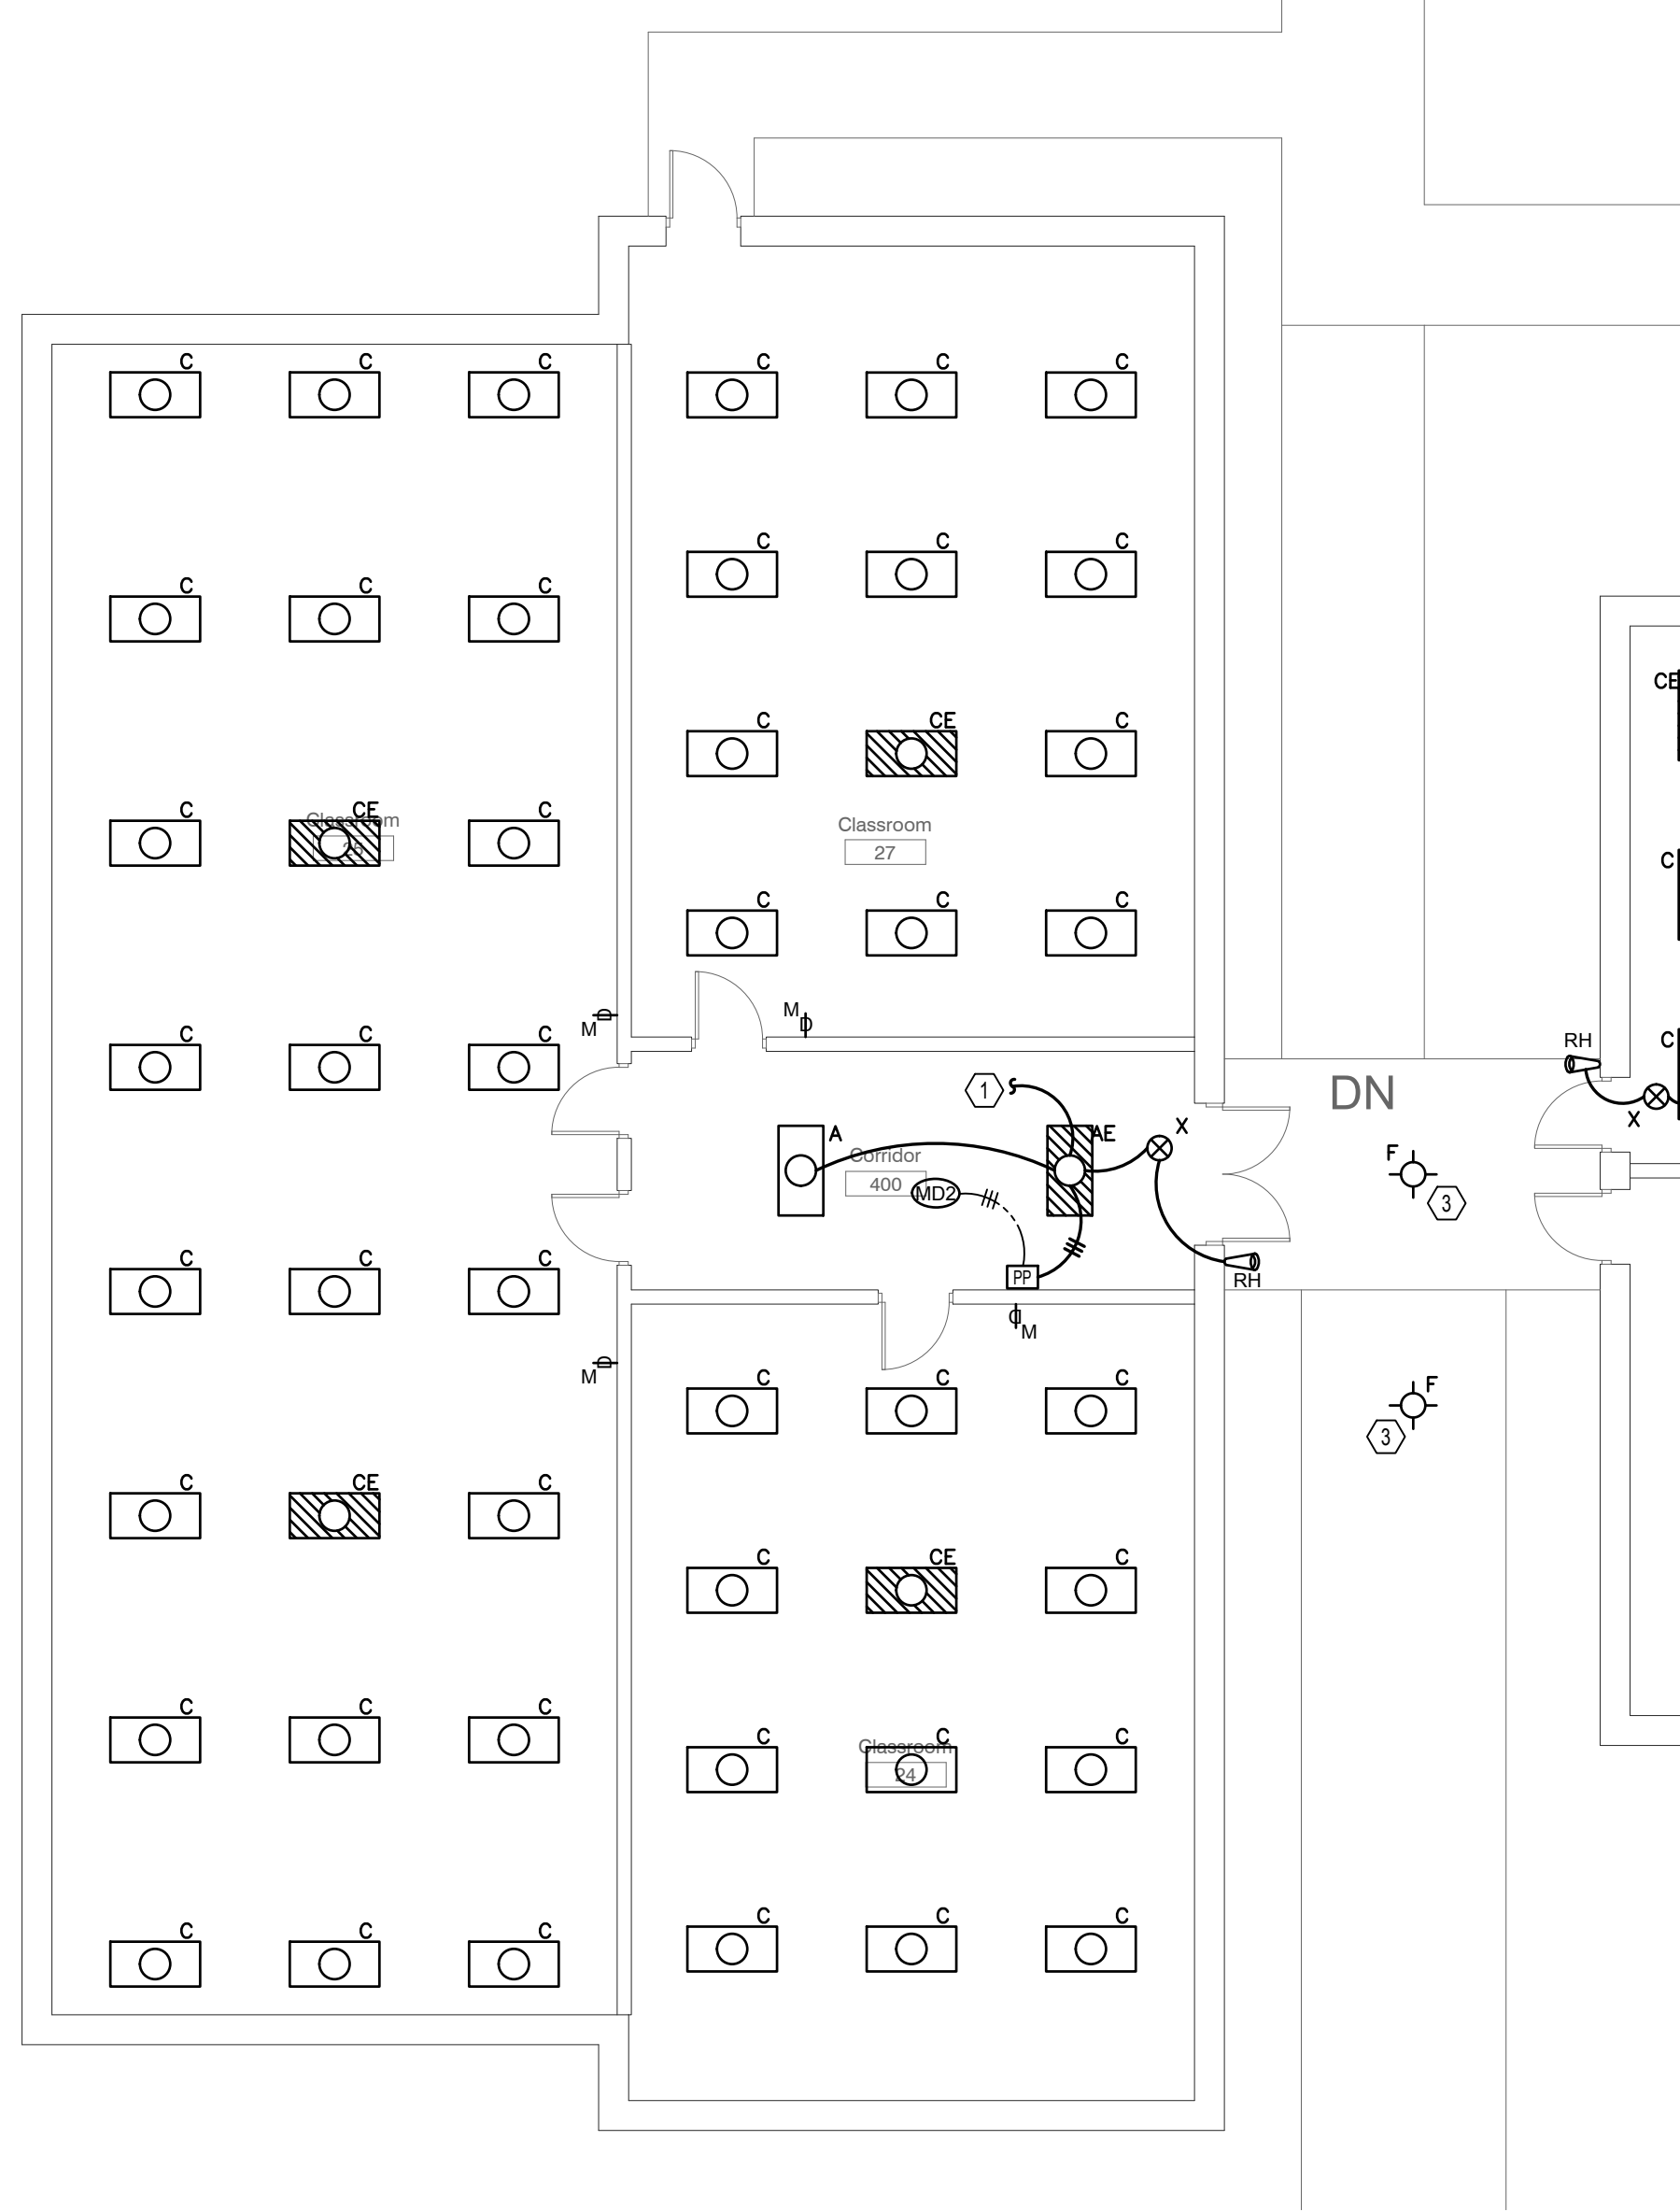


①
E-102
PARTIAL LIGHTING PLAN - WEST BOLIVAR ELEMENTARY SCHOOL - PART D - ALTERNATE #5
Scale: 1/8" = 1'-0"

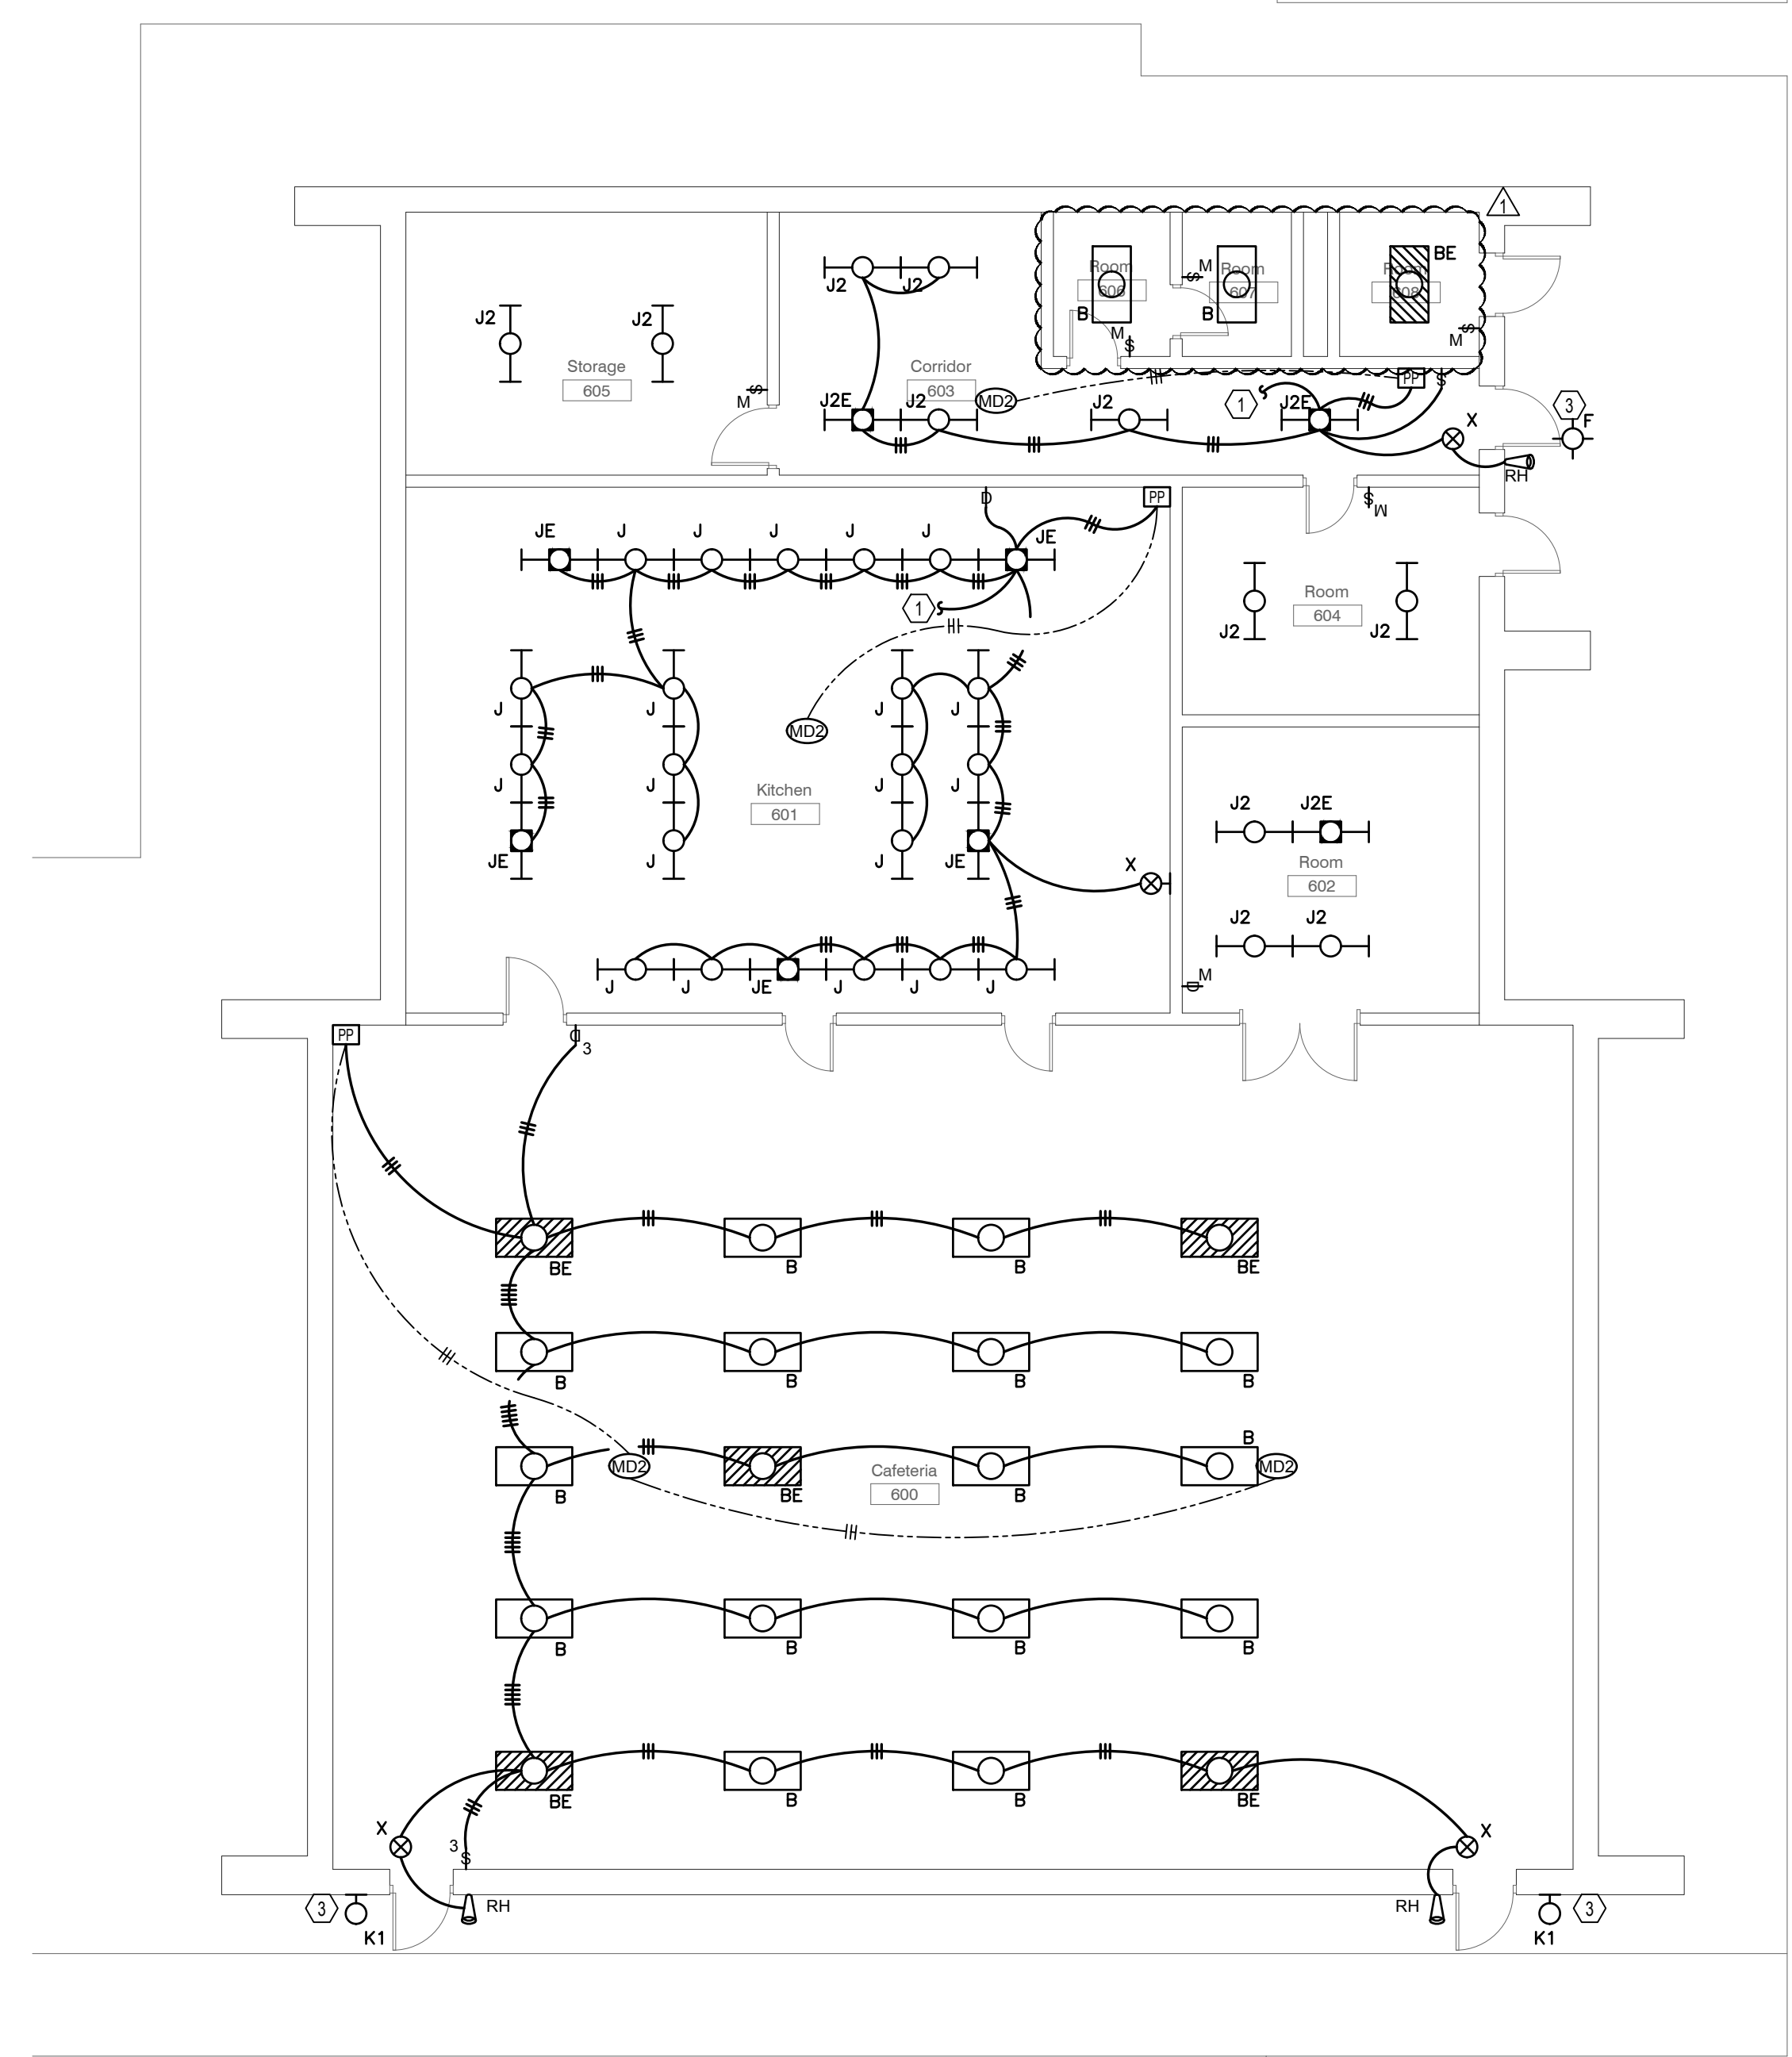


①
E-102
PARTIAL LIGHTING PLAN - WEST BOLIVAR ELEMENTARY SCHOOL - PART F - ALTERNATE #5
Scale: 1/8" = 1'-0"

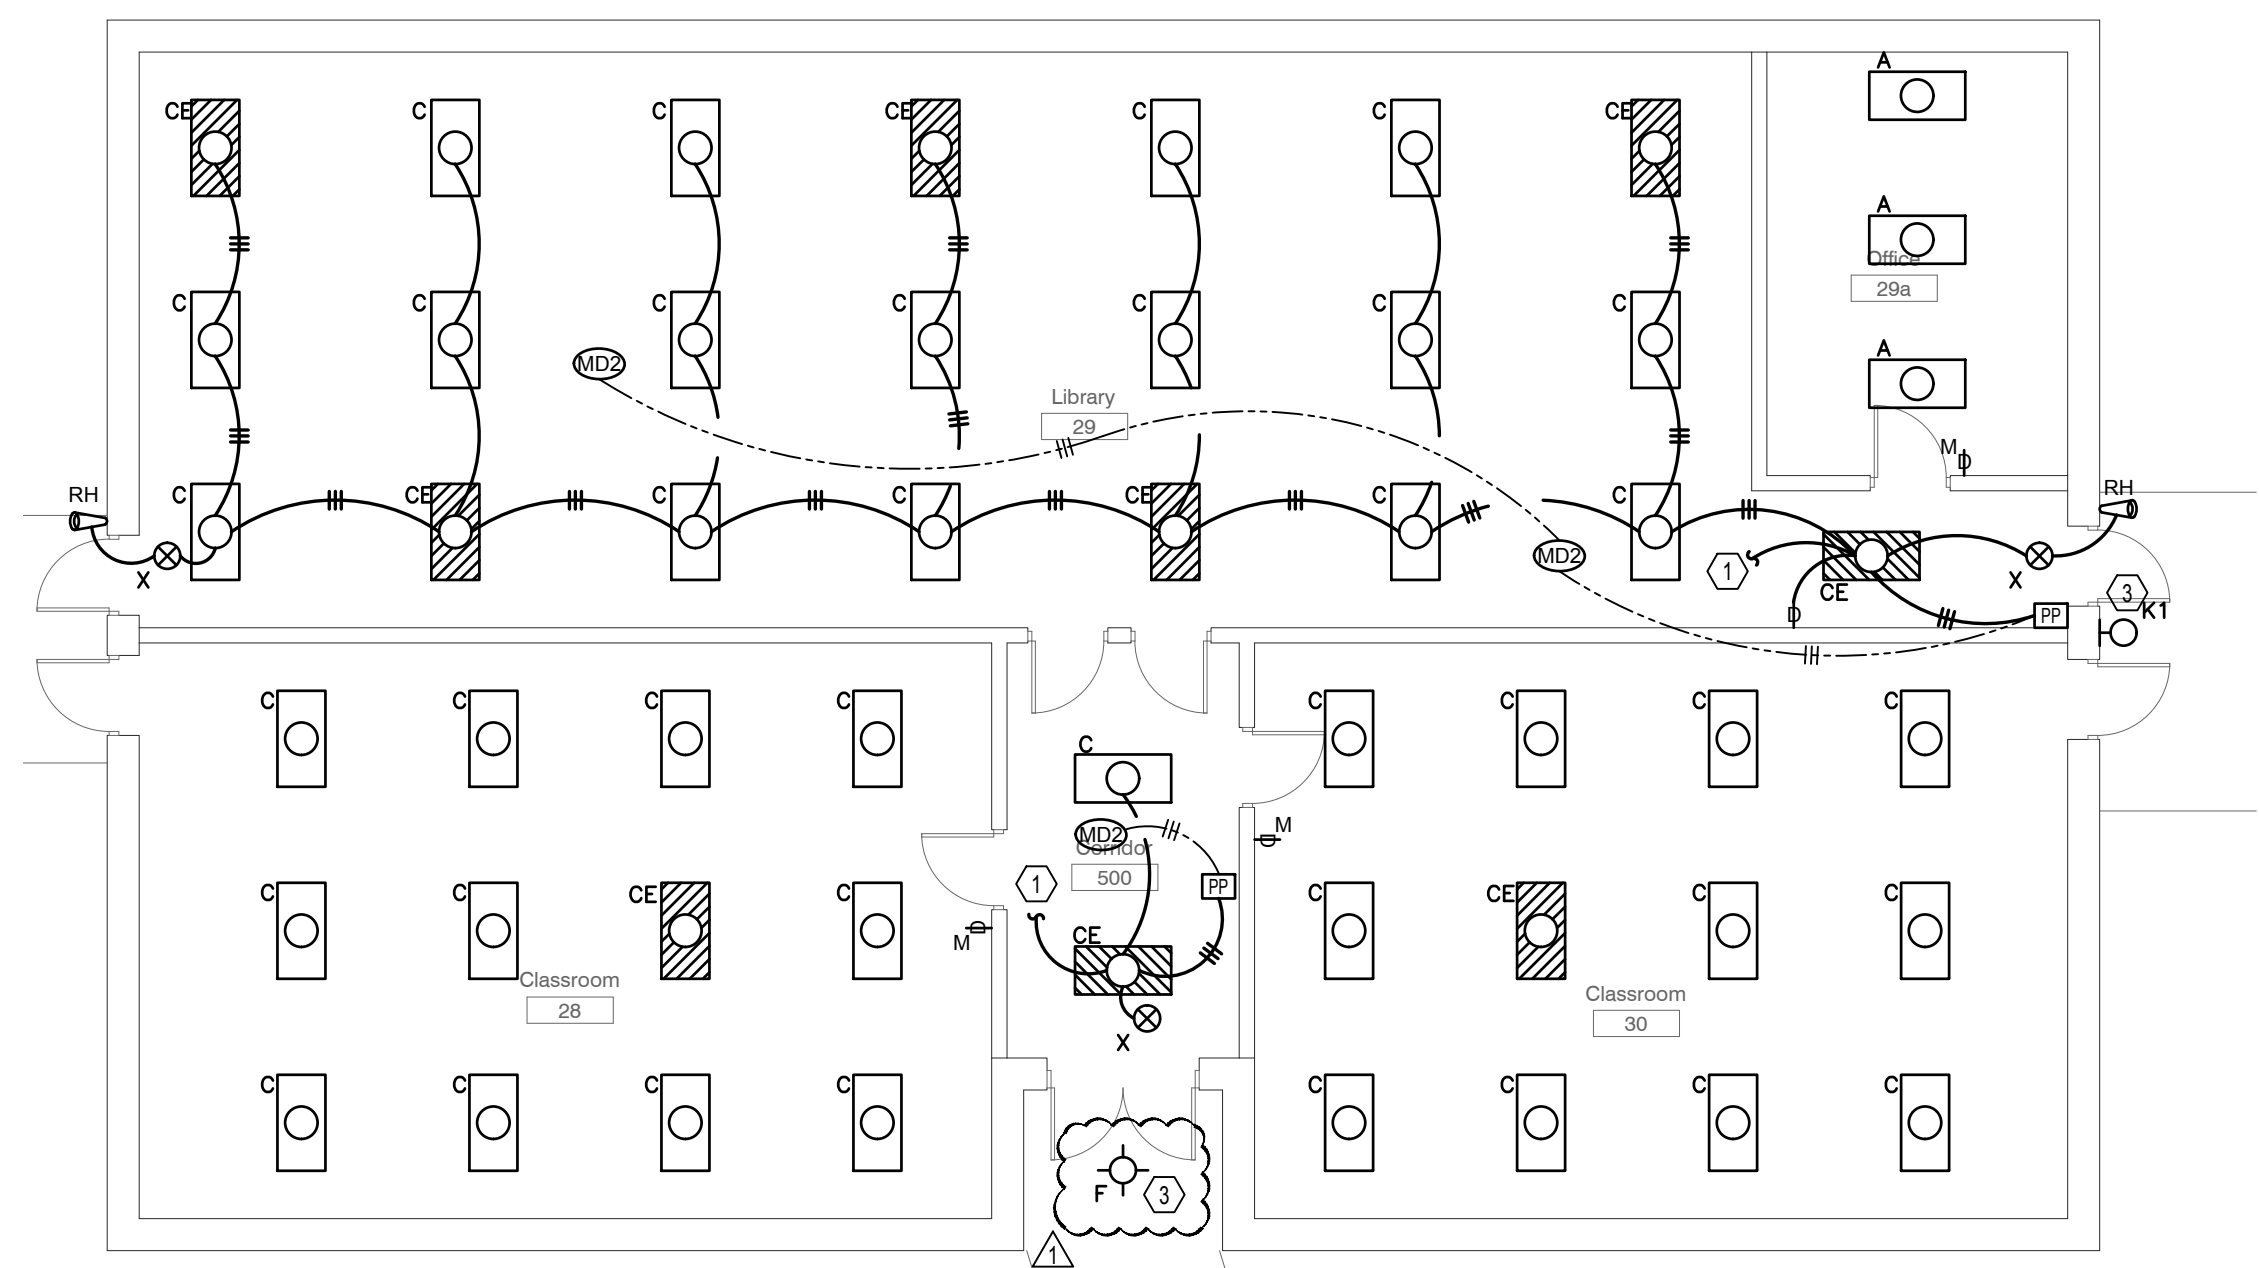

①
E-102
PARTIAL LIGHTING PLAN - WEST BOLIVAR ELEMENTARY SCHOOL - PART E - ALTERNATE #5
Scale: 1/8" = 1'-0"

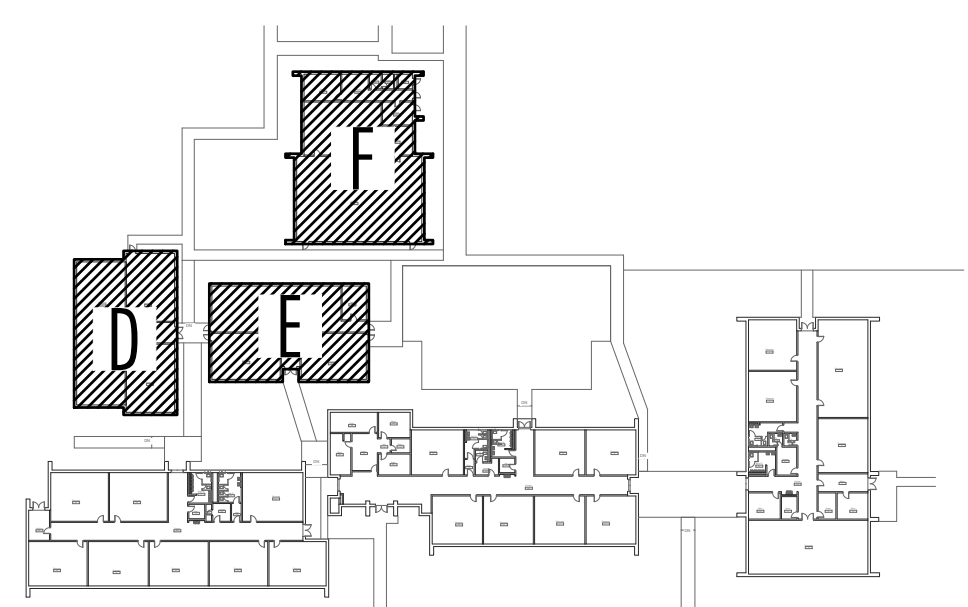


KEY PLAN - PACKAGE A

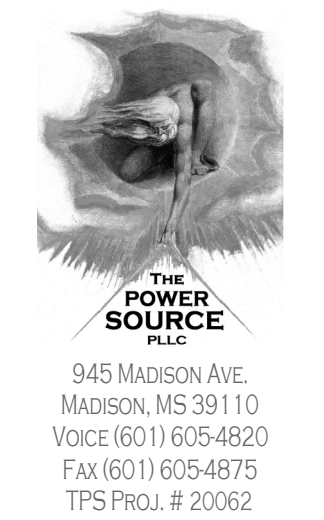

945 MADISON AVE.
MADISON, MS 39110
VOICE (601) 605-4820
FAX (601) 605-4875
TPS PROJ. # 20062

AN ASSOCIATION
M I S S I S S I P P I

DALE BAILEY
JACKSON • BILOXI

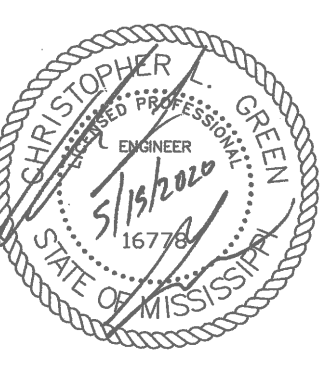


West Bolivar Consolidated School
District Renovation Project

100%
Construction
Documents

Project No	20018
Date	2020-05-15
Drawn	FAB
Checked	CLG
Revisions	Rev Date
ADD#2	2020-06-12

West Bolivar Elementary
E-102
PARTIAL
LIGHTING PLAN

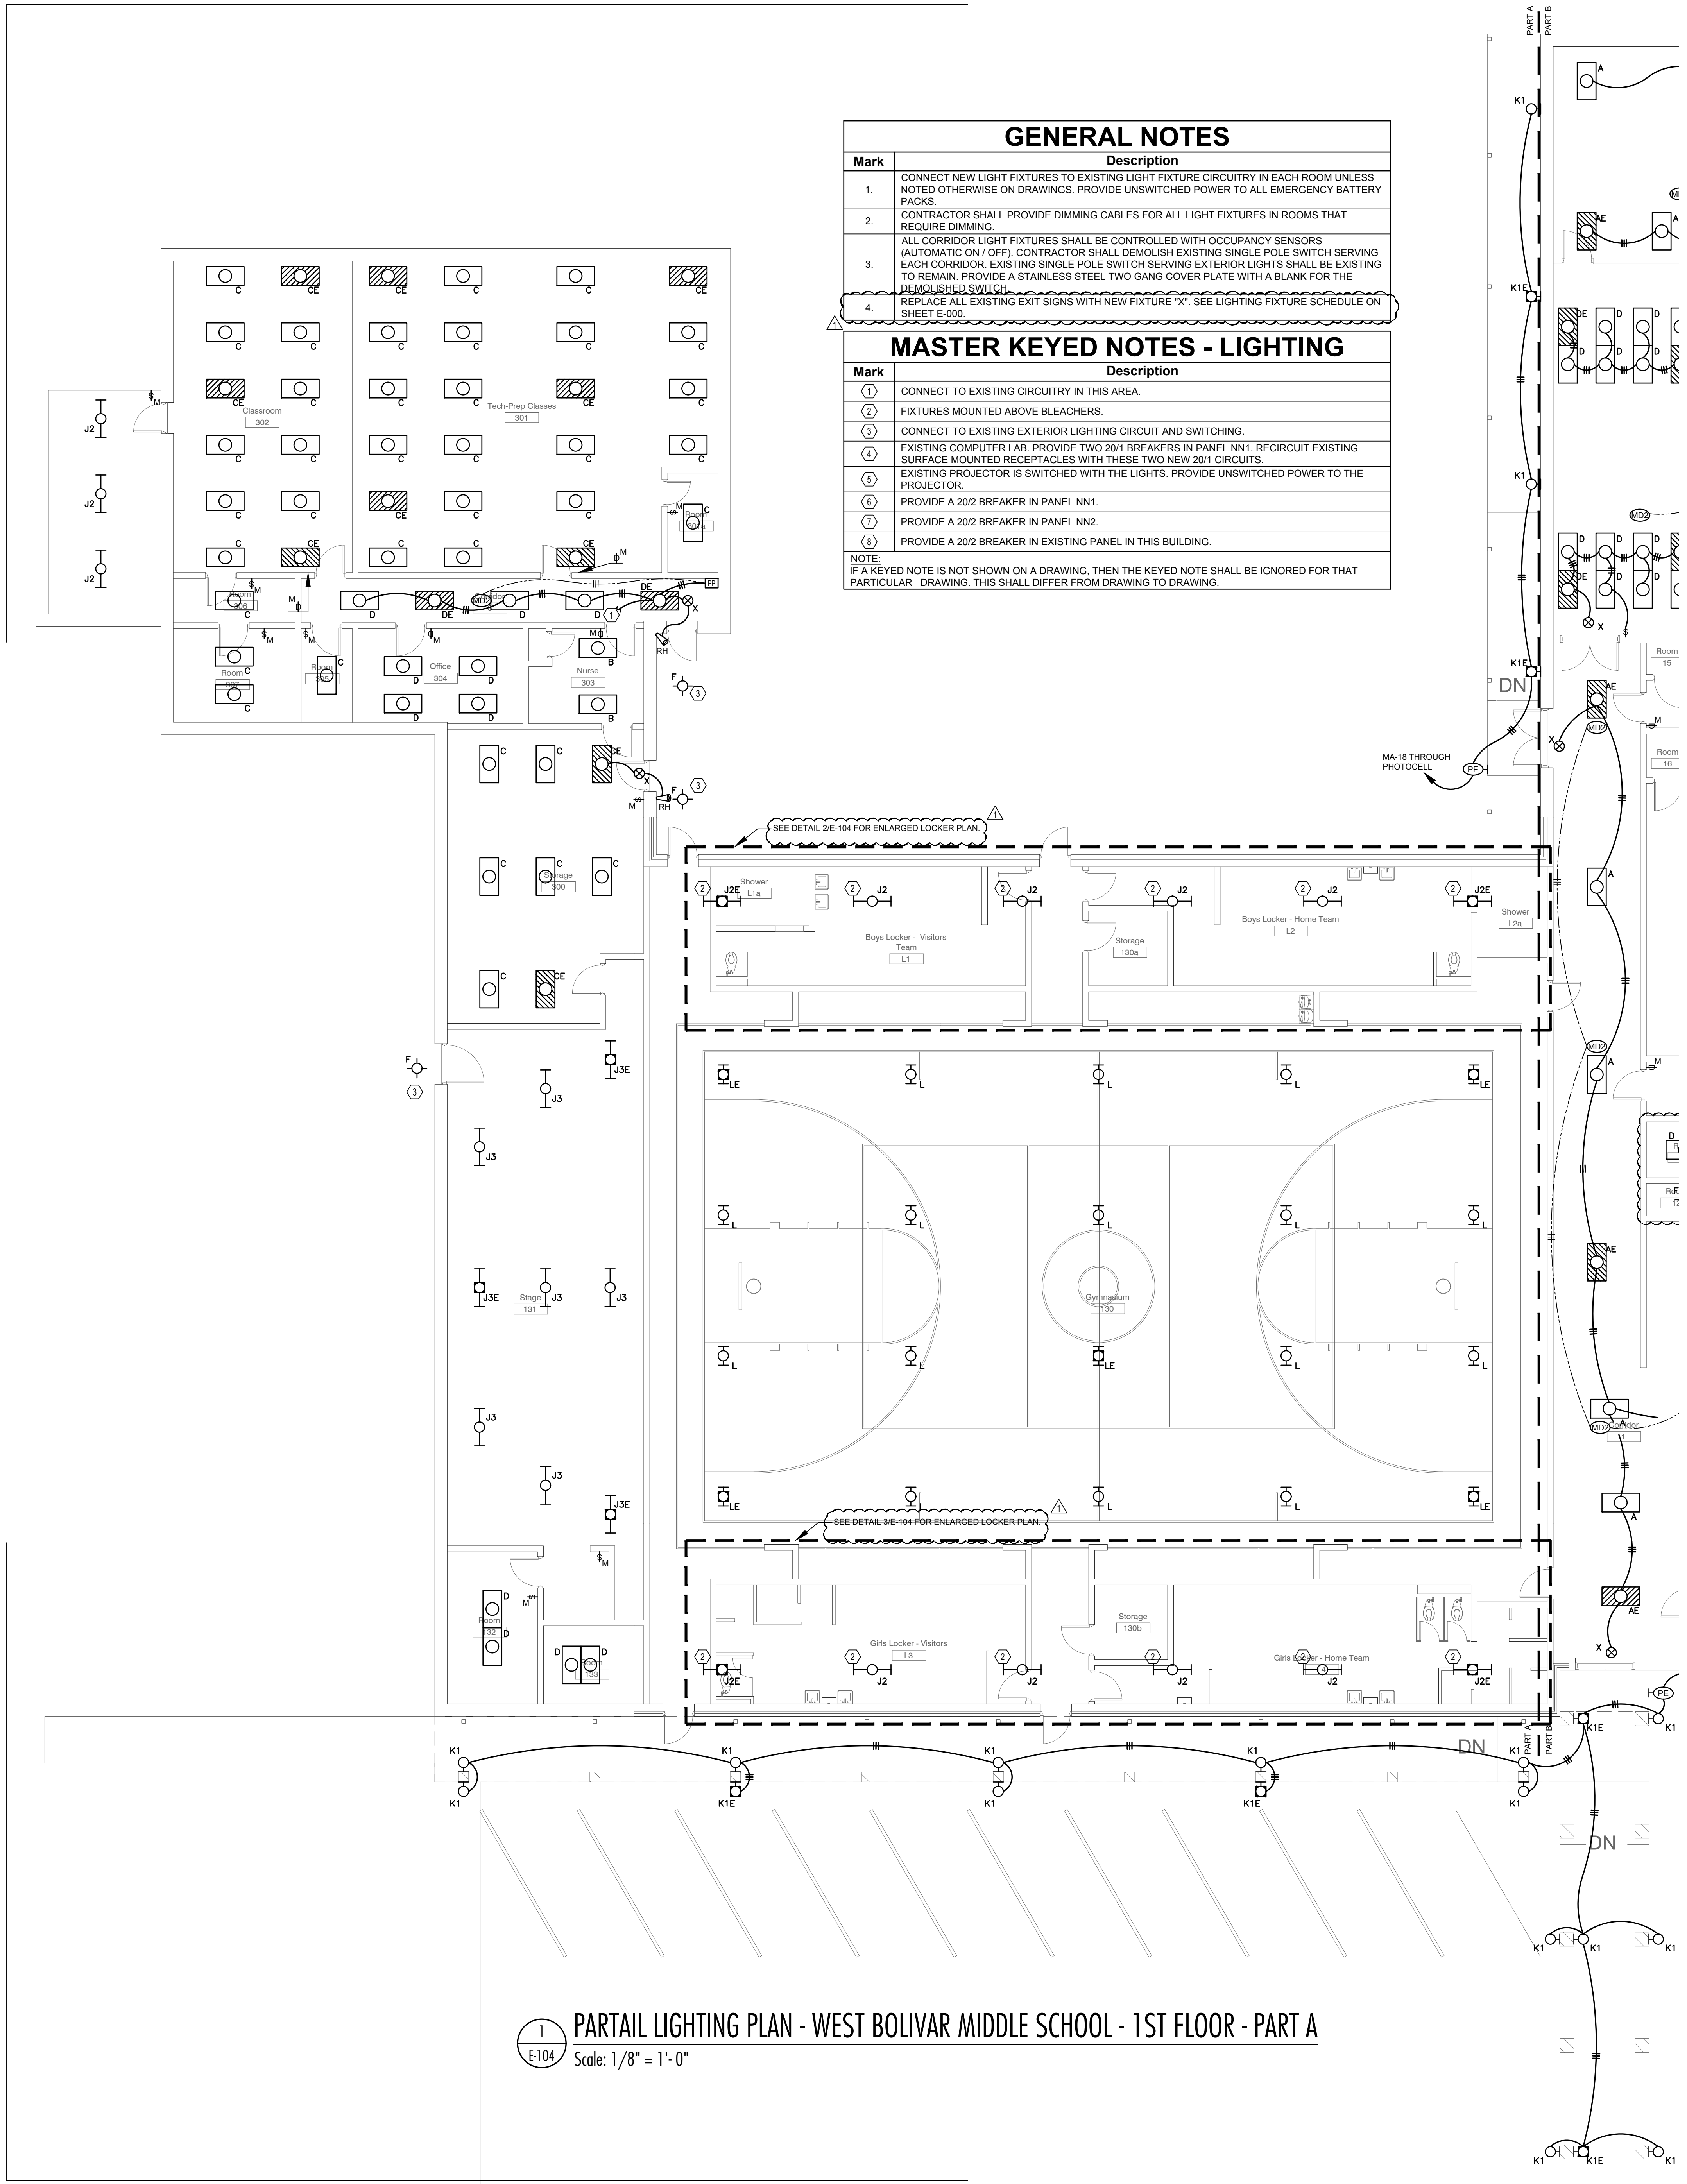


GENERAL NOTES	
Mark	Description
1.	CONNECT NEW LIGHT FIXTURES TO EXISTING LIGHT FIXTURE CIRCUITRY IN EACH ROOM UNLESS NOTED OTHERWISE ON DRAWINGS. PROVIDE UNSWITCHED POWER TO ALL EMERGENCY BATTERY PACKS.
2.	CONTRACTOR SHALL PROVIDE DIMMING CABLES FOR ALL LIGHT FIXTURES IN ROOMS THAT REQUIRE DIMMING.
3.	ALL CORRIDOR LIGHT FIXTURES SHALL BE CONTROLLED WITH OCCUPANCY SENSORS (AUTOMATIC ON / OFF). CONTRACTOR SHALL DEMOLISH EXISTING SINGLE POLE SWITCH SERVING EACH CORRIDOR. EXISTING SINGLE POLE SWITCH SERVING EXTERIOR LIGHTS SHALL BE EXISTING TO REMAIN. PROVIDE A STAINLESS STEEL TWO GANG COVER PLATE WITH A BLANK FOR THE DEMOLISHED SWITCH.
4.	REPLACE ALL EXISTING EXIT SIGNS WITH NEW FIXTURE "X". SEE LIGHTING FIXTURE SCHEDULE ON SHEET E-000.


MASTER KEYED NOTES - LIGHTING	
Mark	Description
①	CONNECT TO EXISTING CIRCUITRY IN THIS AREA.
②	FIXTURES MOUNTED ABOVE BLEACHERS.
③	CONNECT TO EXISTING EXTERIOR LIGHTING CIRCUIT AND SWITCHING.
④	EXISTING COMPUTER LAB. PROVIDE TWO 20T BREAKERS IN PANEL NN1. RECIRCUIT EXISTING SURFACE MOUNTED RECEPTACLES WITH THESE TWO NEW 20T CIRCUITS.
⑤	EXISTING PROJECTOR IS SWITCHED WITH THE LIGHTS. PROVIDE UNSWITCHED POWER TO THE PROJECTOR.
⑥	PROVIDE A 20/2 BREAKER IN PANEL NN1.
⑦	PROVIDE A 20/2 BREAKER IN PANEL NN2.
⑧	PROVIDE A 20/2 BREAKER IN EXISTING PANEL IN THIS BUILDING.

NOTE:
IF A KEYED NOTE IS NOT SHOWN ON A DRAWING, THEN THE KEYED NOTE SHALL BE IGNORED FOR THAT PARTICULAR DRAWING. THIS SHALL DIFFER FROM DRAWING TO DRAWING.


① PARTIAL LIGHTING PLAN - WEST BOLIVAR MIDDLE SCHOOL - 1ST FLOOR - PART A
E-104 Scale: 1/8" = 1'-0"

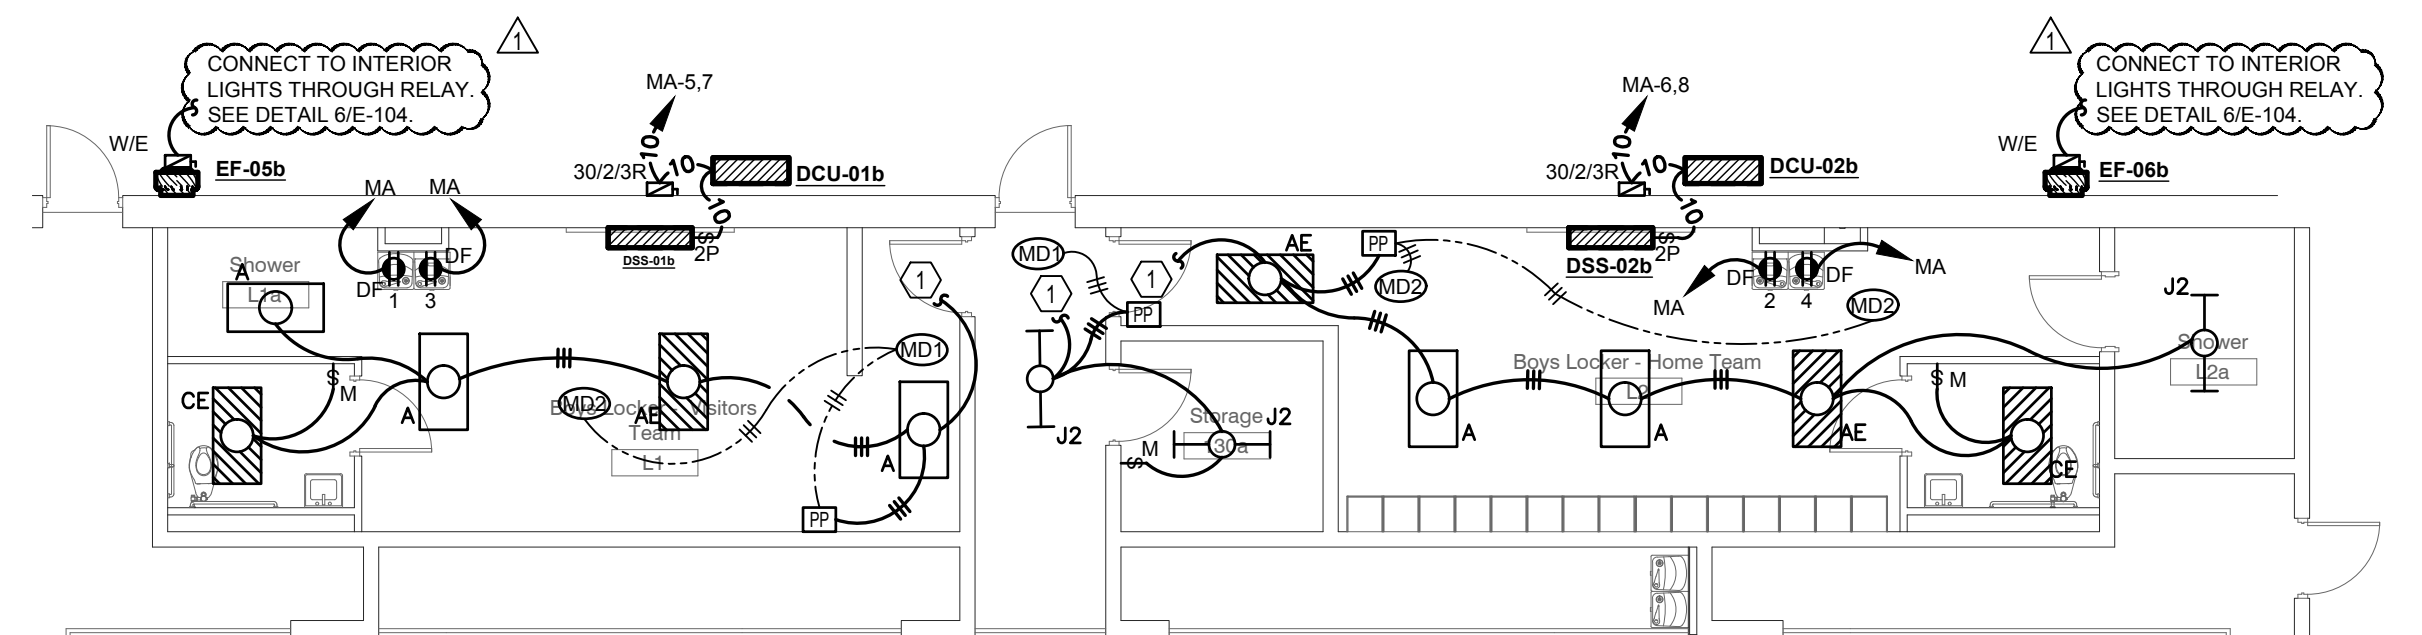

② PARTIAL LIGHTING PLAN - WEST BOLIVAR MIDDLE SCHOOL - 1ST FLOOR - ENLARGED LOCKERS
E-104 Scale: 1/8" = 1'-0"

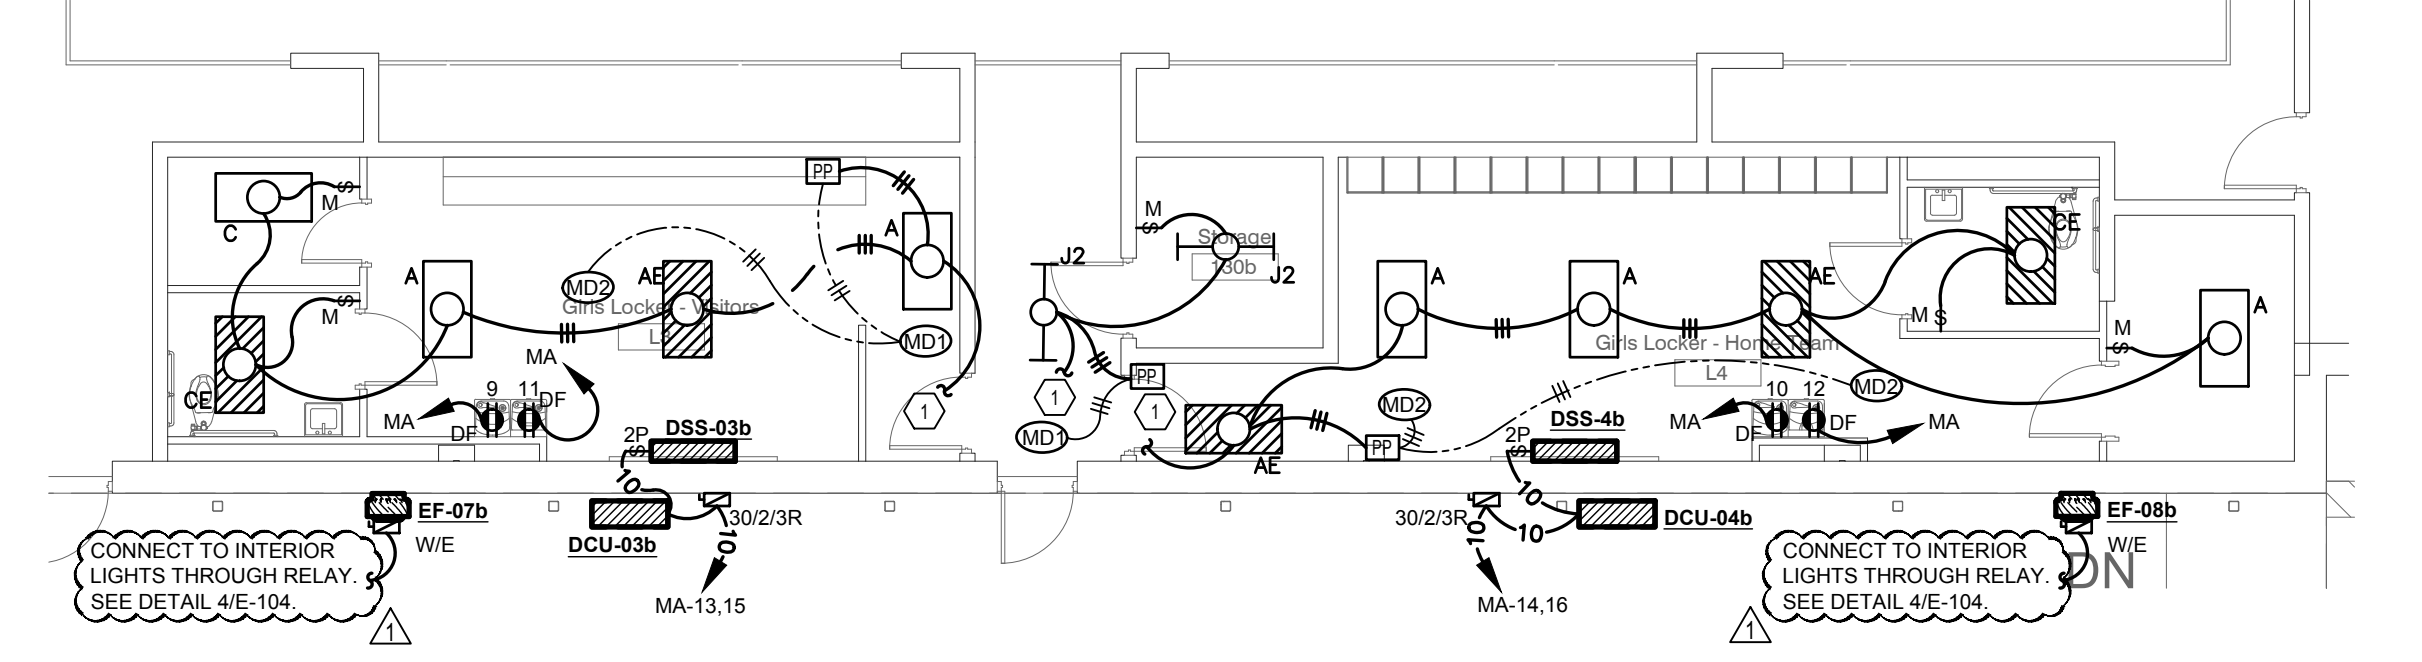


③ PARTIAL LIGHTING PLAN - WEST BOLIVAR MIDDLE SCHOOL - 1ST FLOOR - ENLARGED LOCKERS
E-104 Scale: 1/8" = 1'-0"

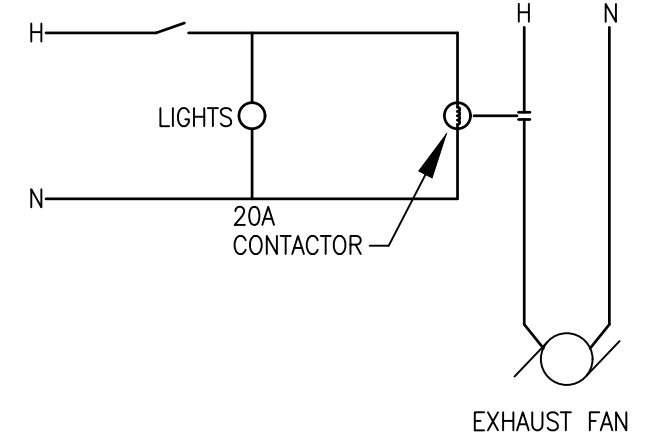

④ EXHAUST FAN DETAIL - EF-05b, EF-06b, EF-07b, EF-08b
E-104 Scale: NONE



KEY PLAN - PACKAGE B - 2ND FLOOR

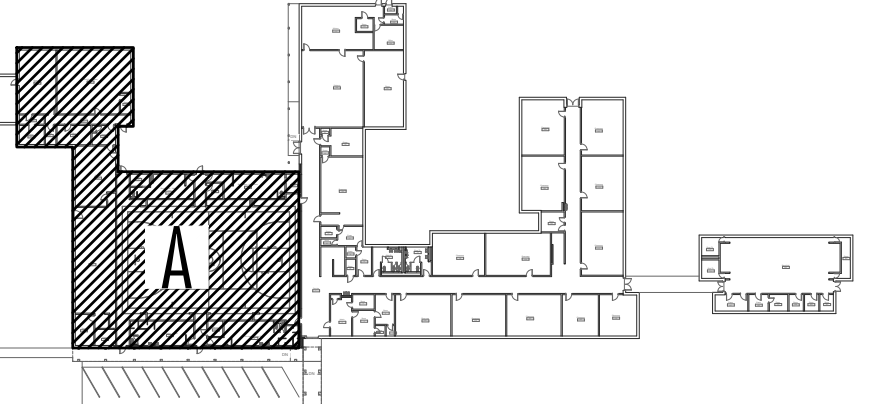


KEY PLAN - PACKAGE B - 1ST FLOOR



945 MADISON AVE.
MADISON, MS 39110
TPS PROJ. # 20062

AN ASSOCIATION
OF
ELECTRICAL CONTRACTORS
OF
MISSISSIPPI

DALE BAILEY
JACKSON • BILOXI

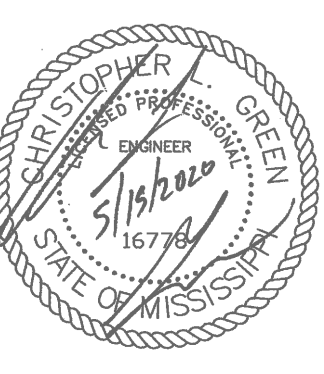


West Bolivar Consolidated School
District Renovation Project

100%
Construction
Documents

Project No	20018
Date	2020-05-15
Drawn	FAB
Checked	CLG
Revisions	Rev Date
ADD#2	2020-06-12


West Bolivar Middle School
E-104
PARTIAL LIGHTING
PLAN - PART A

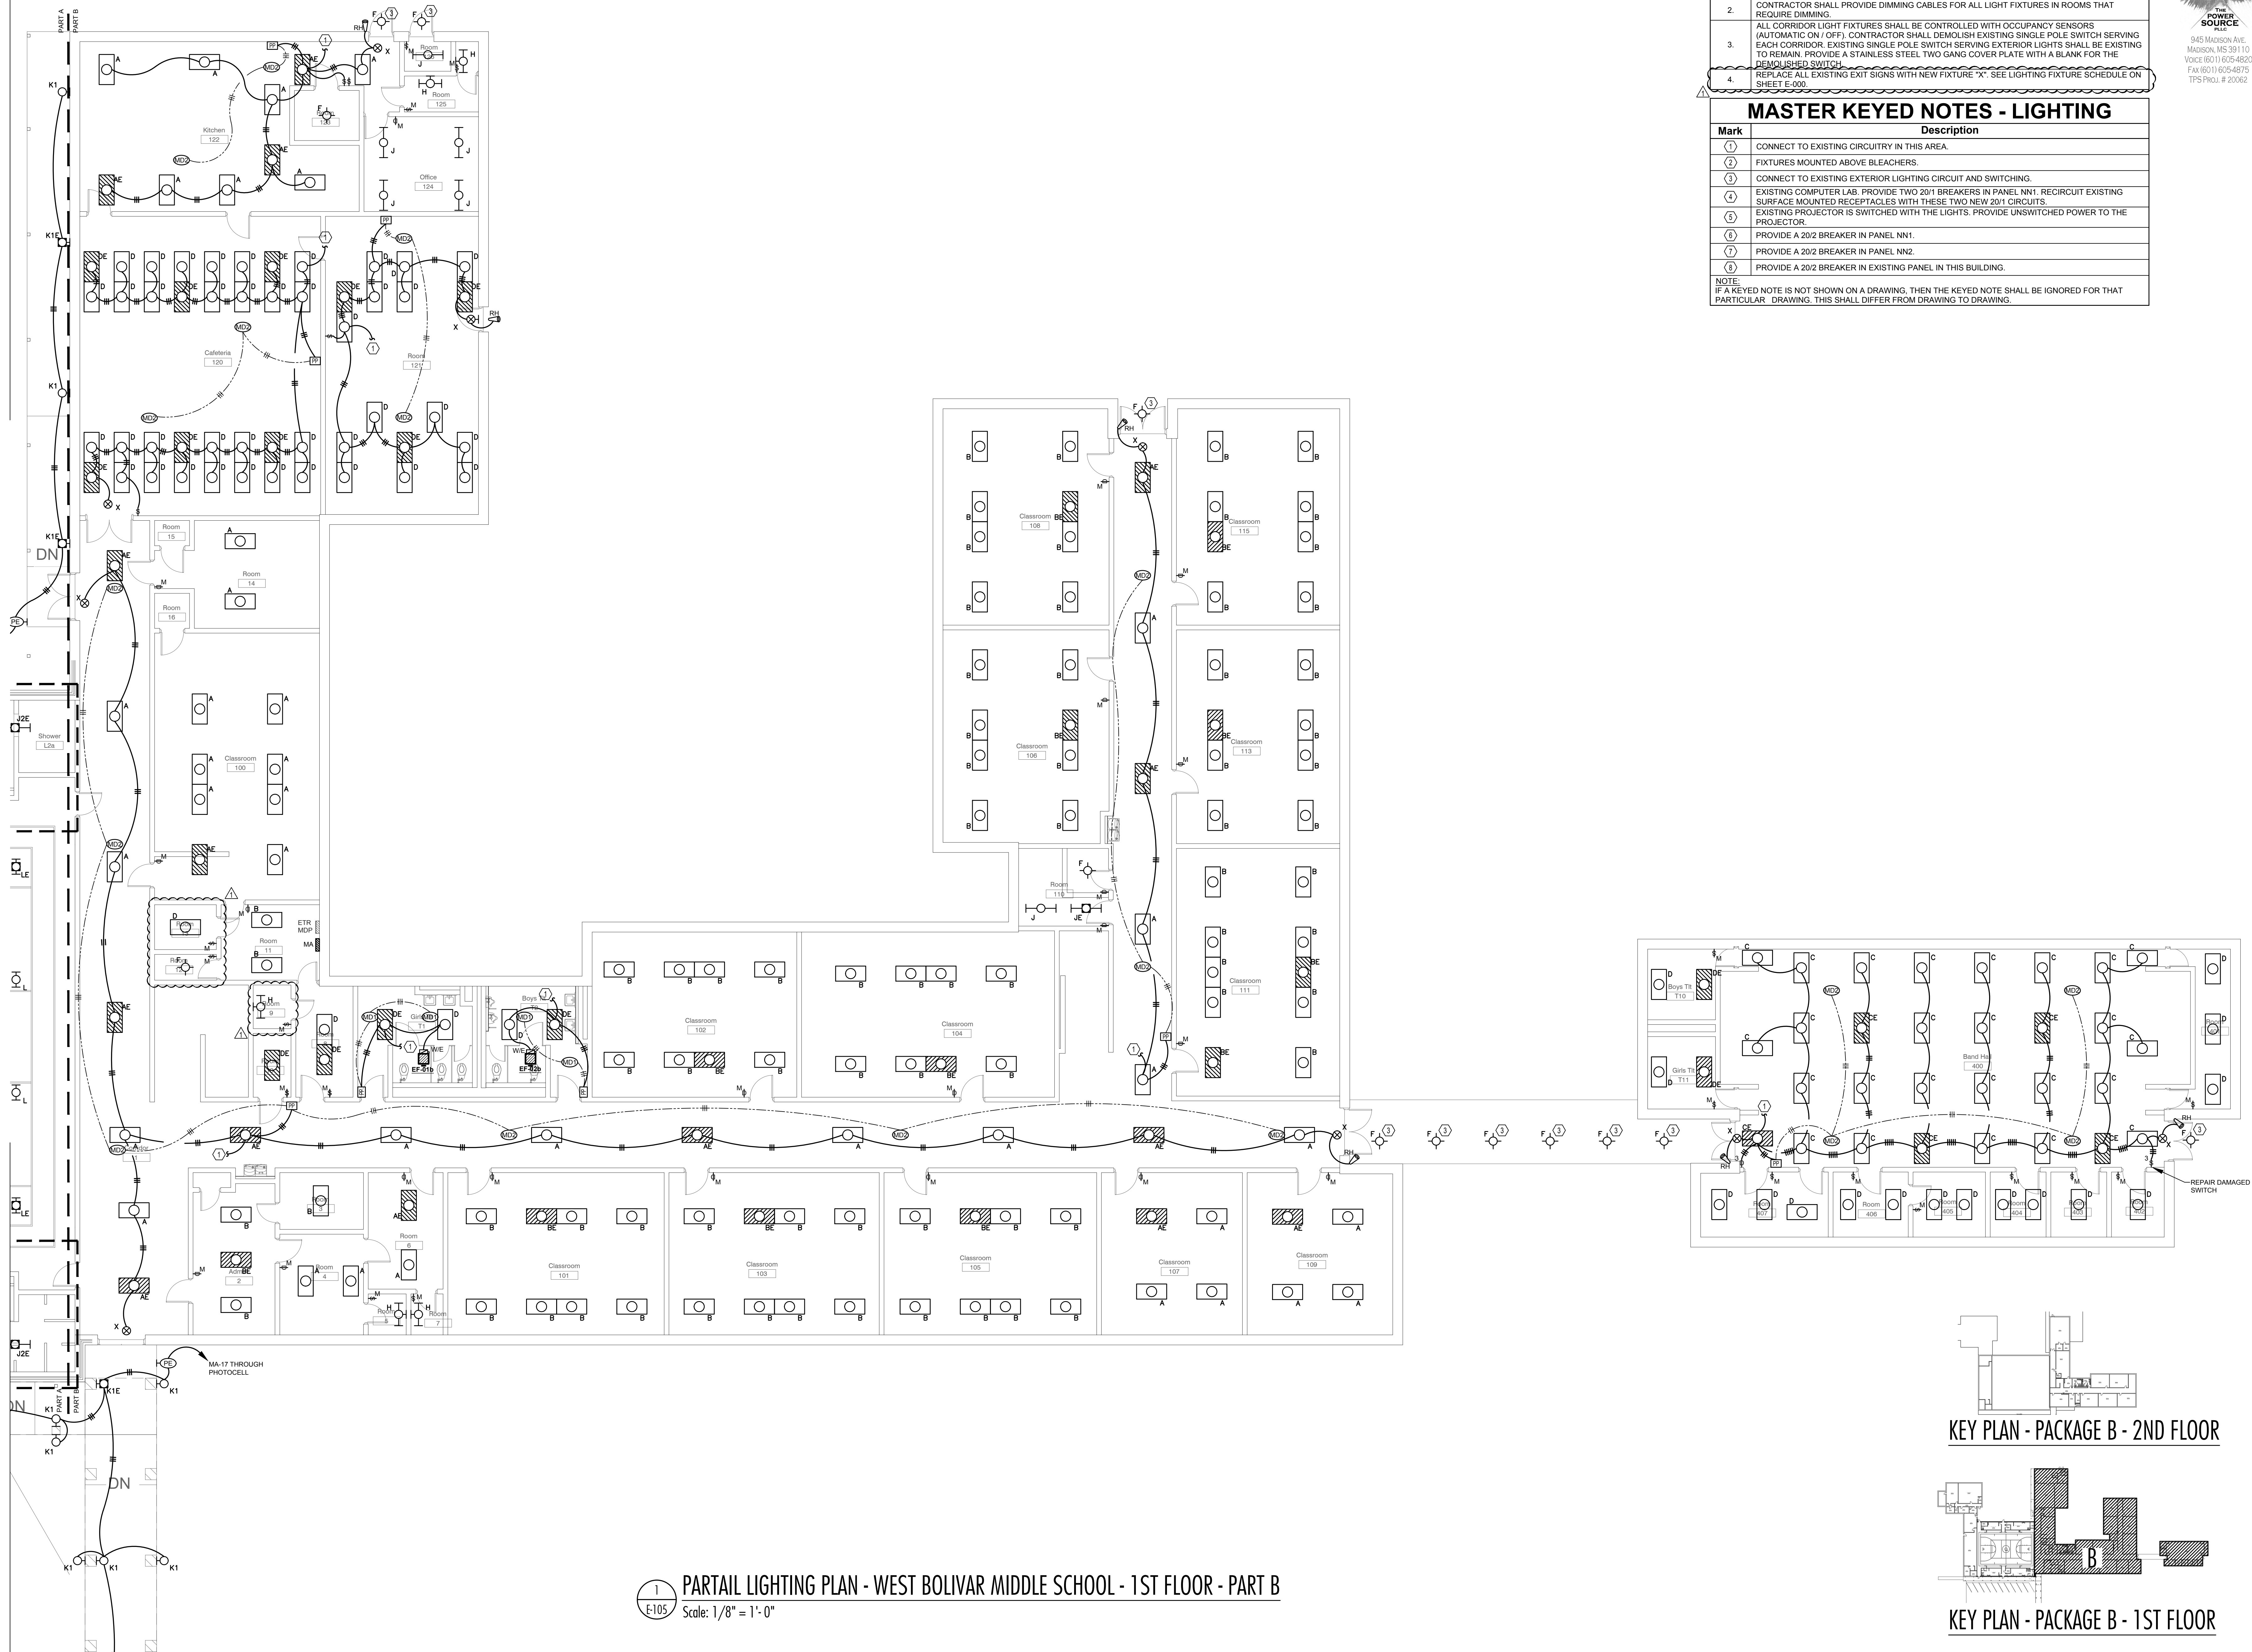

GENERAL NOTES	
Mark	Description
1.	CONNECT NEW LIGHT FIXTURES TO EXISTING LIGHT FIXTURE CIRCUITRY IN EACH ROOM UNLESS NOTED OTHERWISE ON DRAWINGS. PROVIDE UNSWITCHED POWER TO ALL EMERGENCY BATTERY PACKS.
2.	CONTRACTOR SHALL PROVIDE DIMMING CABLES FOR ALL LIGHT FIXTURES IN ROOMS THAT REQUIRE DIMMING.
3.	ALL CORRIDOR LIGHT FIXTURES SHALL BE CONTROLLED WITH OCCUPANCY SENSORS (AUTOMATIC ON / OFF). CONTRACTOR SHALL DEMOLISH EXISTING SINGLE POLE SWITCH SERVING EACH CORRIDOR. EXISTING SINGLE POLE SWITCH SERVING EXTERIOR LIGHTS SHALL BE EXISTING TO REMAIN. PROVIDE A STAINLESS STEEL TWO GANG COVER PLATE WITH A BLANK FOR THE DEMOLISHED SWITCH.
4.	REPLACE ALL EXISTING EXIT SIGNS WITH NEW FIXTURE "X". SEE LIGHTING FIXTURE SCHEDULE ON SHEET E-000.


MASTER KEYED NOTES - LIGHTING	
Mark	Description
①	CONNECT TO EXISTING CIRCUITRY IN THIS AREA.
②	FIXTURES MOUNTED ABOVE BLEACHERS.
③	CONNECT TO EXISTING EXTERIOR LIGHTING CIRCUIT AND SWITCHING.
④	EXISTING COMPUTER LAB. PROVIDE TWO 201 BREAKERS IN PANEL NN1. RECIRCUIT EXISTING SURFACE MOUNTED RECEPTACLES WITH THESE TWO NEW 201 CIRCUITS.
⑤	EXISTING PROJECTOR IS SWITCHED WITH THE LIGHTS. PROVIDE UNSWITCHED POWER TO THE PROJECTOR.
⑥	PROVIDE A 202 BREAKER IN PANEL NN1.
⑦	PROVIDE A 202 BREAKER IN PANEL NN2.
⑧	PROVIDE A 202 BREAKER IN EXISTING PANEL IN THIS BUILDING.

NOTE:
IF A KEYED NOTE IS NOT SHOWN ON A DRAWING, THEN THE KEYED NOTE SHALL BE IGNORED FOR THAT PARTICULAR DRAWING. THIS SHALL DIFFER FROM DRAWING TO DRAWING.

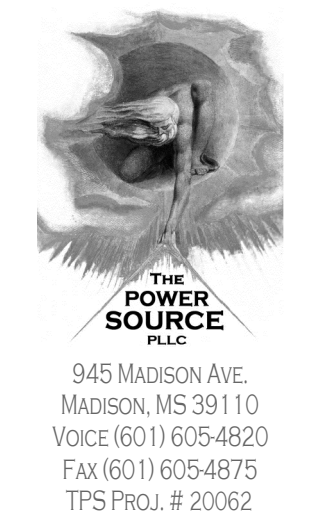

945 MADISON AVE.
MADISON, MS 39110
VOICE (601) 605-4820
FAX (601) 605-4875
TPO PROJ. # 20062

AN ASSOCIATION
DALE BAILEY
JACKSON • BILOXI


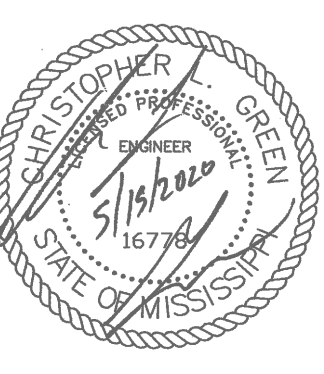


West Bolivar Consolidated School
District Renovation Project

100%
Construction
Documents

Project No	20018
Date	2020-05-15
Drawn	FAB
Checked	CLG
Revisions	Rev Date
▲ ADD#2	2020-06-12


West Bolivar Middle School
E-105
PARTIAL LIGHTING
PLAN - PART B

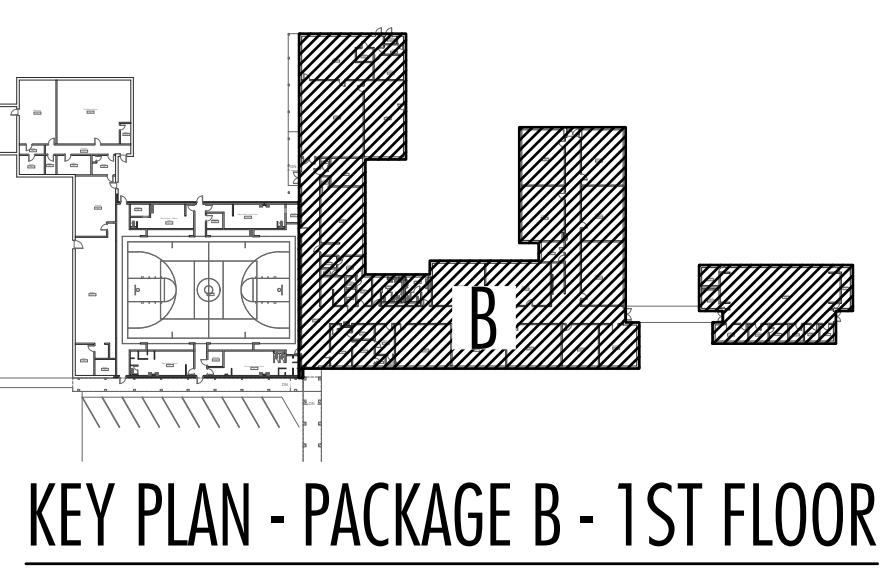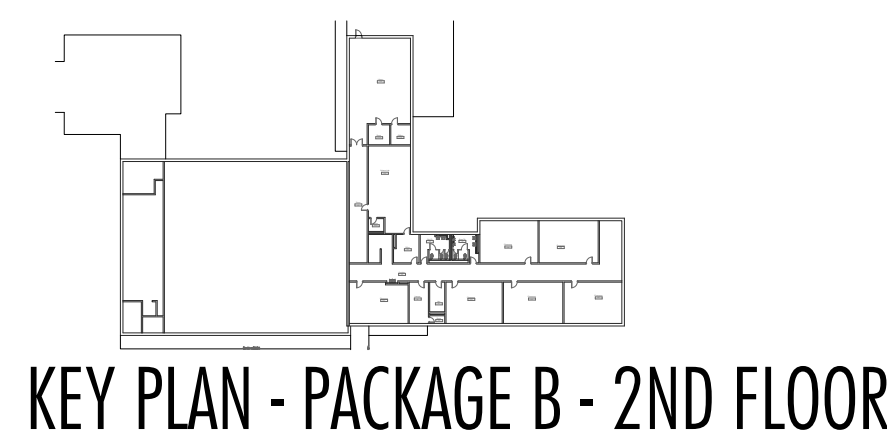

GENERAL NOTES	
Mark	Description
1.	CONNECT NEW LIGHT FIXTURES TO EXISTING LIGHT FIXTURE CIRCUITRY IN EACH ROOM UNLESS NOTED OTHERWISE ON DRAWINGS. PROVIDE UNSWITCHED POWER TO ALL EMERGENCY BATTERY PACKS.
2.	CONTRACTOR SHALL PROVIDE DIMMING CABLES FOR ALL LIGHT FIXTURES IN ROOMS THAT REQUIRE DIMMING.
3.	ALL CORRIDOR LIGHT FIXTURES SHALL BE CONTROLLED WITH OCCUPANCY SENSORS (AUTOMATIC ON / OFF). CONTRACTOR SHALL DEMOLISH EXISTING SINGLE POLE SWITCH SERVING EACH CORRIDOR. EXISTING SINGLE POLE SWITCH SERVING EXTERIOR LIGHTS SHALL BE EXISTING TO REMAIN. PROVIDE A STAINLESS STEEL TWO GANG COVER PLATE WITH A BLANK FOR THE DEMOLISHED SWITCH.
4.	REPLACE ALL EXISTING EXIT SIGNS WITH NEW FIXTURE "X". SEE LIGHTING FIXTURE SCHEDULE ON SHEET E-050.

MASTER KEYED NOTES - LIGHTING	
Mark	Description
①	CONNECT TO EXISTING CIRCUITRY IN THIS AREA.
②	FIXTURES MOUNTED ABOVE BLEACHERS.
③	CONNECT TO EXISTING EXTERIOR LIGHTING CIRCUIT AND SWITCHING.
④	EXISTING COMPUTER LAB. PROVIDE TWO 201 BREAKERS IN PANEL NN1. RECIRCUIT EXISTING SURFACE MOUNTED RECEPTACLES WITH THESE TWO NEW 201 CIRCUITS.
⑤	EXISTING PROJECTOR IS SWITCHED WITH THE LIGHTS. PROVIDE UNSWITCHED POWER TO THE PROJECTOR.
⑥	PROVIDE A 202 BREAKER IN PANEL NN1.
⑦	PROVIDE A 202 BREAKER IN PANEL NN2.
⑧	PROVIDE A 202 BREAKER IN EXISTING PANEL IN THIS BUILDING.


NOTE:
IF A KEYED NOTE IS NOT SHOWN ON A DRAWING, THEN THE KEYED NOTE SHALL BE IGNORED FOR THAT PARTICULAR DRAWING. THIS SHALL DIFFER FROM DRAWING TO DRAWING.

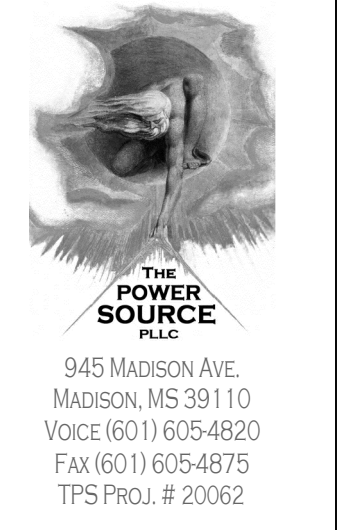

THE POWER SOURCE LLC
945 MADISON AVE.
MADISON, MS 39110
TPS PROJ. # 20062

AN ASSOCIATION
M I S S I S S I P P I

DALE BAILEY
JACKSON • BILOXI

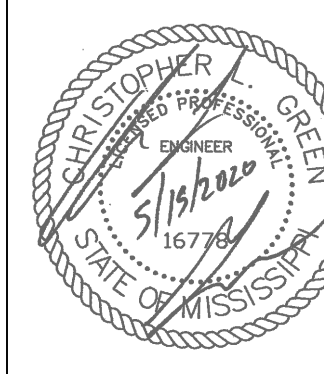


West Bolivar Consolidated School District Renovation Project

100% Construction Documents

Project No	20018
Date	2020-05-15
Drawn	FAB
Checked	CLG
Revisions	Rev Date
ADD#2	2020-06-12

McEvans Elementary School
E-108
PARTIAL LIGHTING PLAN - PART A

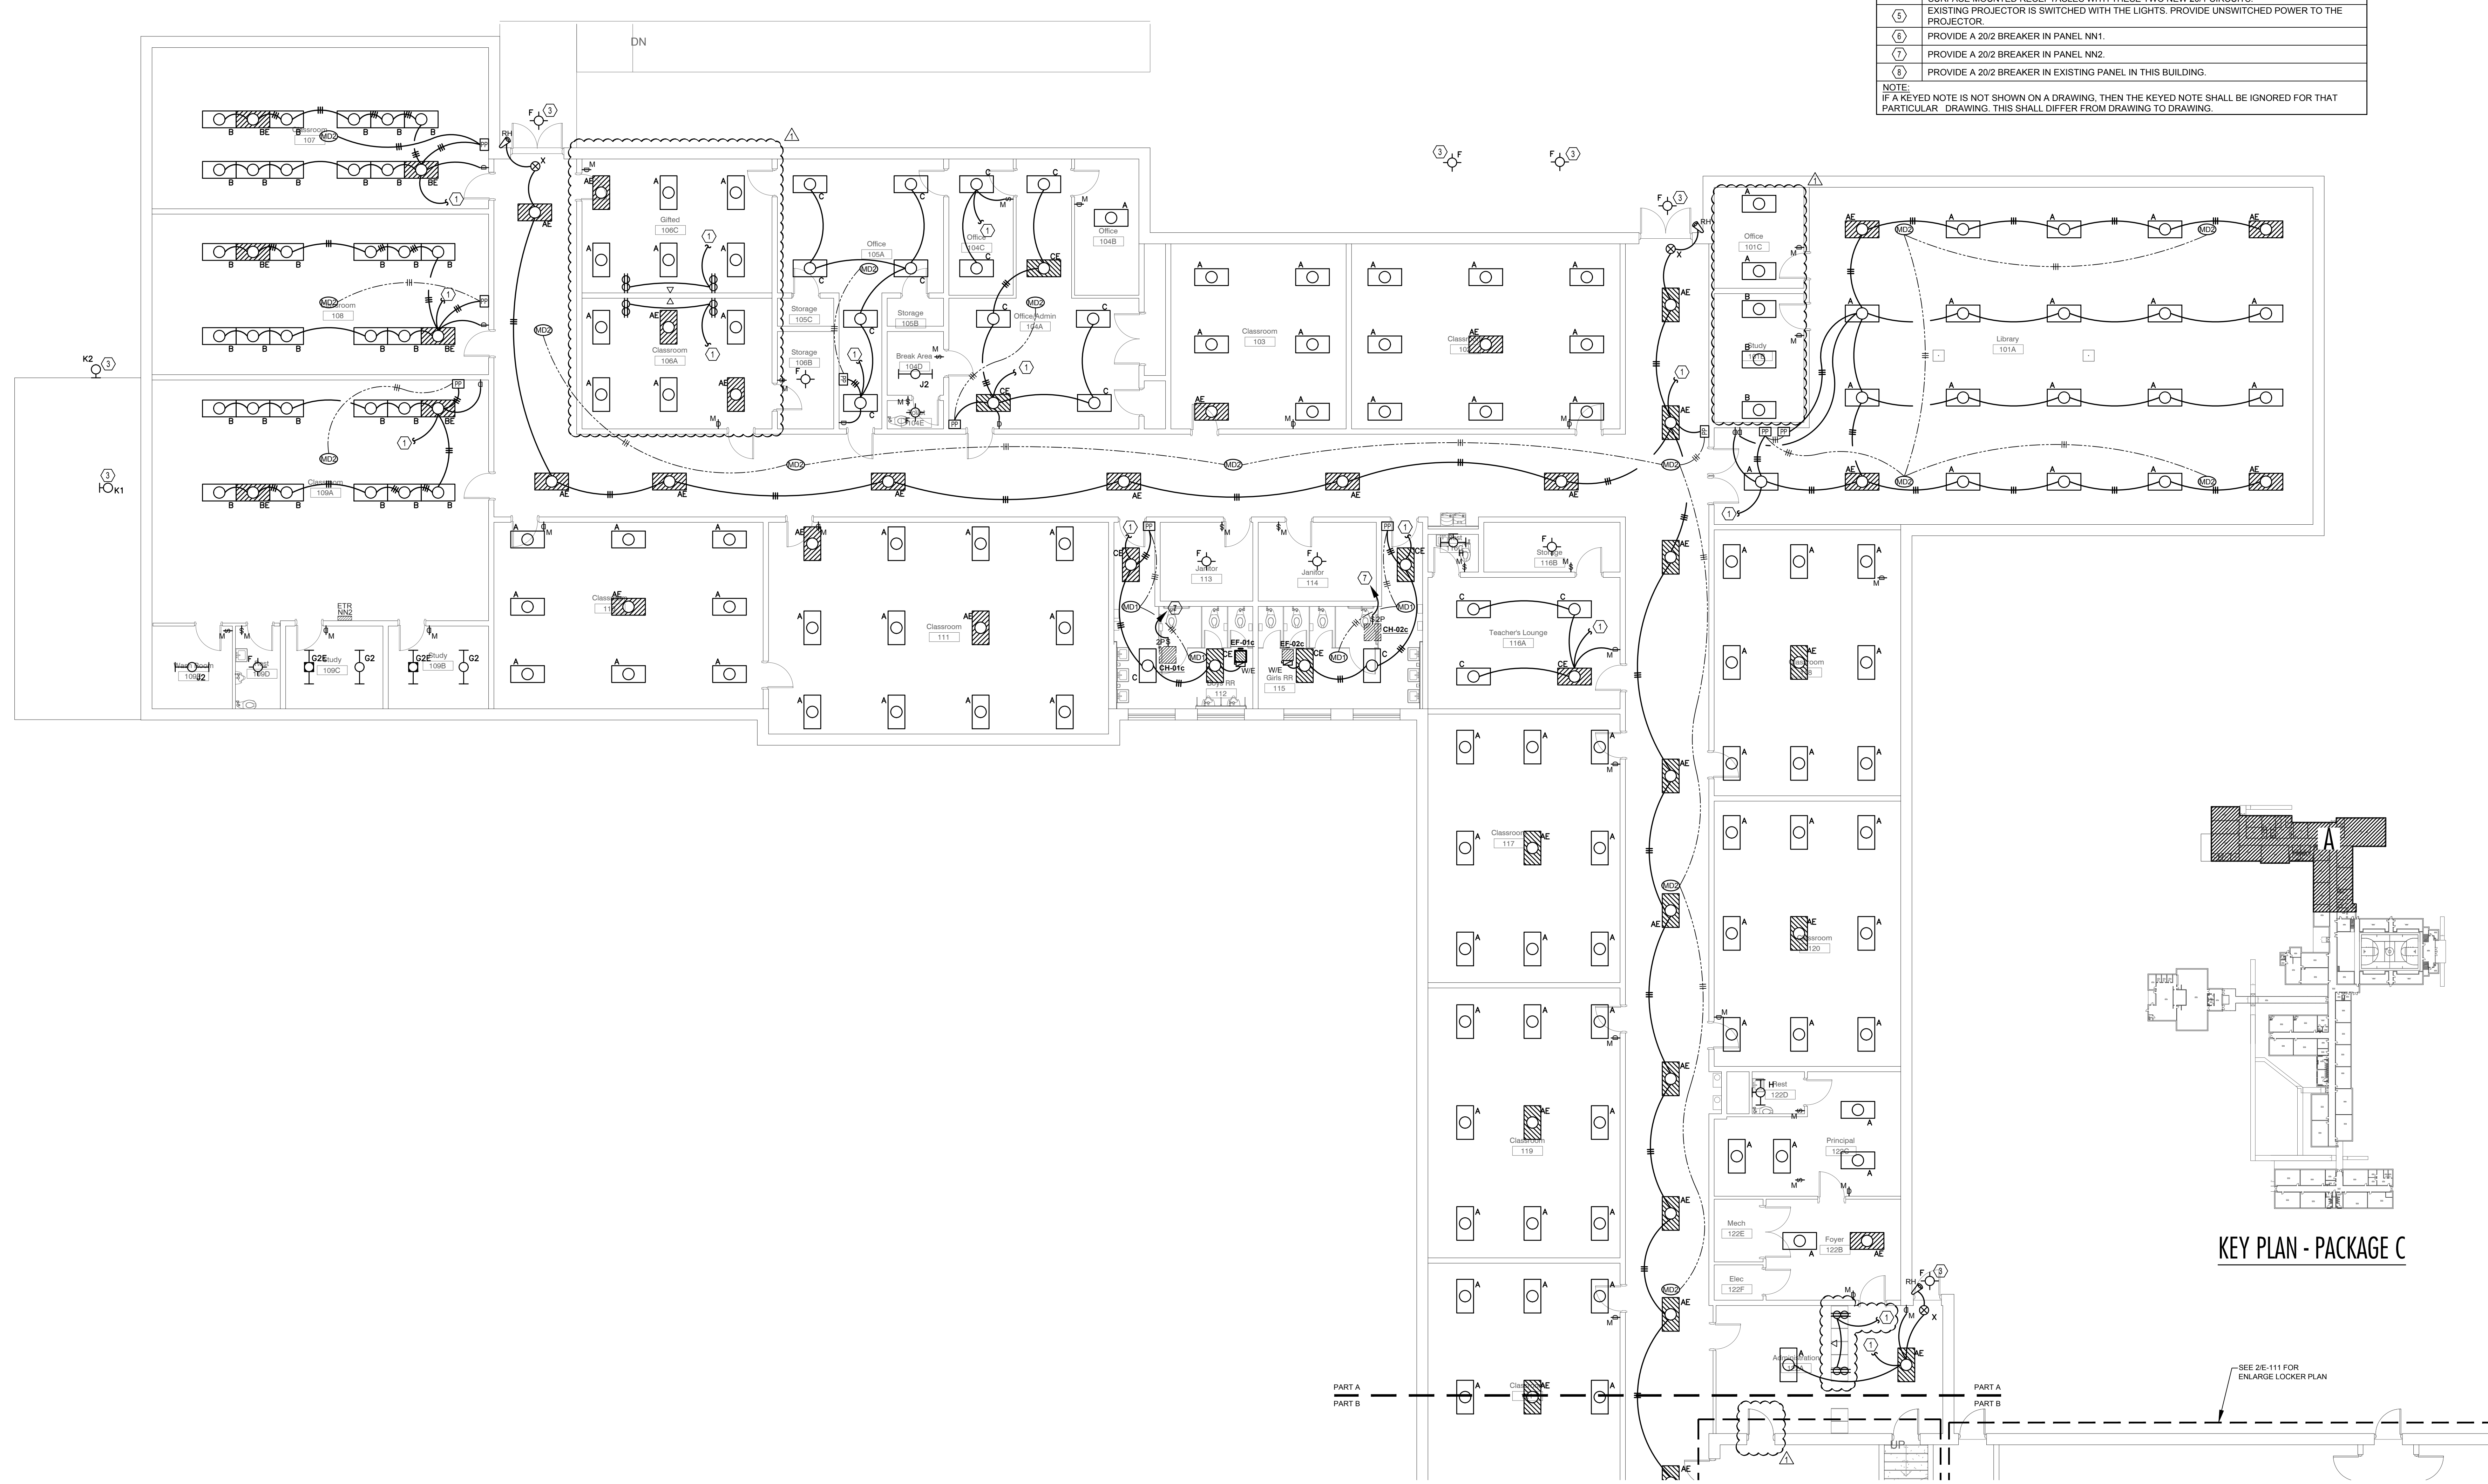

1 PARTIAL LIGHTING PLAN - MCEVANS ELEMENTARY SCHOOL - PART A
E-108 Scale: 1/8" = 1'-0"

KEY PLAN - PACKAGE C

SEE 2E-111 FOR ENLARGE LOCKER PLAN


GENERAL NOTES

Mark	Description
1.	CONNECT NEW LIGHT FIXTURES TO EXISTING LIGHT FIXTURE CIRCUITRY IN EACH ROOM UNLESS NOTED OTHERWISE ON DRAWINGS. PROVIDE UNSWITCHED POWER TO ALL EMERGENCY BATTERY PACKS.
2.	CONTRACTOR SHALL PROVIDE DIMMING CABLES FOR ALL LIGHT FIXTURES IN ROOMS THAT REQUIRE DIMMING.
3.	ALL CORRIDOR LIGHT FIXTURES SHALL BE CONTROLLED WITH OCCUPANCY SENSORS (AUTOMATIC ON / OFF). CONTRACTOR SHALL DEMOLISH EXISTING SINGLE POLE SWITCH SERVING EACH CORRIDOR. EXISTING SINGLE POLE SWITCH SERVING EXTERIOR LIGHTS SHALL BE EXISTING TO REMAIN. PROVIDE A STAINLESS STEEL TWO GANG COVER PLATE WITH A BLANK FOR THE DEMOLISHED SWITCH.
4.	REPLACE ALL EXISTING EXIT SIGNS WITH NEW FIXTURE "X". SEE LIGHTING FIXTURE SCHEDULE ON SHEET E-300.

MASTER KEYED NOTES - LIGHTING

Mark	Description
①	CONNECT TO EXISTING CIRCUITRY IN THIS AREA.
②	FIXTURES MOUNTED ABOVE BLEACHERS.
③	CONNECT TO EXISTING EXTERIOR LIGHTING CIRCUIT AND SWITCHING.
④	EXISTING COMPUTER LAB. PROVIDE TWO 20'1 BREAKERS IN PANEL NN1. RE-CIRCUIT EXISTING SURFACE MOUNTED RECEPTACLES WITH THESE TWO NEW 20'1 CIRCUITS.
⑤	EXISTING PROJECTOR IS SWITCHED WITH THE LIGHTS. PROVIDE UNSWITCHED POWER TO THE PROJECTOR.
⑥	PROVIDE A 20'2 BREAKER IN PANEL NN1.
⑦	PROVIDE A 20'2 BREAKER IN PANEL NN2.
⑧	PROVIDE A 20'2 BREAKER IN EXISTING PANEL IN THIS BUILDING.


NOTE:
IF A KEYED NOTE IS NOT SHOWN ON A DRAWING, THEN THE KEYED NOTE SHALL BE IGNORED FOR THAT PARTICULAR DRAWING. THIS SHALL DIFFER FROM DRAWING TO DRAWING.

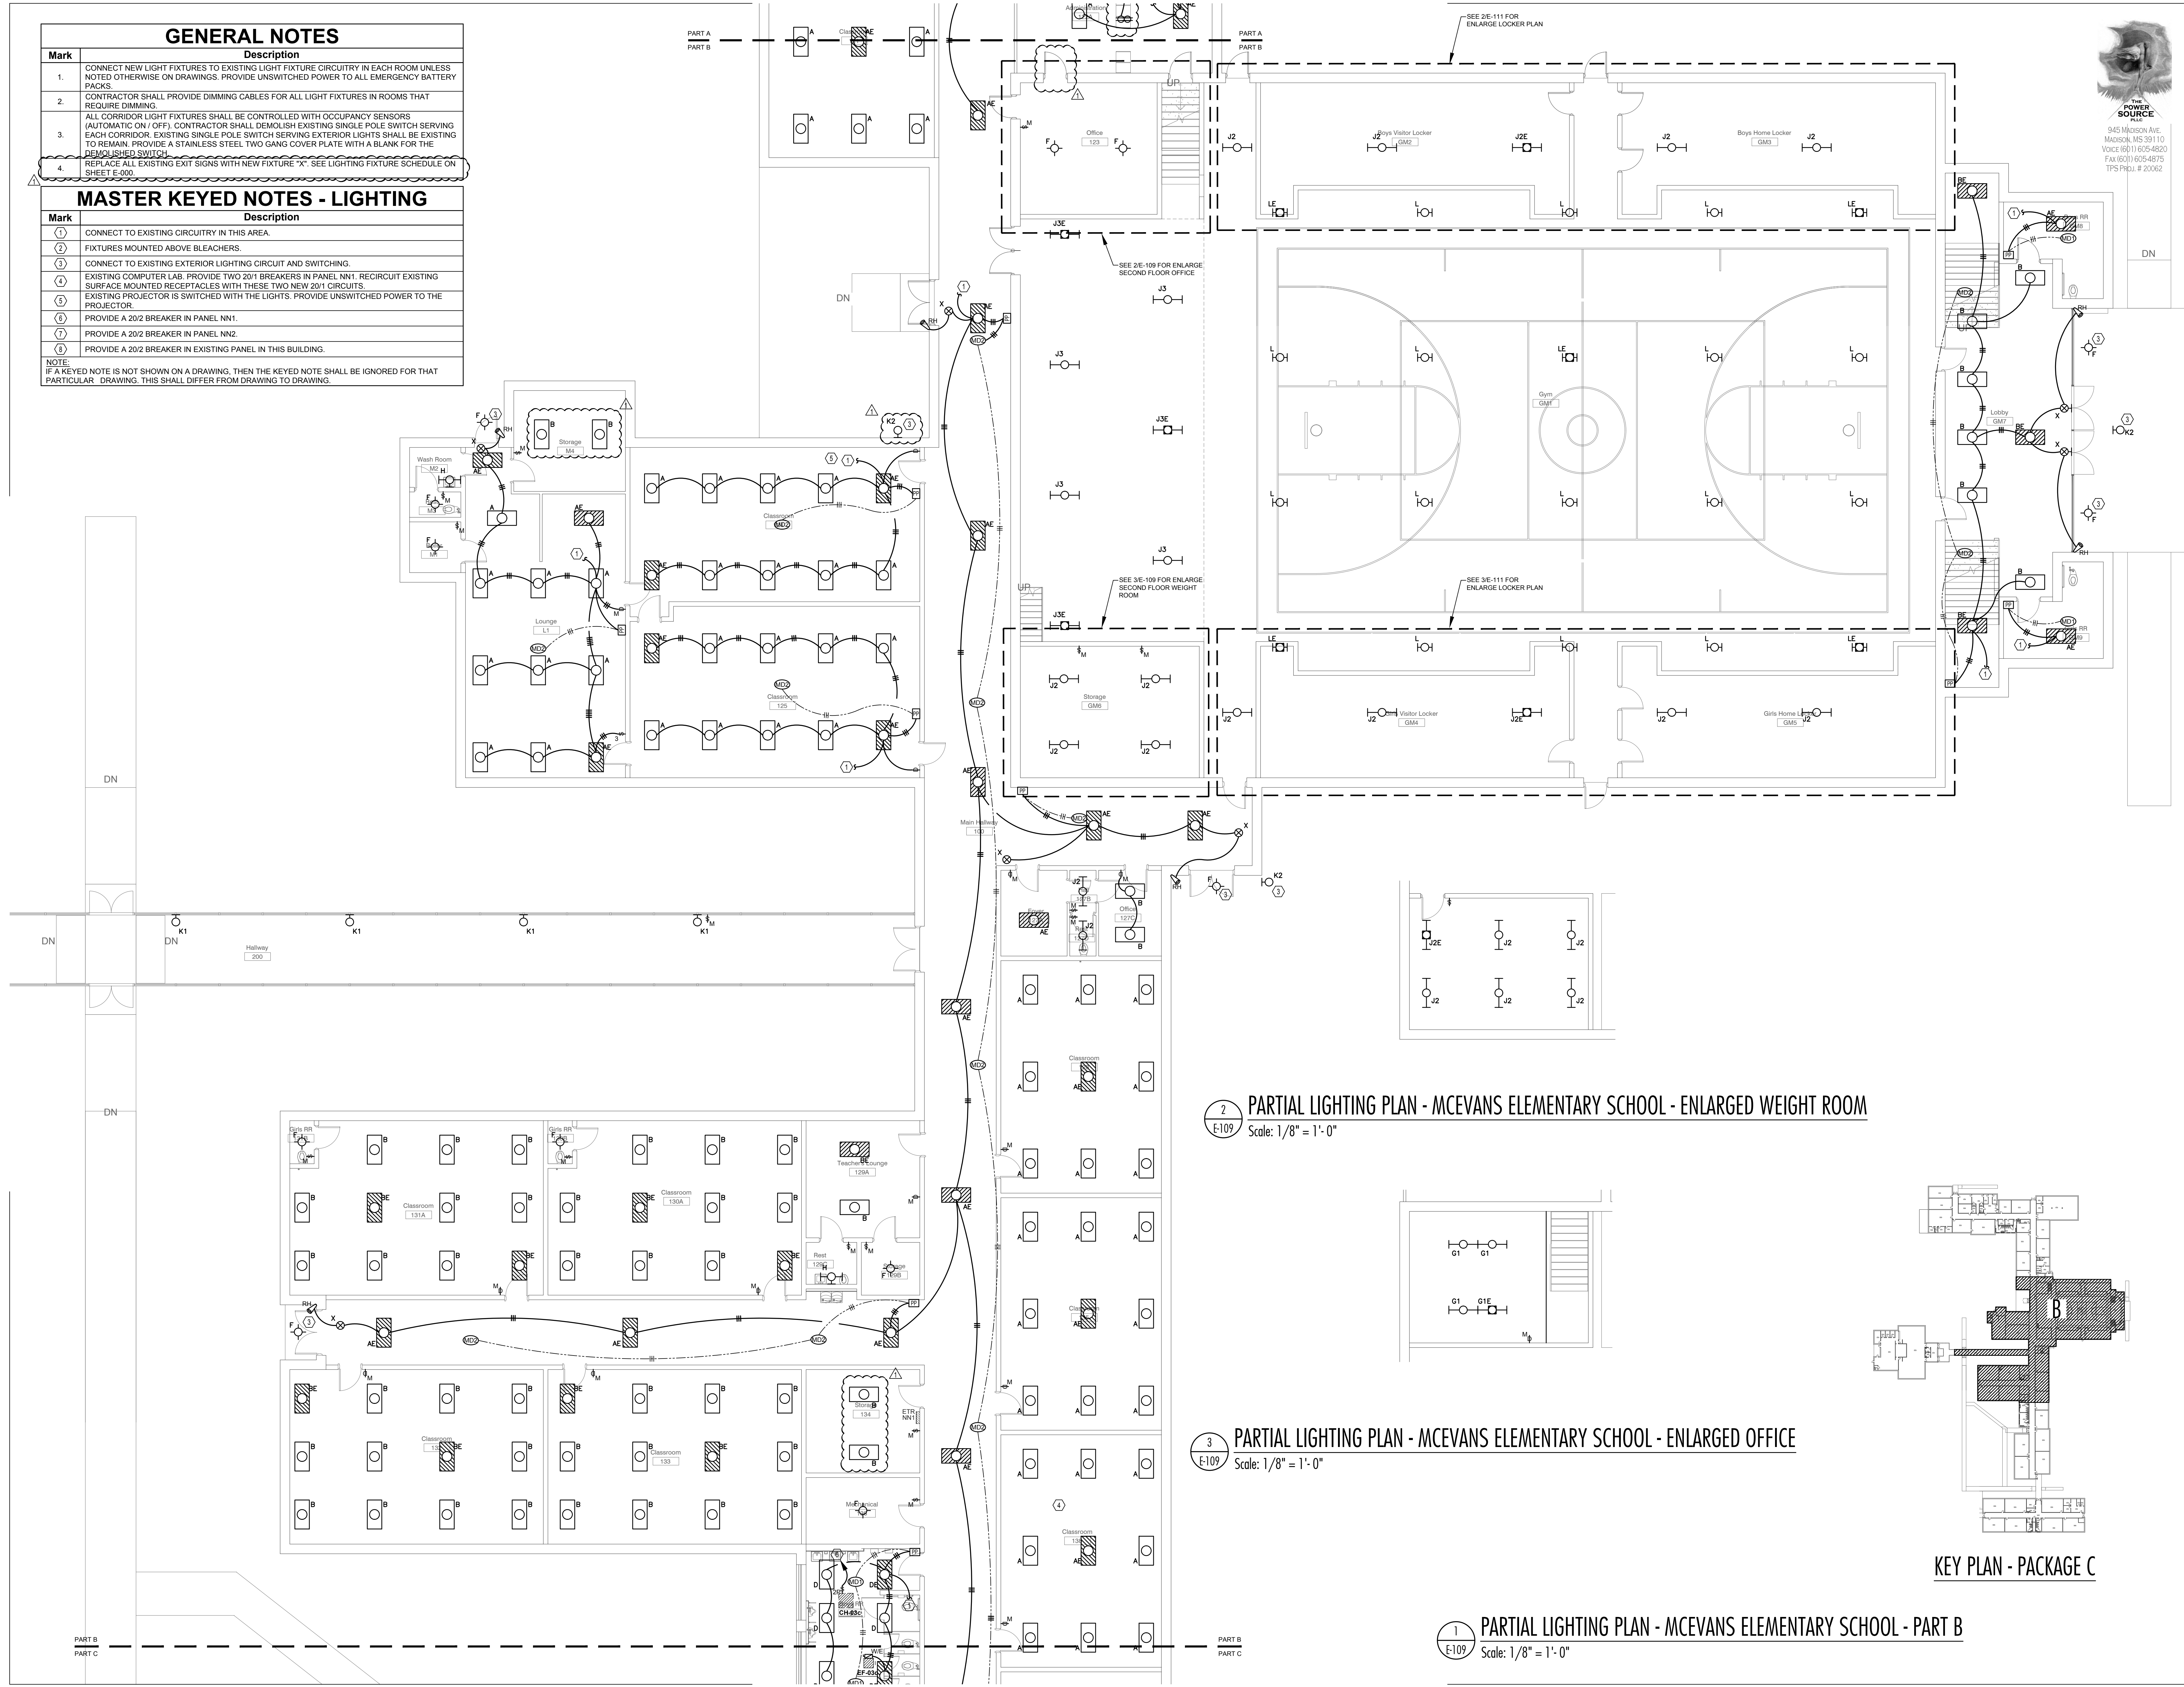

② PARTIAL LIGHTING PLAN - MCEVANS ELEMENTARY SCHOOL - ENLARGED WEIGHT ROOM
Scale: 1/8" = 1'-0"

③ PARTIAL LIGHTING PLAN - MCEVANS ELEMENTARY SCHOOL - ENLARGED OFFICE
Scale: 1/8" = 1'-0"

① PARTIAL LIGHTING PLAN - MCEVANS ELEMENTARY SCHOOL - PART B
Scale: 1/8" = 1'-0"

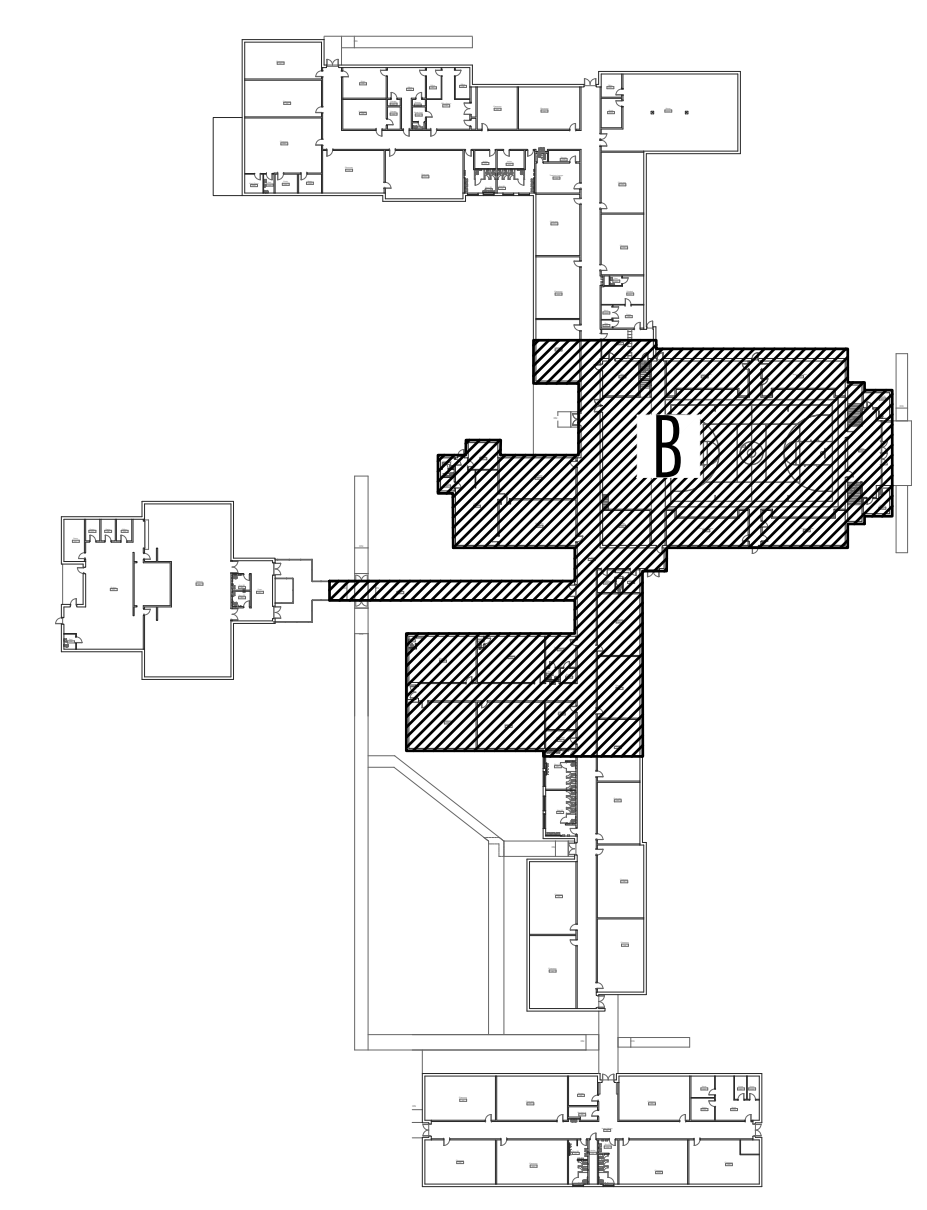


KEY PLAN - PACKAGE C



AN ASSOCIATION
DALE BAILEY
JACKSON • BILOXI
MISSISSIPPI

DALE BAILEY
JACKSON • BILOXI
MISSISSIPPI

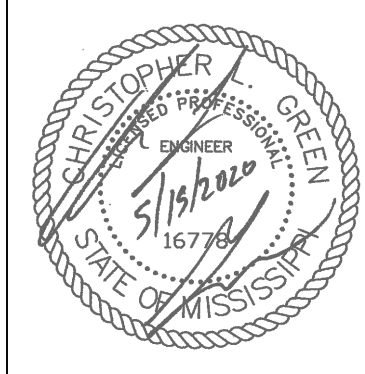

West Bolivar Consolidated School
District Renovation Project

100%
Construction
Documents

Project No	20018
Date	2020-05-15
Drawn	FAB
Checked	CLG
Revisions	Rev Date
▲ ADD#2	2020-06-12

McEvans Elementary School
E-109
PARTIAL LIGHTING
PLAN - PART B


PART B
PART C

PART B
PART C


GENERAL NOTES	
Mark	Description
1.	CONNECT NEW LIGHT FIXTURES TO EXISTING LIGHT FIXTURE CIRCUITRY IN EACH ROOM UNLESS NOTED OTHERWISE ON DRAWINGS. PROVIDE UNSWITCHED POWER TO ALL EMERGENCY BATTERY PACKS.
2.	CONTRACTOR SHALL PROVIDE DIMMING CABLES FOR ALL LIGHT FIXTURES IN ROOMS THAT REQUIRE DIMMING.
3.	ALL CORRIDOR LIGHT FIXTURES SHALL BE CONTROLLED WITH OCCUPANCY SENSORS (AUTOMATIC ON / OFF). CONTRACTOR SHALL DEMOLISH EXISTING SINGLE POLE SWITCH SERVING EACH CORRIDOR. EXISTING SINGLE POLE SWITCH SERVING EXTERIOR LIGHTS SHALL BE EXISTING TO REMAIN. PROVIDE A STAINLESS STEEL TWO GANG COVER PLATE WITH A BLANK FOR THE DEMOLISHED SWITCH.
4.	REPLACE ALL EXISTING EXIT SIGNS WITH NEW FIXTURE "X". SEE LIGHTING FIXTURE SCHEDULE ON SHEET E-000.

MASTER KEYED NOTES - LIGHTING	
Mark	Description
(1)	CONNECT TO EXISTING CIRCUITRY IN THIS AREA.
(2)	FIXTURES MOUNTED ABOVE BLEACHERS.
(3)	CONNECT TO EXISTING EXTERIOR LIGHTING CIRCUIT AND SWITCHING.
(4)	EXISTING COMPUTER LAB. PROVIDE TWO 201 BREAKERS IN PANEL NN1. RECIRCUIT EXISTING SURFACE MOUNTED RECEPTACLES WITH THESE TWO NEW 201 CIRCUITS.
(5)	EXISTING PROJECTOR IS SWITCHED WITH THE LIGHTS. PROVIDE UNSWITCHED POWER TO THE PROJECTOR.
(6)	PROVIDE A 20/2 BREAKER IN PANEL NN1.
(7)	PROVIDE A 20/2 BREAKER IN PANEL NN2.
(8)	PROVIDE A 20/2 BREAKER IN EXISTING PANEL IN THIS BUILDING.

NOTE:
IF A KEYED NOTE IS NOT SHOWN ON A DRAWING, THEN THE KEYED NOTE SHALL BE IGNORED FOR THAT PARTICULAR DRAWING. THIS SHALL DIFFER FROM DRAWING TO DRAWING.

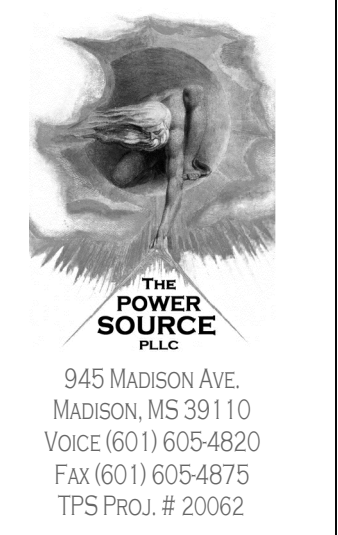

AN ASSOCIATION
DALE BAILEY
JACKSON • BILOXI
MISSISSIPPI

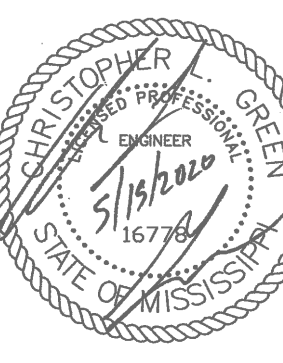



West Bolivar Consolidated School
District Renovation Project

100%
Construction
Documents

Project No	20018
Date	2020-05-15
Drawn	FAB
Checked	CLG
Revisions	Rev Date
ADD#2	2020-06-12

McEvans Elementary School

E-110
PARTIAL LIGHTING
PLAN - PART C

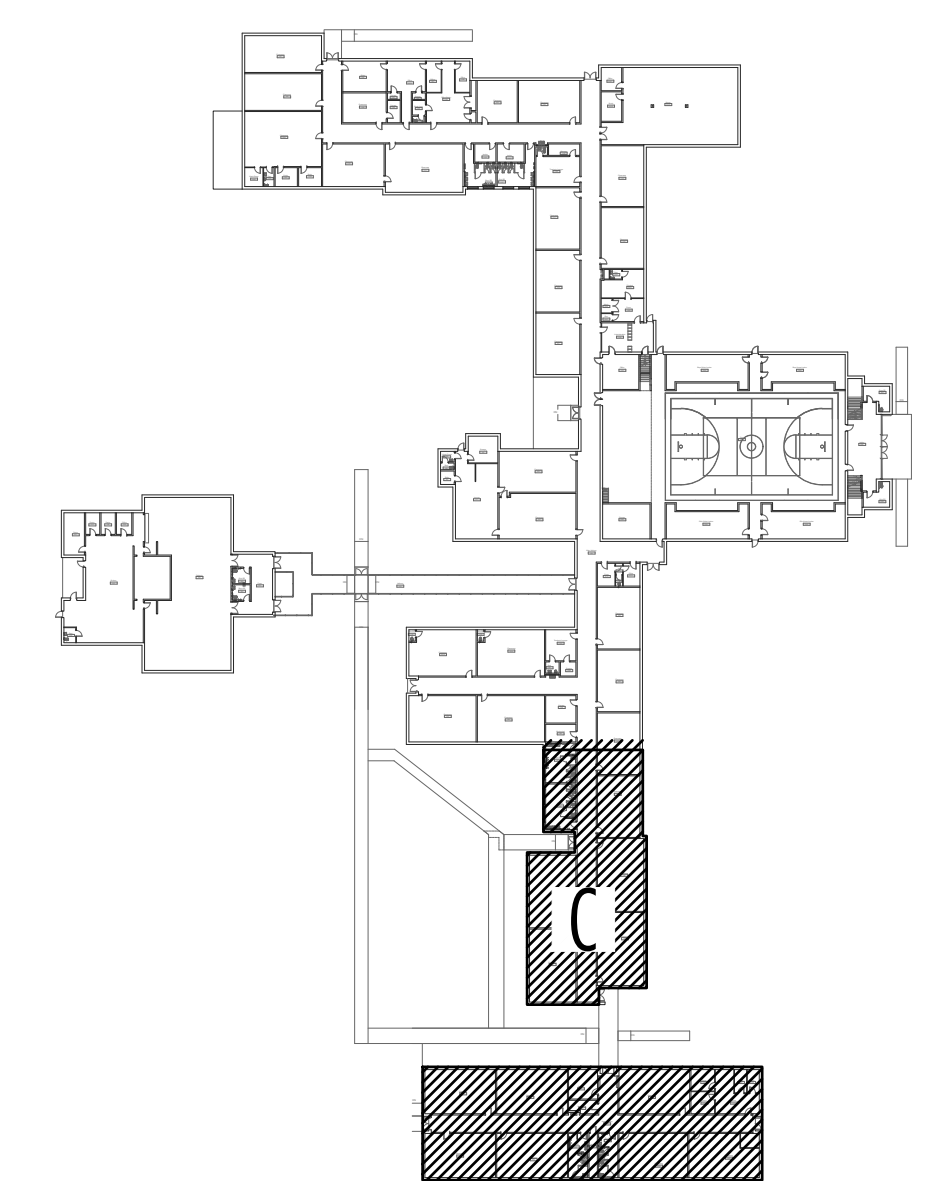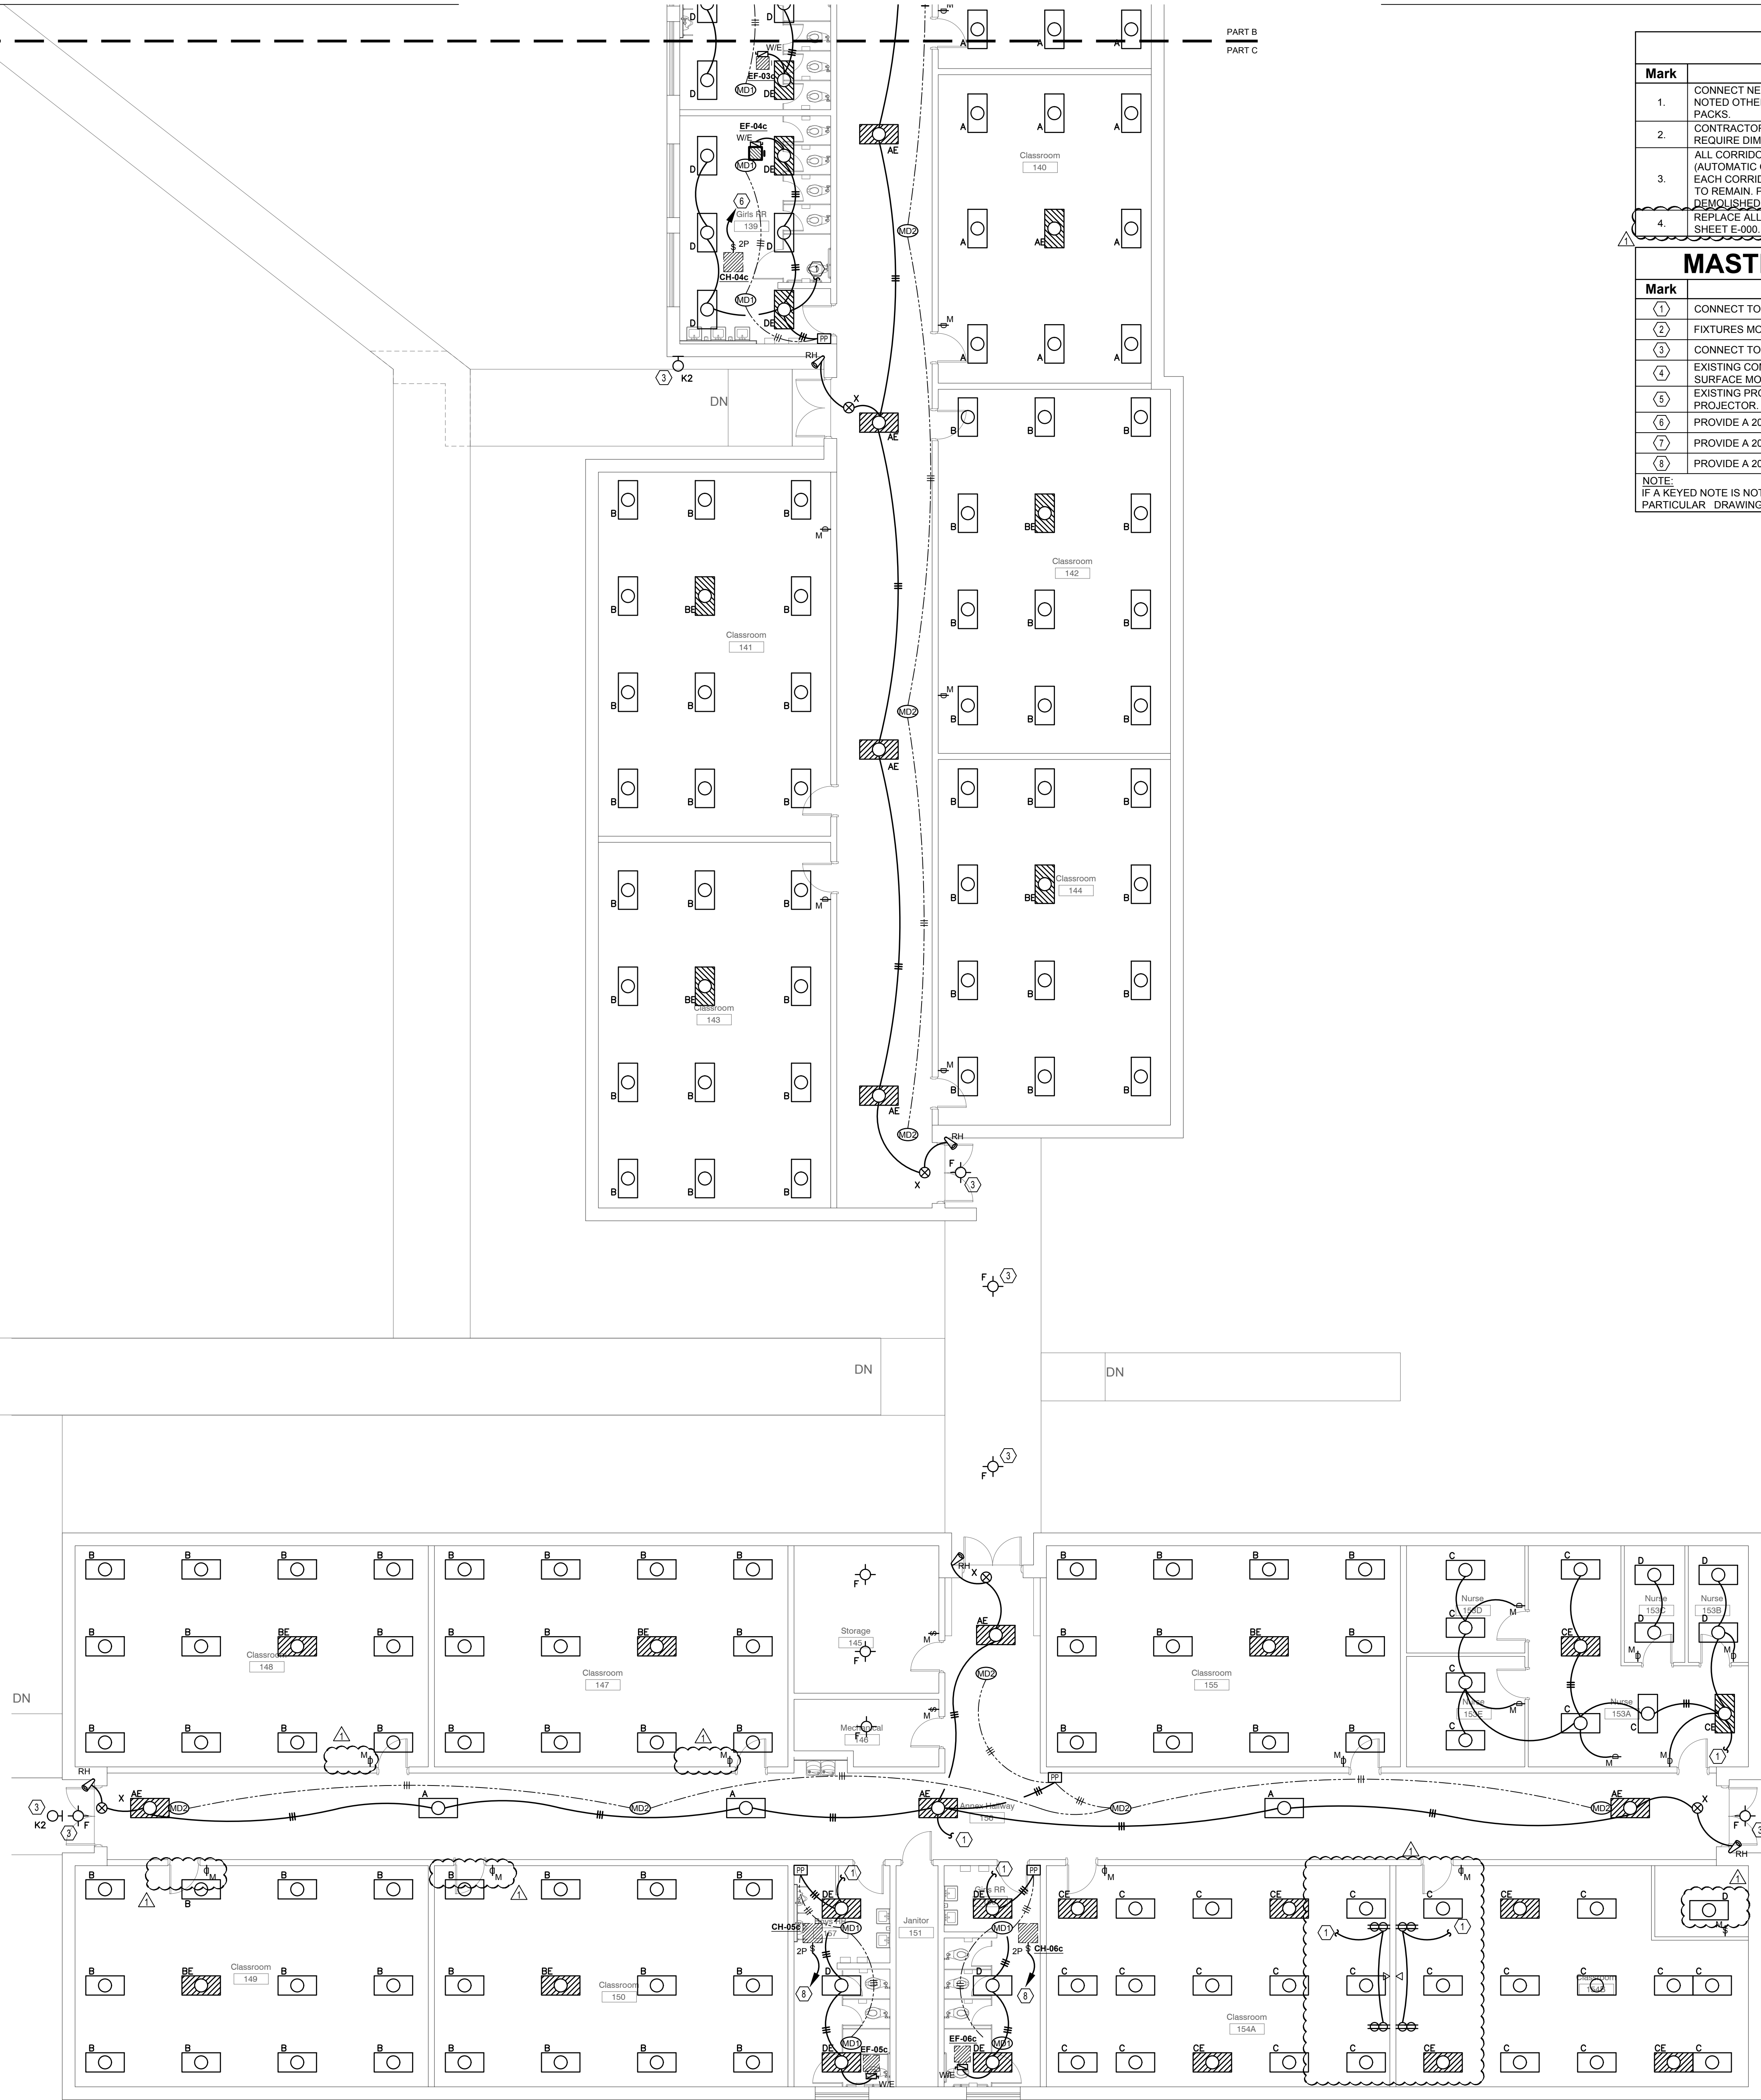

KEY PLAN - PACKAGE C

PARTIAL LIGHTING PLAN
MCEVANS ELEMENTARY SCHOOL - PART C
Scale: 1/8" = 1'-0"